MINE MAP

Showing the location and extent of development of the Bush Coal Company slope mine. Situate on the No. dip Skidmore Vein, Porter Township, Schuylkill County, Pa.

A.B. Riedel, P.E.

Aug. 15, 1984
Scale 1"= 100'

VENTILATION SYMBOLS
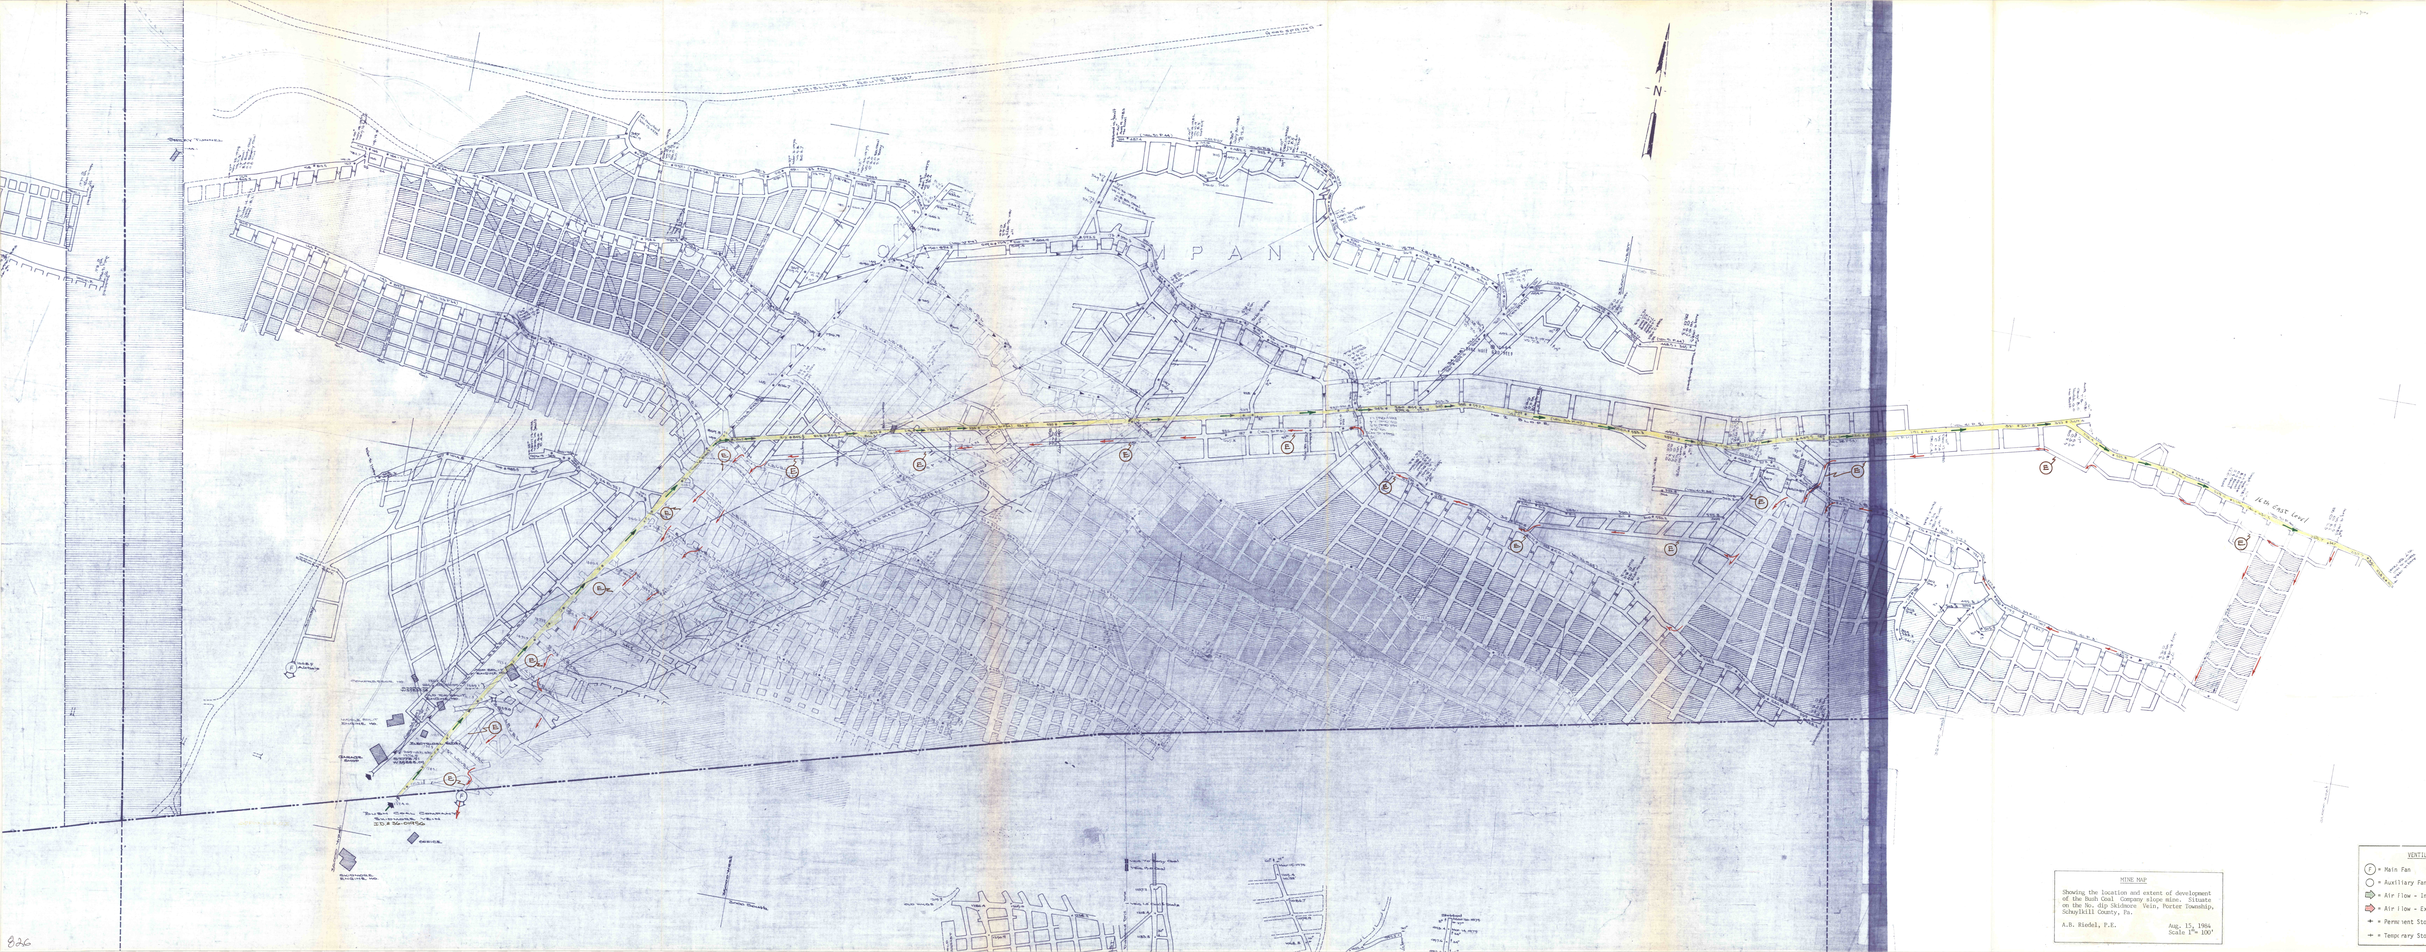
| | |
|---|---|
| (F) = Main Fan | ⊠ = Air Bridge |
| ○ = Auxiliary Fan | R = Regulator |
| ⇨ = Air Flow - Intake | = Man Door |
| ⇨ = Air Flow - Exhaust | V = Velocity, fpm |
| + = Permanent Stopping | Q = Quantity, cfm |
| + = Temporary Stopping | WG = Water Gauge |