


# W I L L I A M S H A I N E R T R A C T

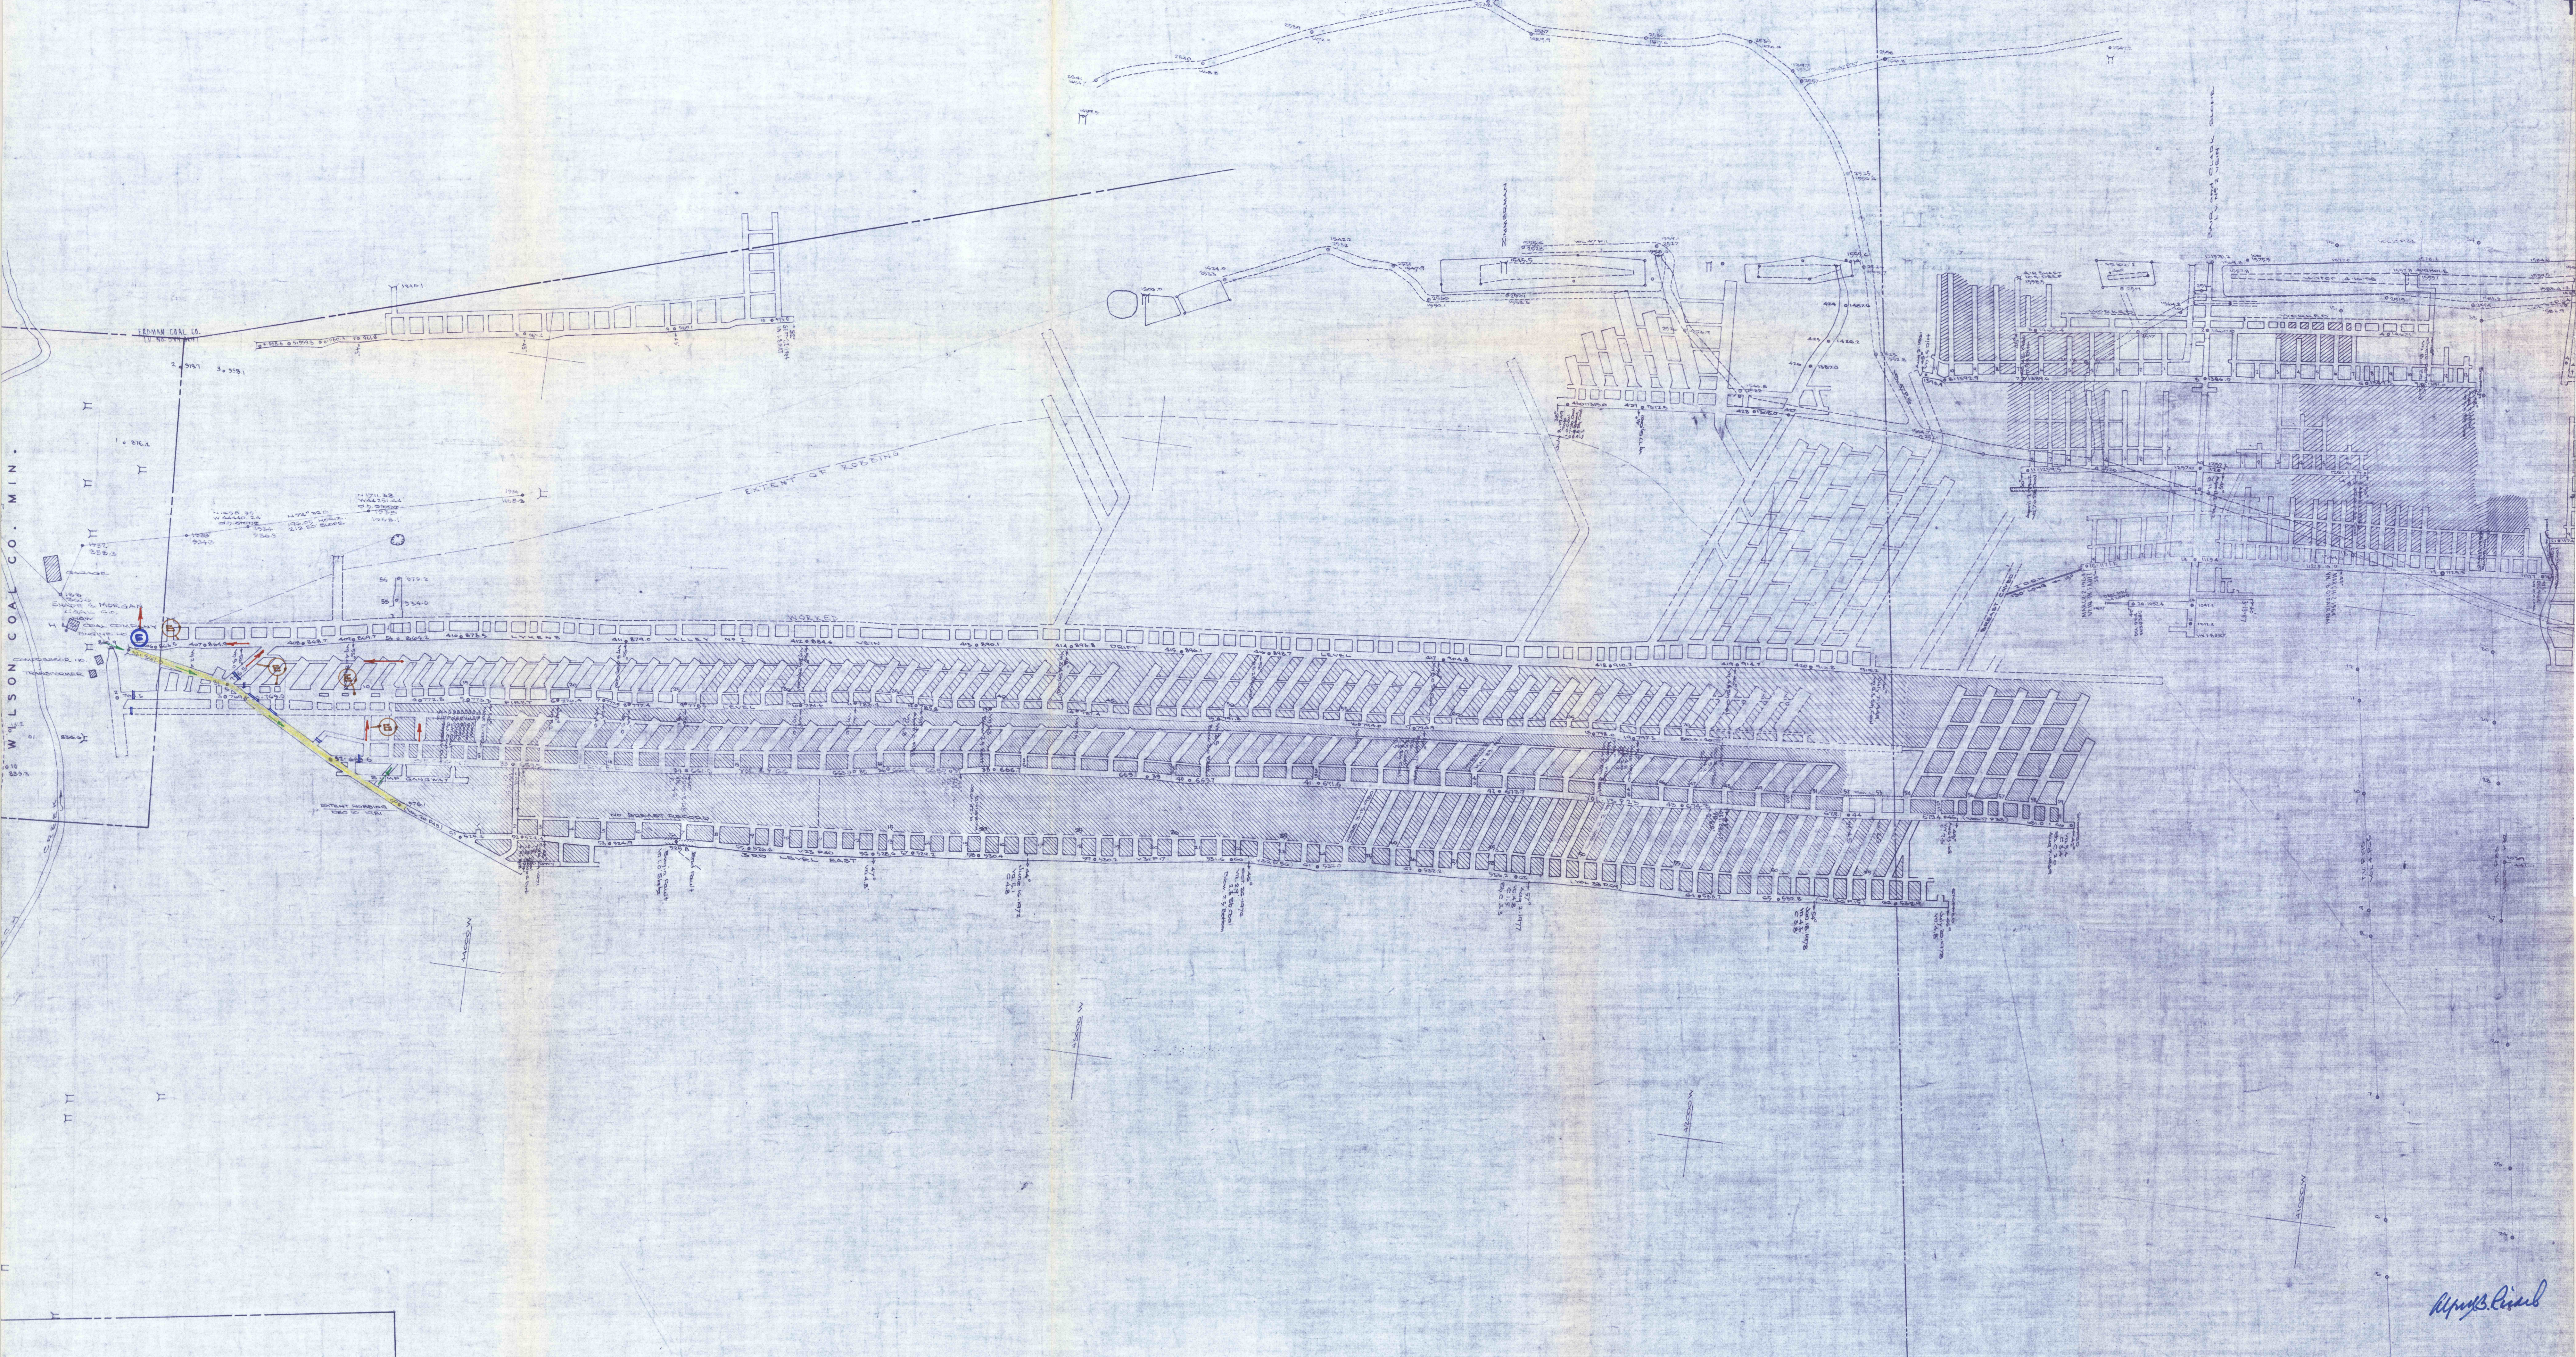

WILSON COAL CO. MIN.

ENTENT OF ROBBING

*A. B. Riedel*

MINE MAP  
Showing the location and extent of development  
(as provided by operator) of the H & S Coal Co.  
slope mine. Situate on the So. dip L.V. #2 Vein,  
Hegins Twp., Schuylkill County, Pa.  
A. B. Riedel, P. E. Dec. 10, 1981  
36-0199 Scale 1" = 100'

CE & MINERAL