

12,000 NORTH

11,000 NORTH


10,000 NORTH

2,000 EAST


N

LEGEND

INTAKE AIR
RETURN AIR
ESCAPE WAY
PROPOSED WORK
STOPPINGS

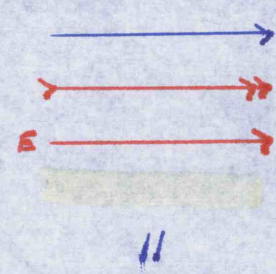

11

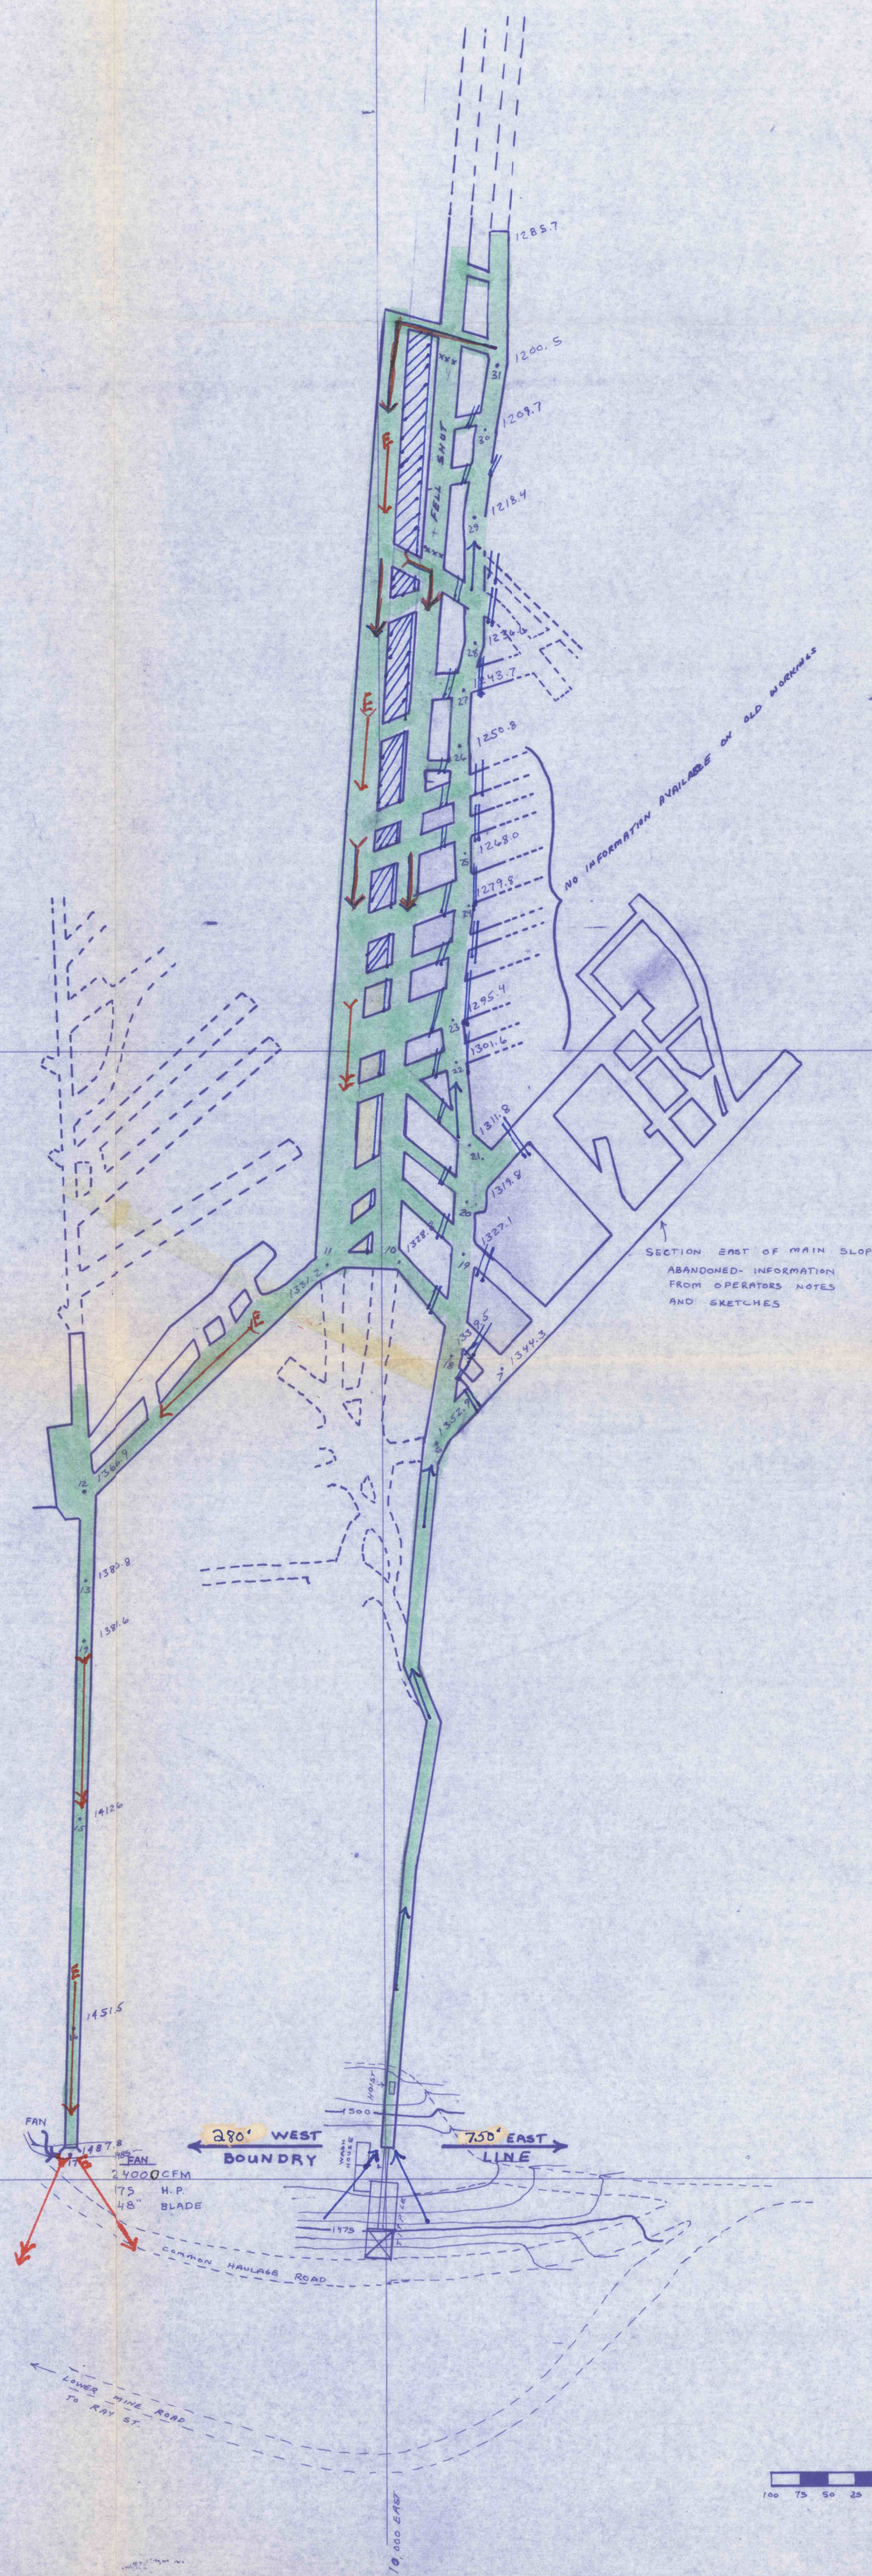

MAPLE LEAF MINING INC.
LITTLE VEIN SLOPE
SCHUYLKILL CO. PENNSYLVANIA

OWNER ID- 36-02000

TERENCE SHEEHAN

SCALE: 1 in. = 100 ft. DATE: OCT. 14, 1985



I, the undersigned, hereby certify that this map is correct and shows all the information, to the best of my knowledge and belief, required by the mining laws of this state, and covers the period ending Oct. 14, 1985.

Signed: Michael A. Benza

