
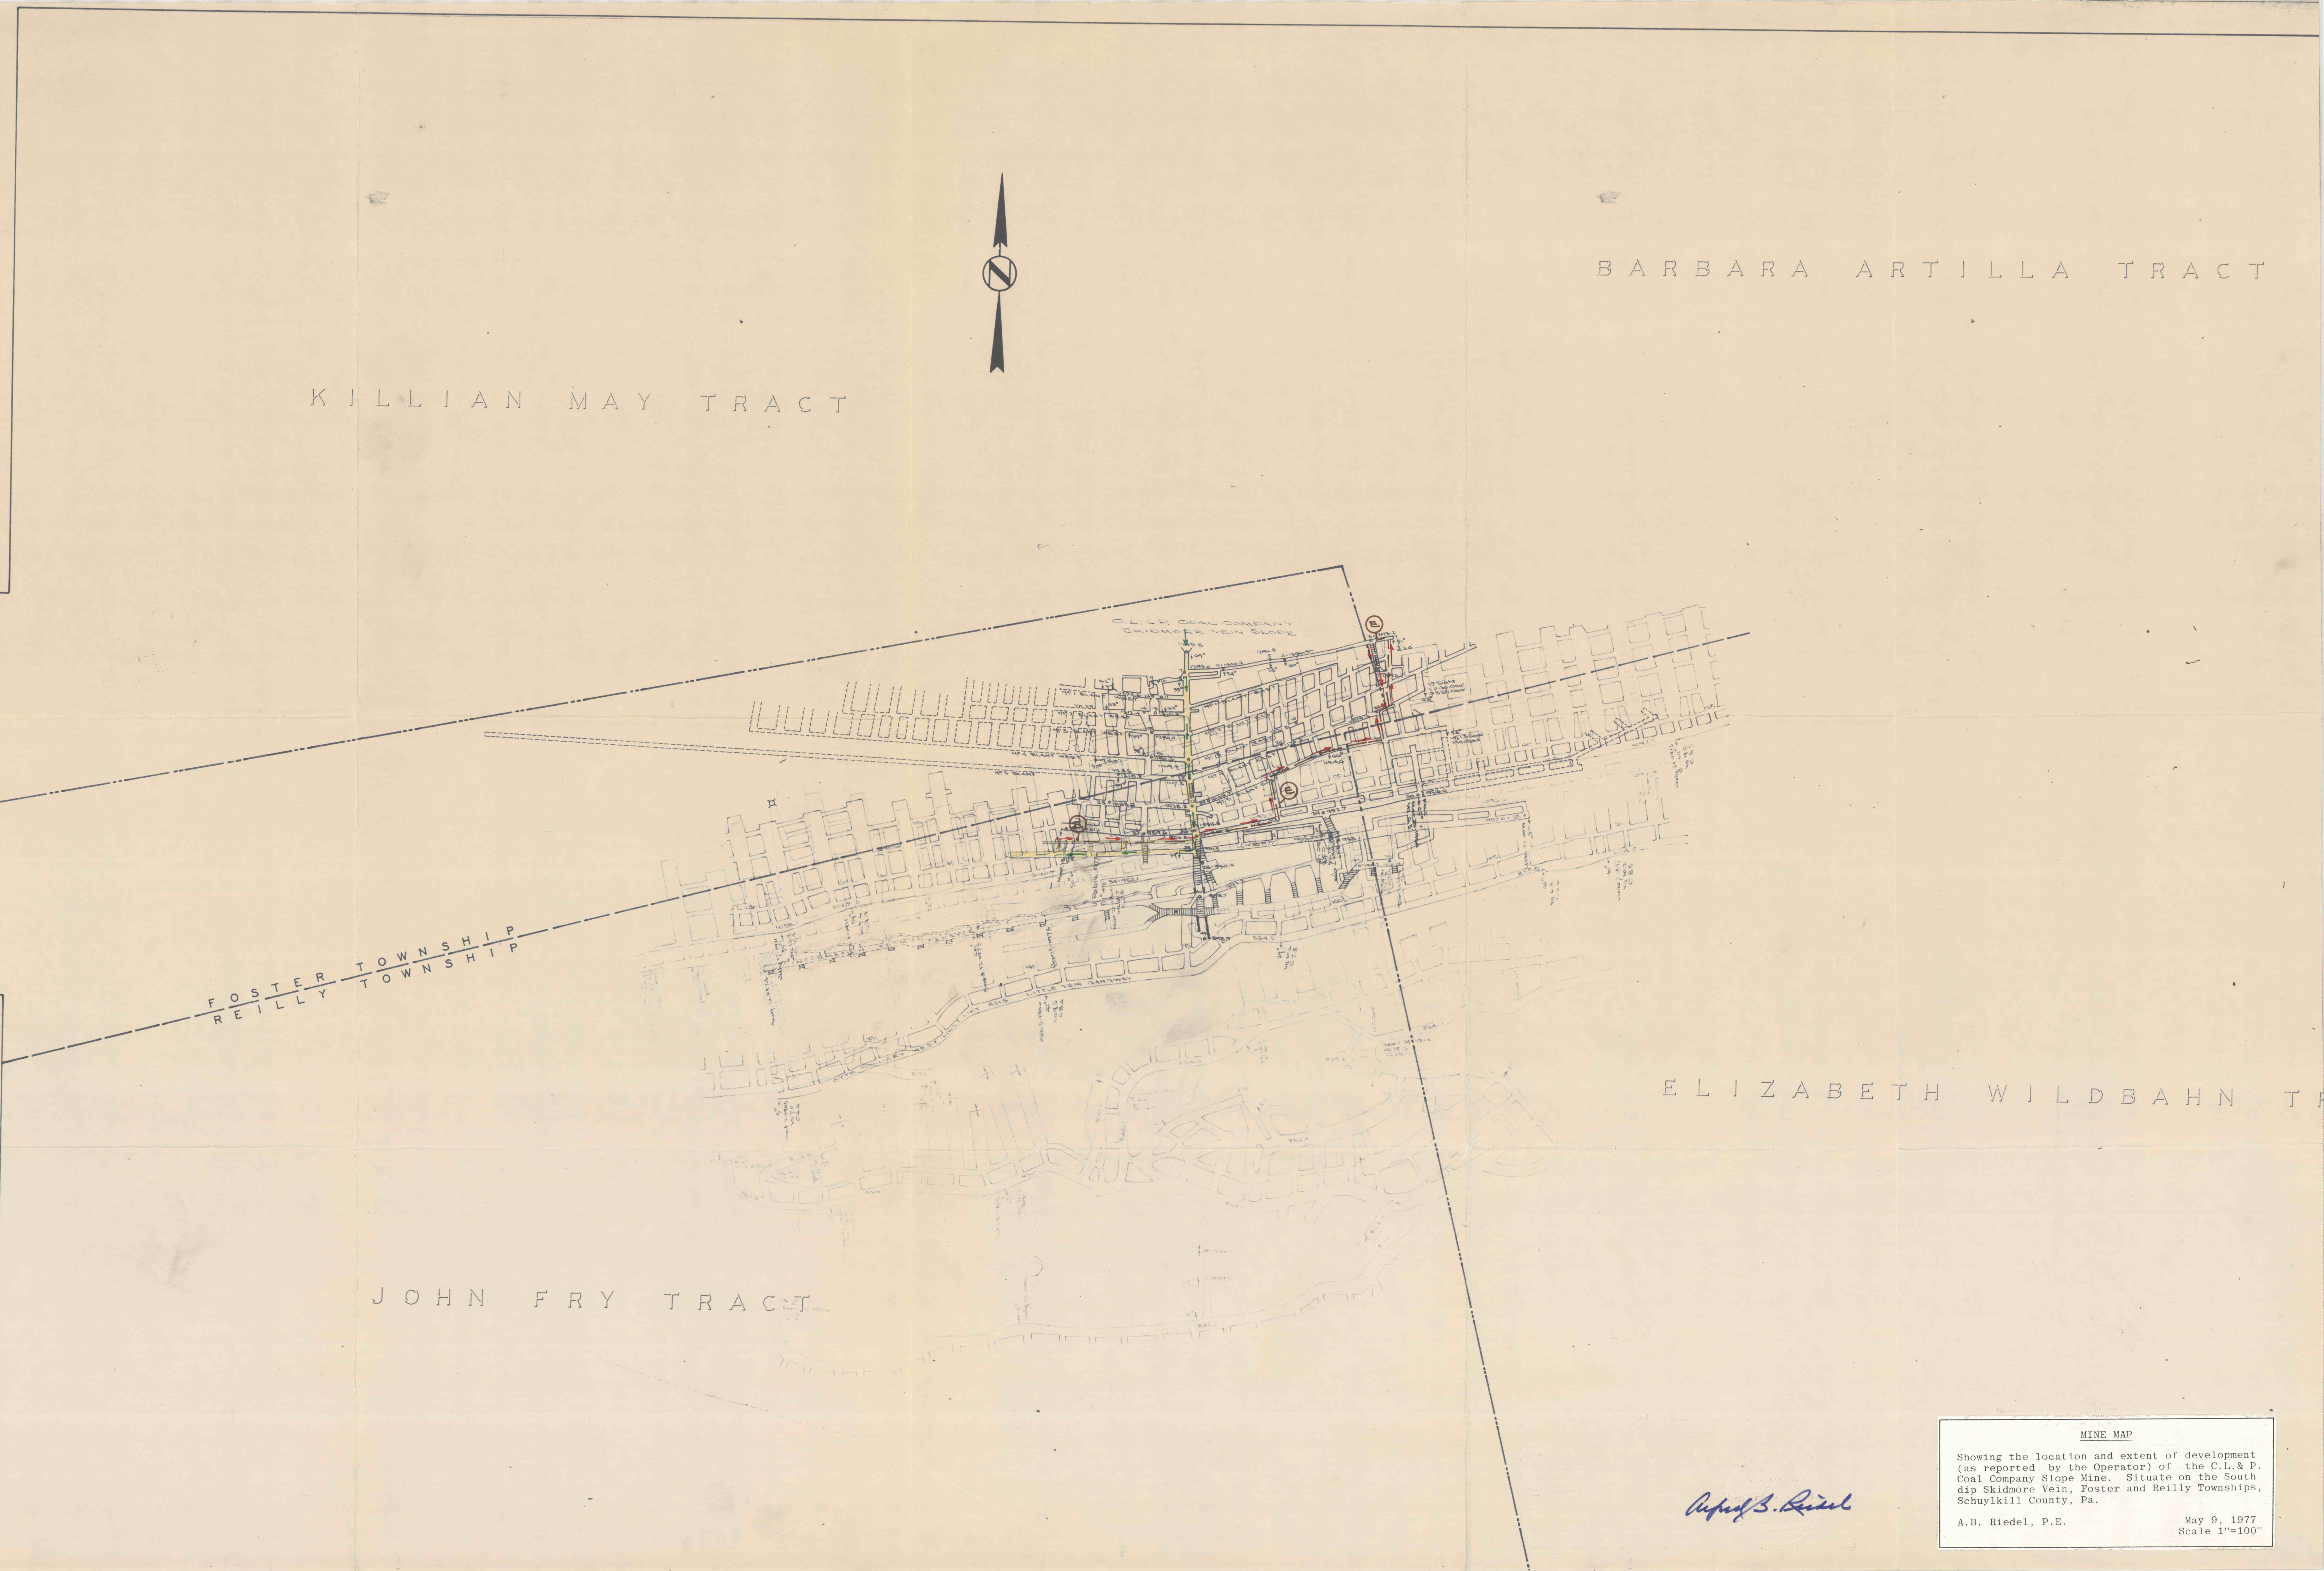
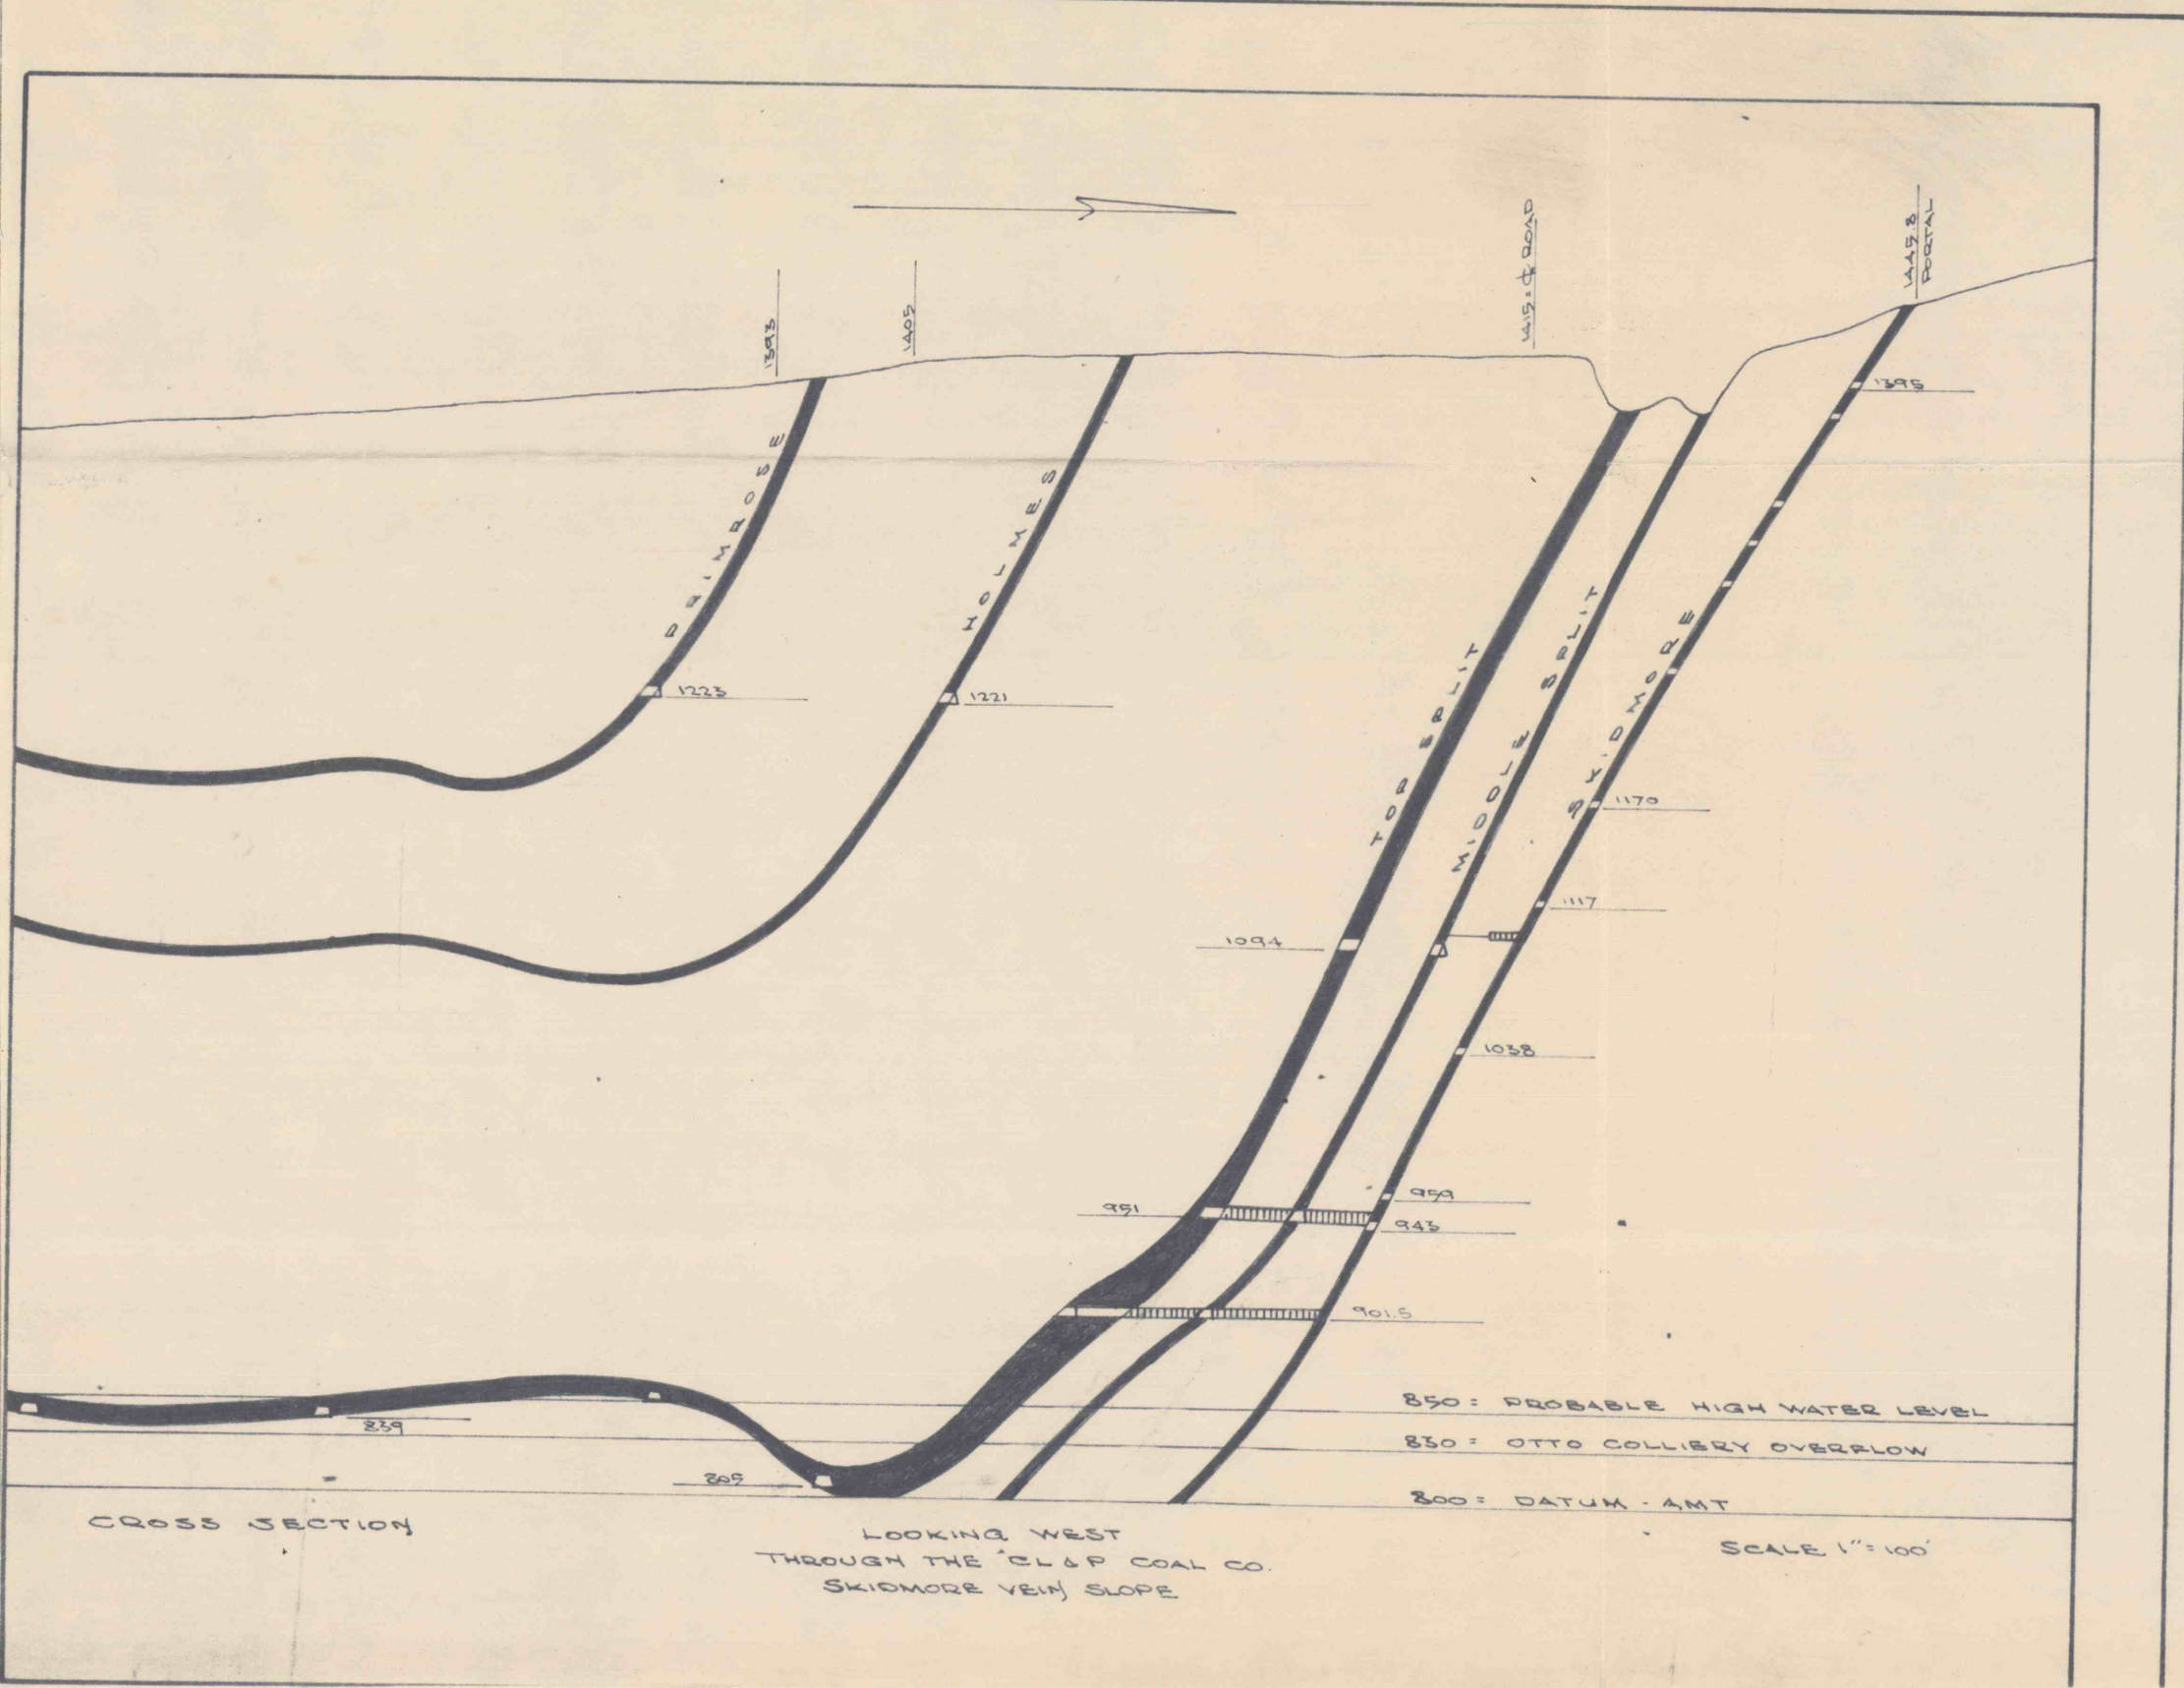


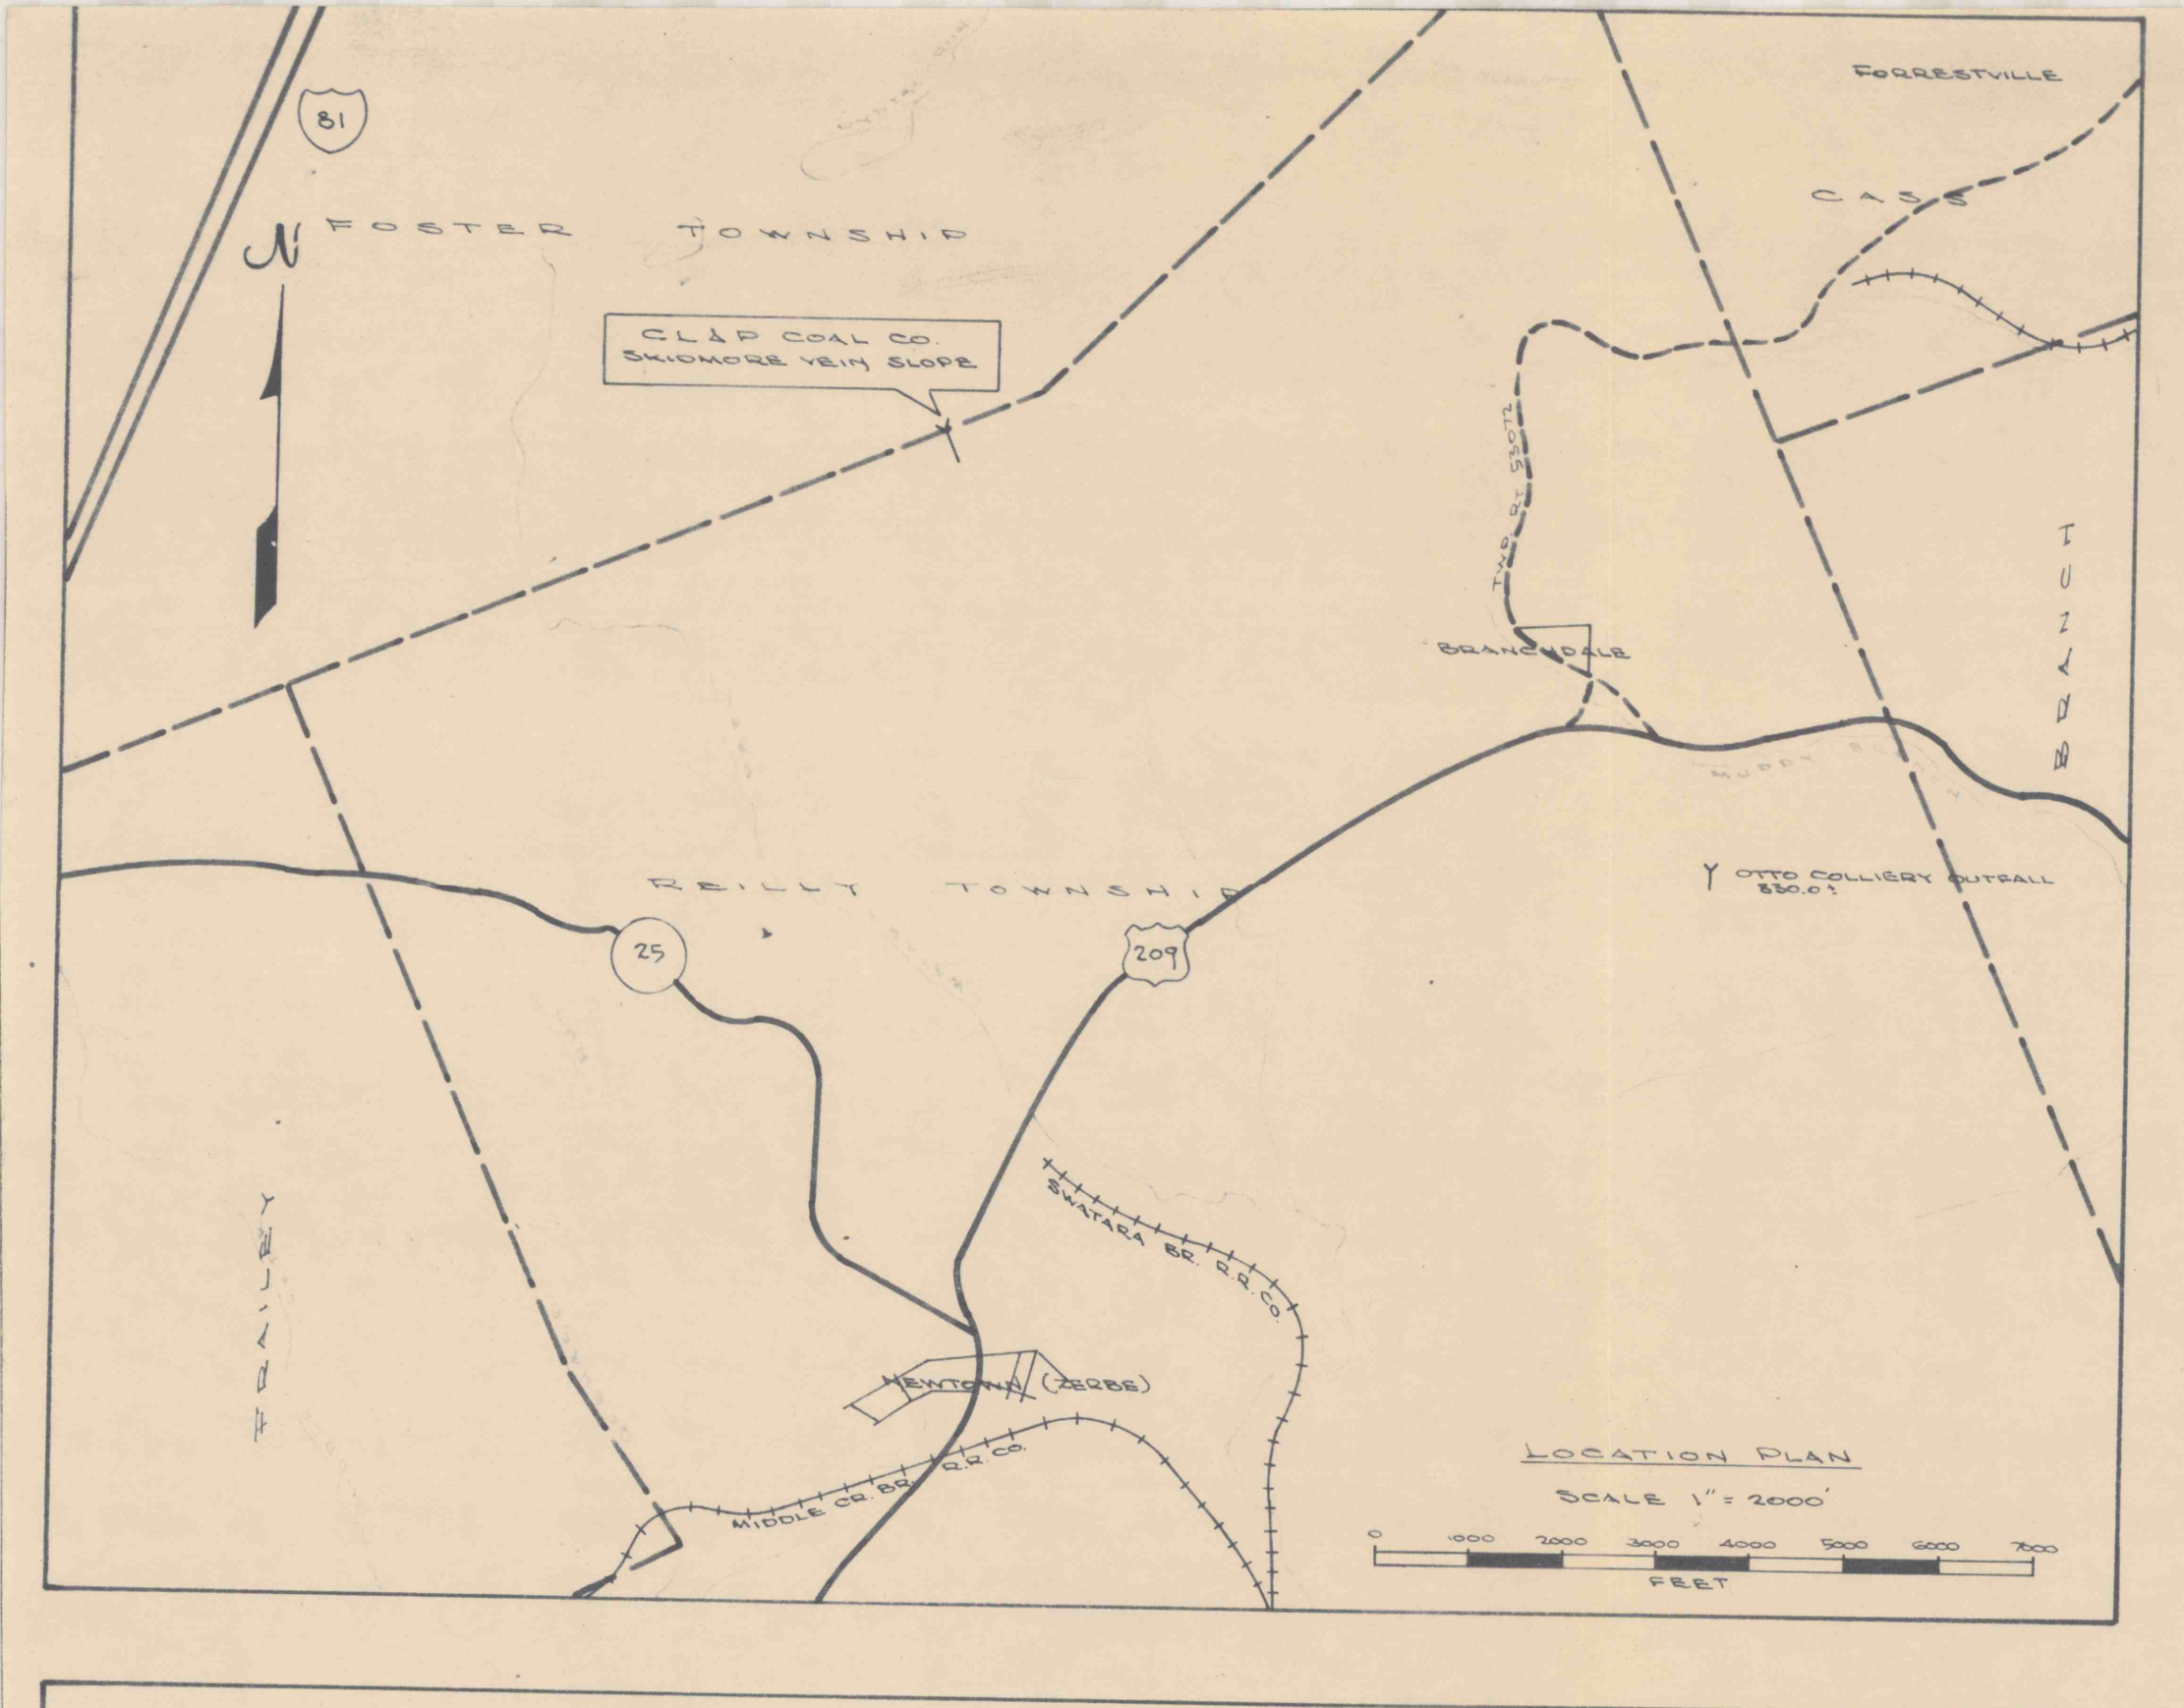

MINE MAP
Showing the location and extent of development (as reported by the Operator) of the C.L. & P. Coal Company Slope Mine. Situate on the South dip Skidmore Vein, Foster and Reilly Townships, Schuylkill County, Pa.
A.B. Riedel, P.E. May 9, 1977
Scale 1"=100'