

36-02019

BARBARA ARTILLA TRACT


KILLIAN MAY TRACT

FOSTER TOWNSHIP
REILLY TOWNSHIP



ELIZABETH WILDBAHN TRACT

JOHN FRY TRACT

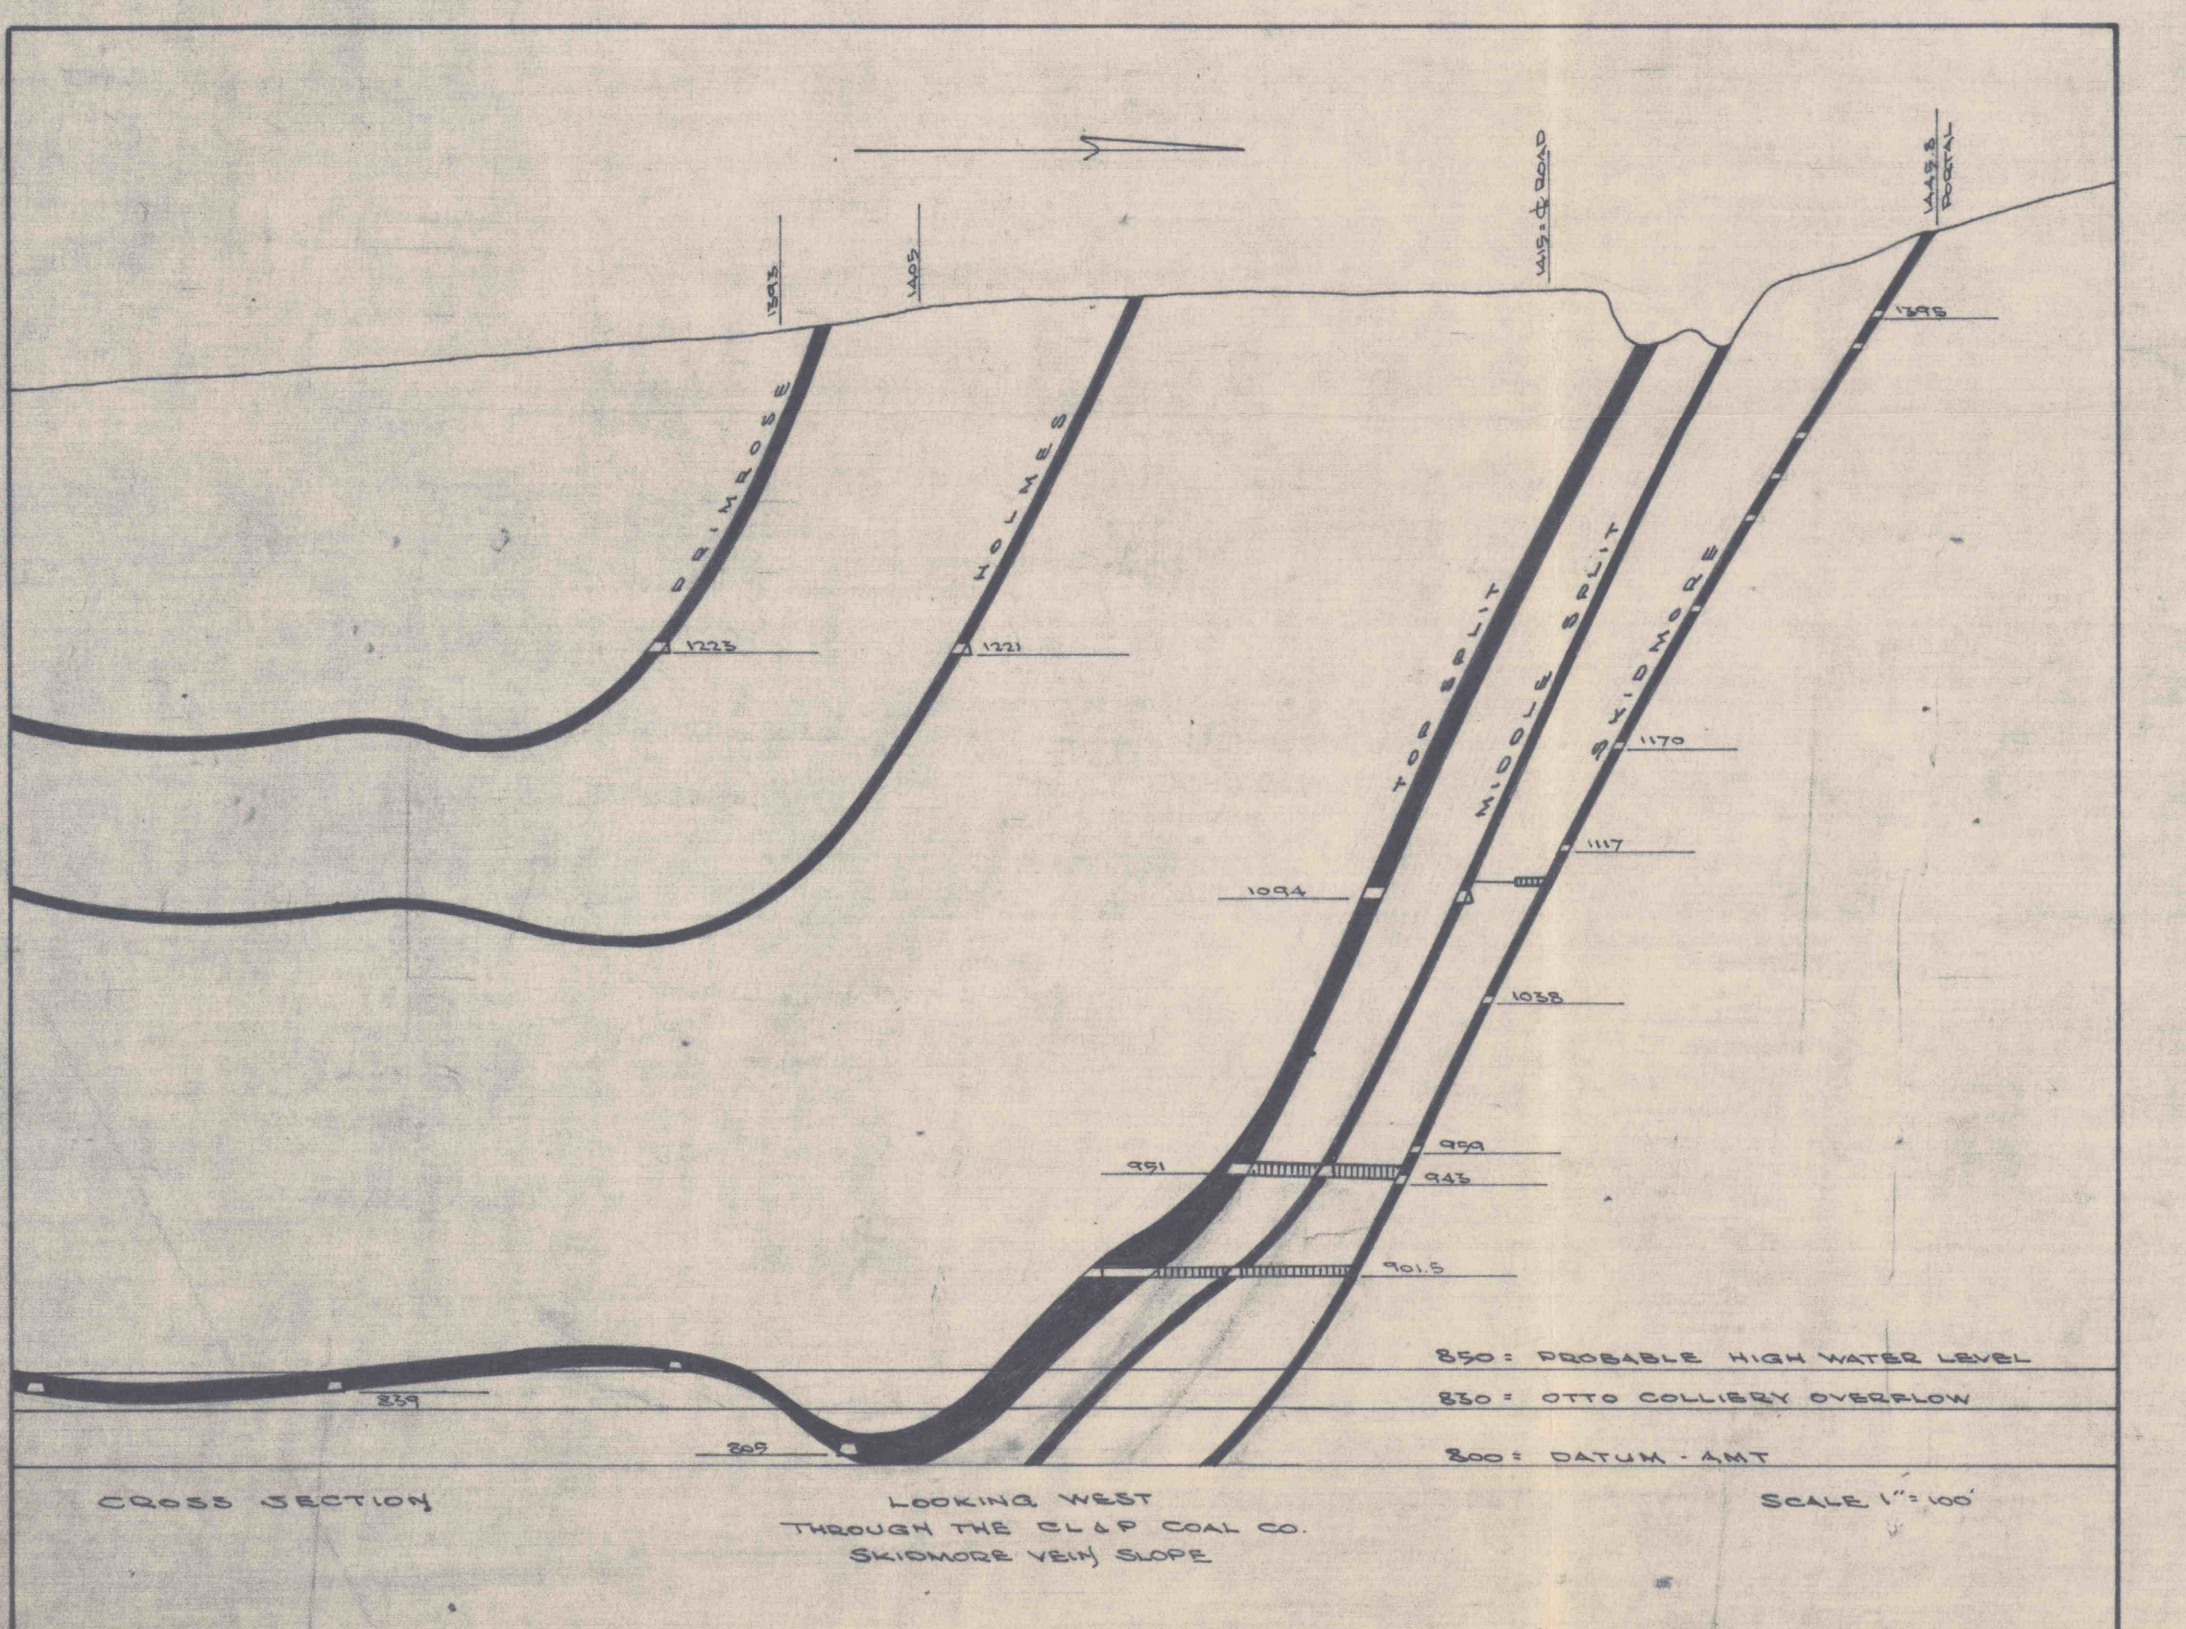

ROVD
6-1-78
BSH E
C.L. & P. Coal Co.
Slaters Slope Mine
36-02019

A.B. Riedel

MINE MAP
Showing the location and extent of development of the C.L. & P. Coal Co. Slope Mine. Situate on the So. dip Skidmore Vein, Reilly Township, Schuylkill County, Pa.
A.B. Riedel, P.E. Jan. 5, 1978
Scale 1"=100'