


N I C H O L A S H A L T E R

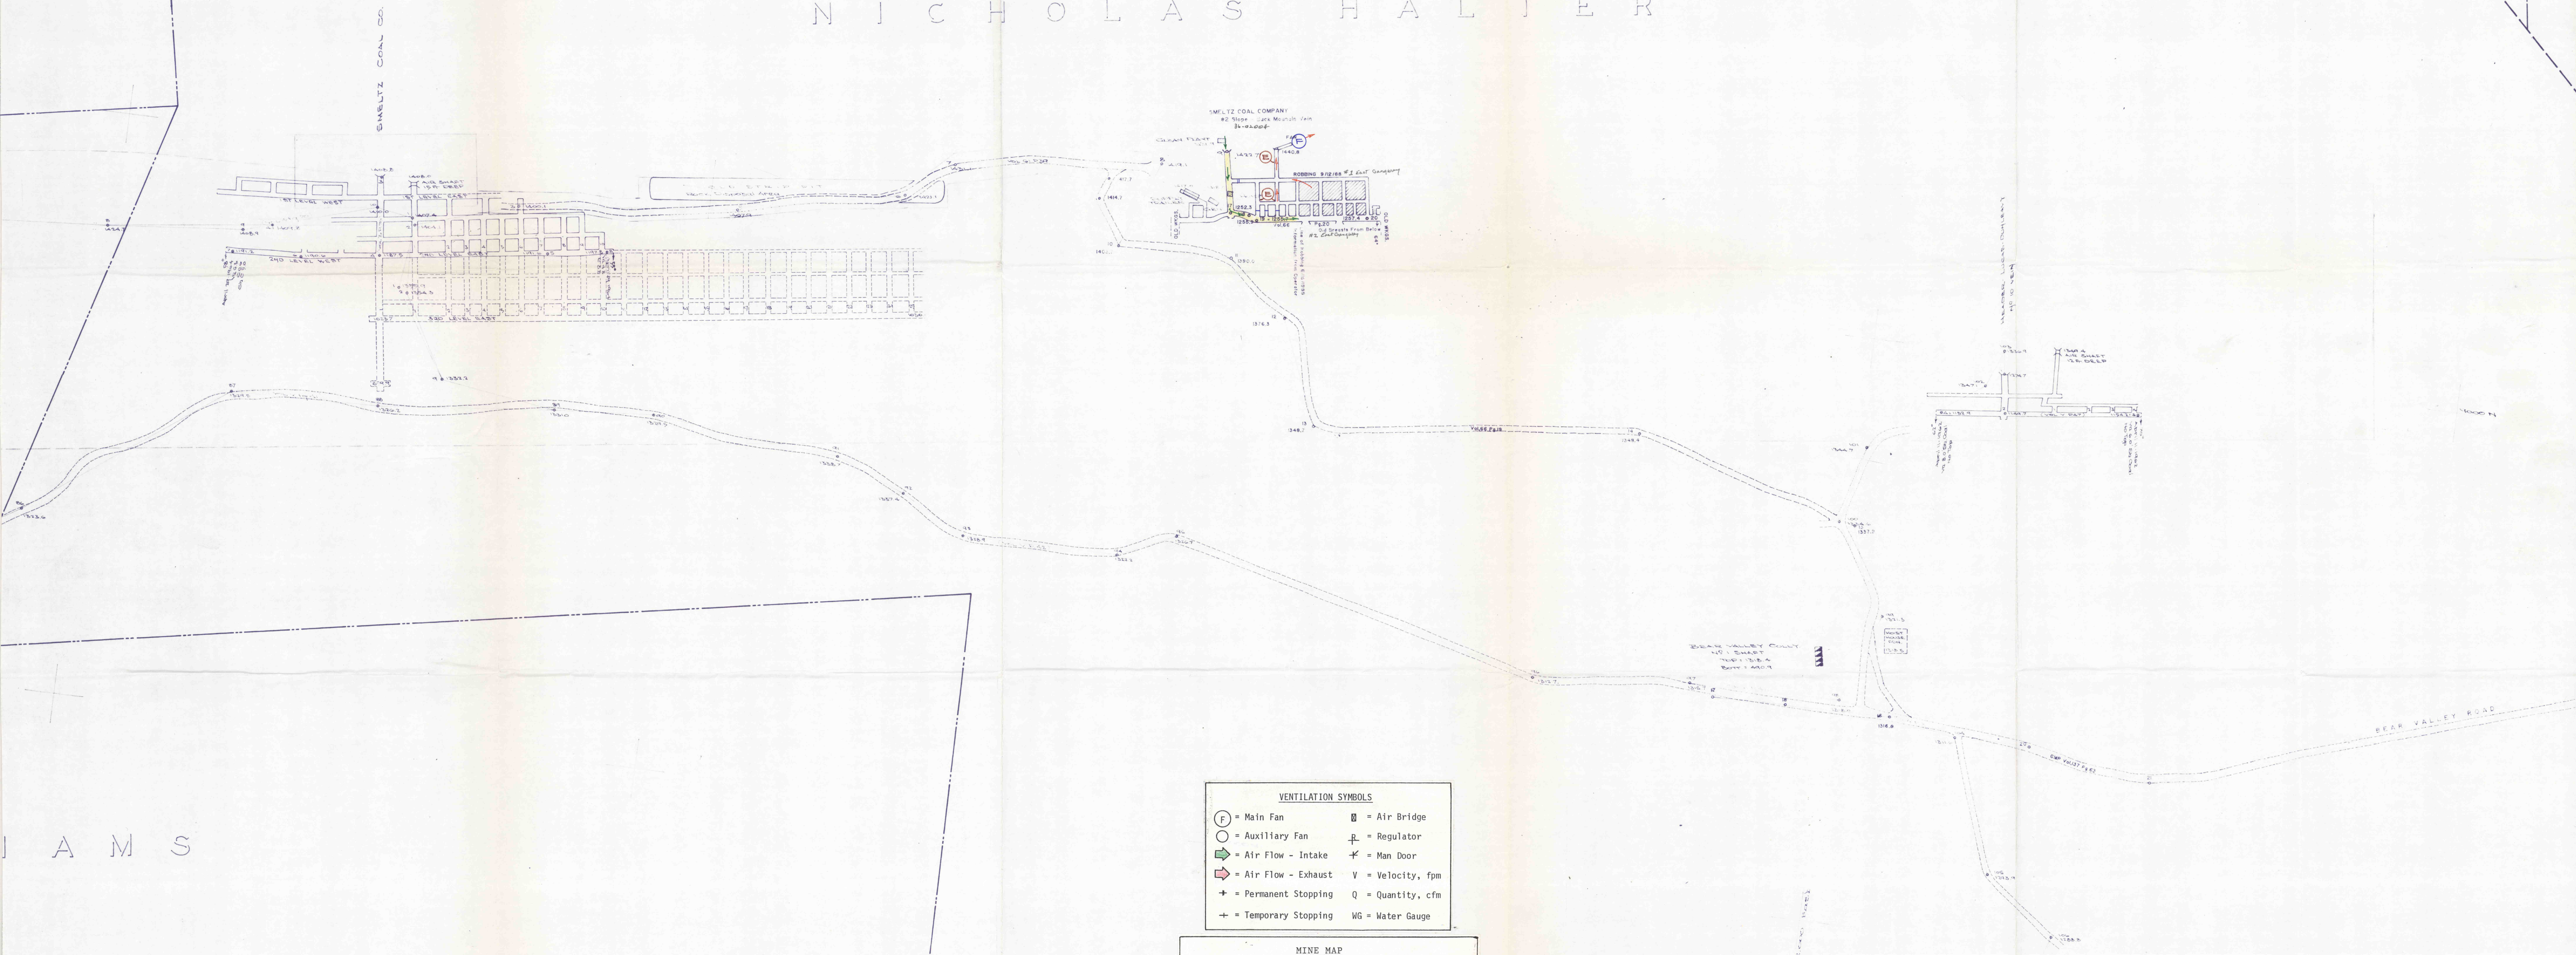

April 3, 1988