


- (E) - Surface Fan
- (E) - Escapeway
- (E) - Intake Air
- (E) - Exhaust Air
- (E) - Permanent Stopping
- (E) - Temporary Stopping

NICHOLAS HALTER TRACT

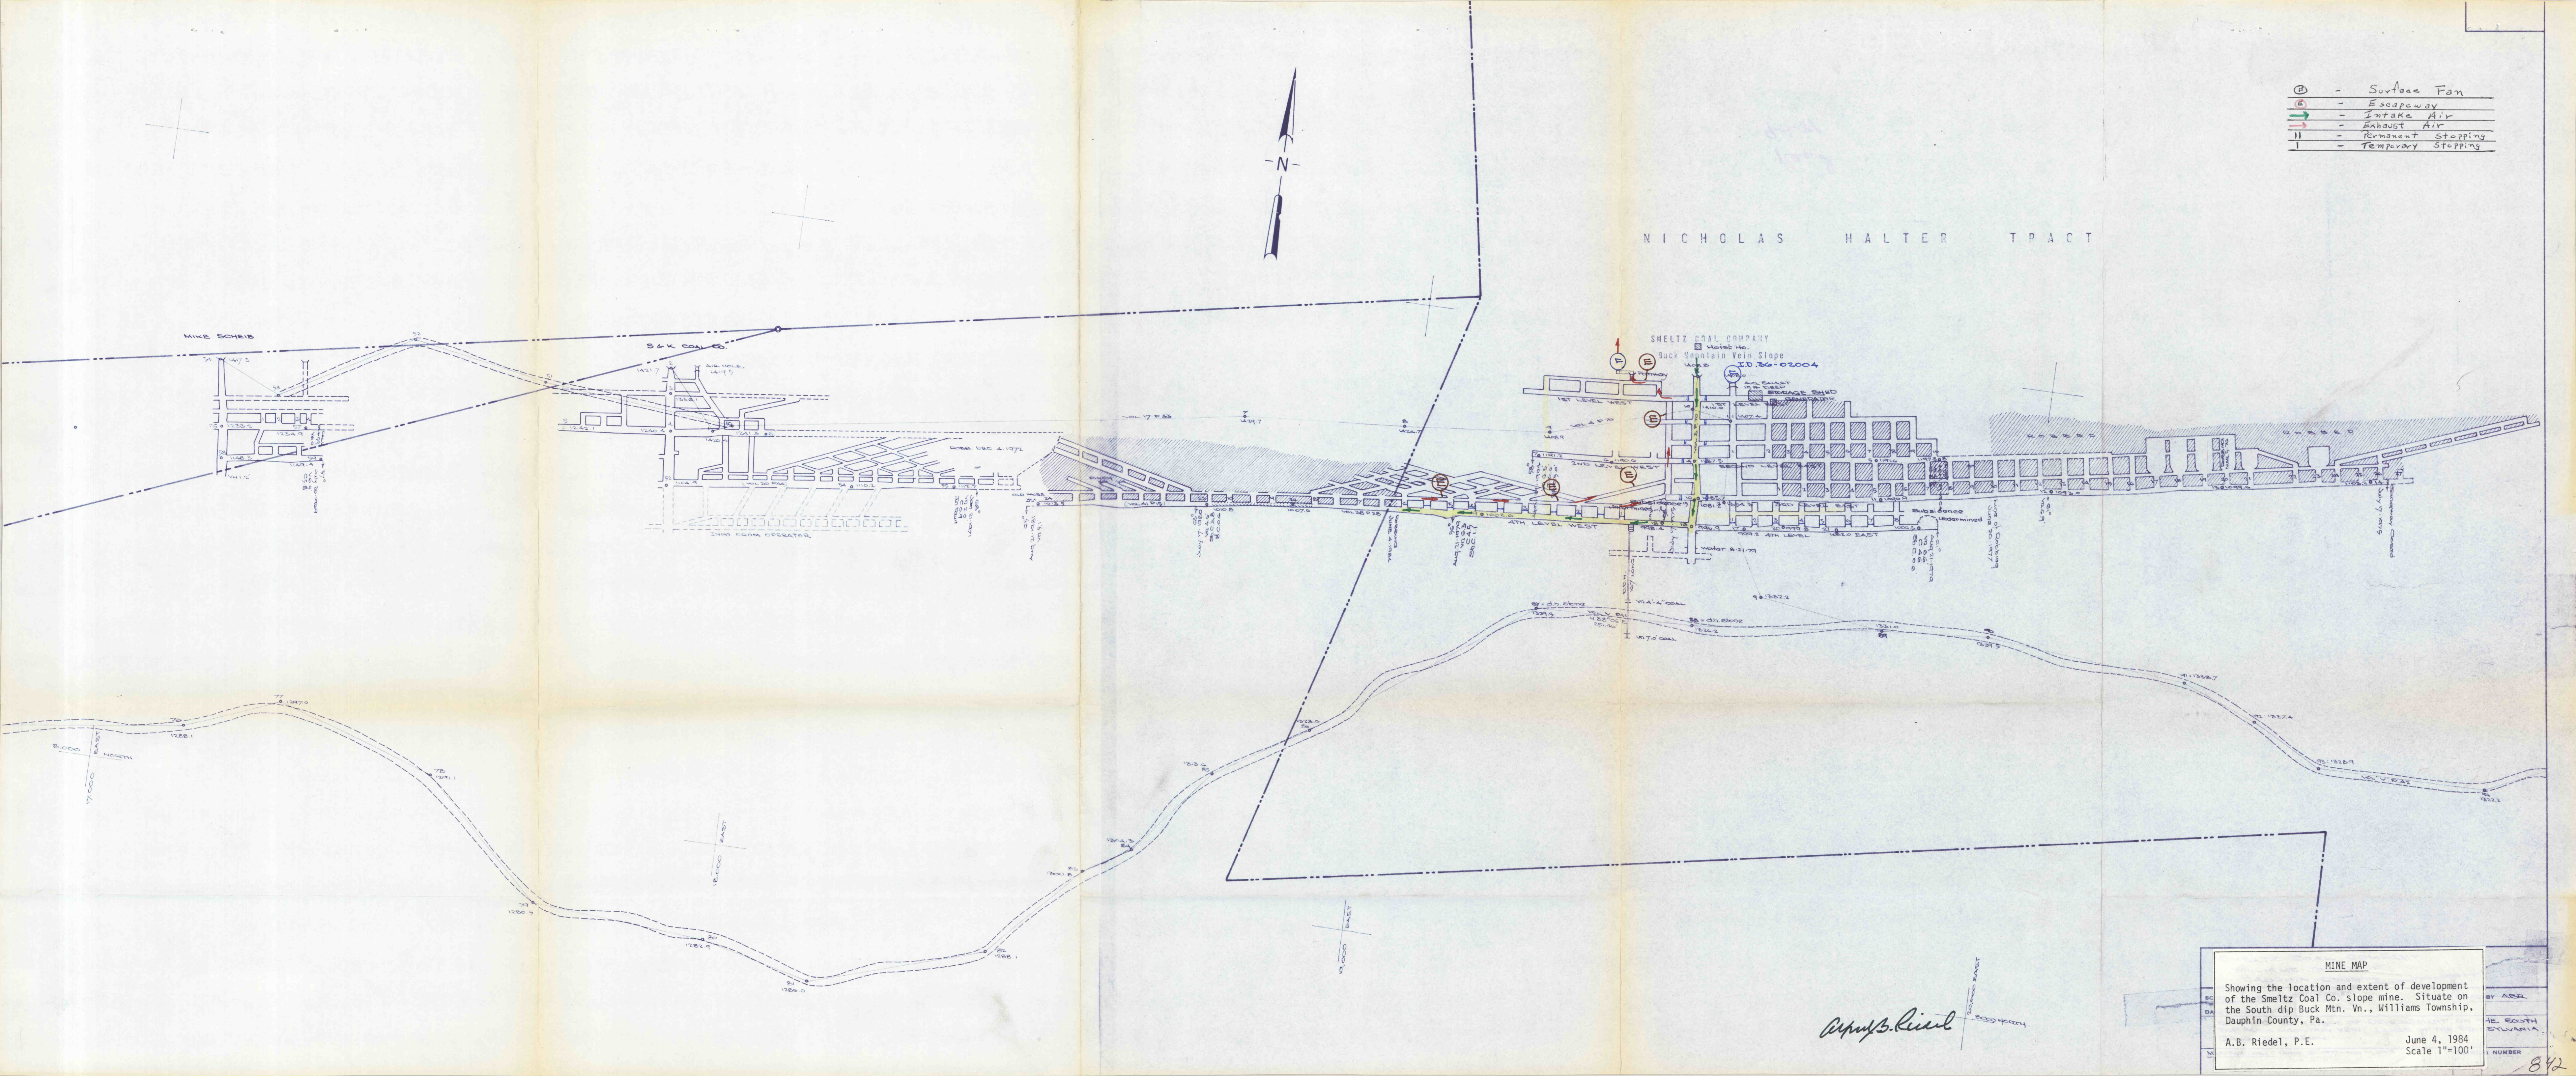

MINE MAP
 Showing the location and extent of development of the Smeltz Coal Co. slope mine. Situate on the South dip Buck Mtn. Vn., Williams Township, Dauphin County, Pa.
 A.B. Riedel, P.E. June 4, 1984
 Scale 1"=100'