


RENNINGER COAL CO. LANDS

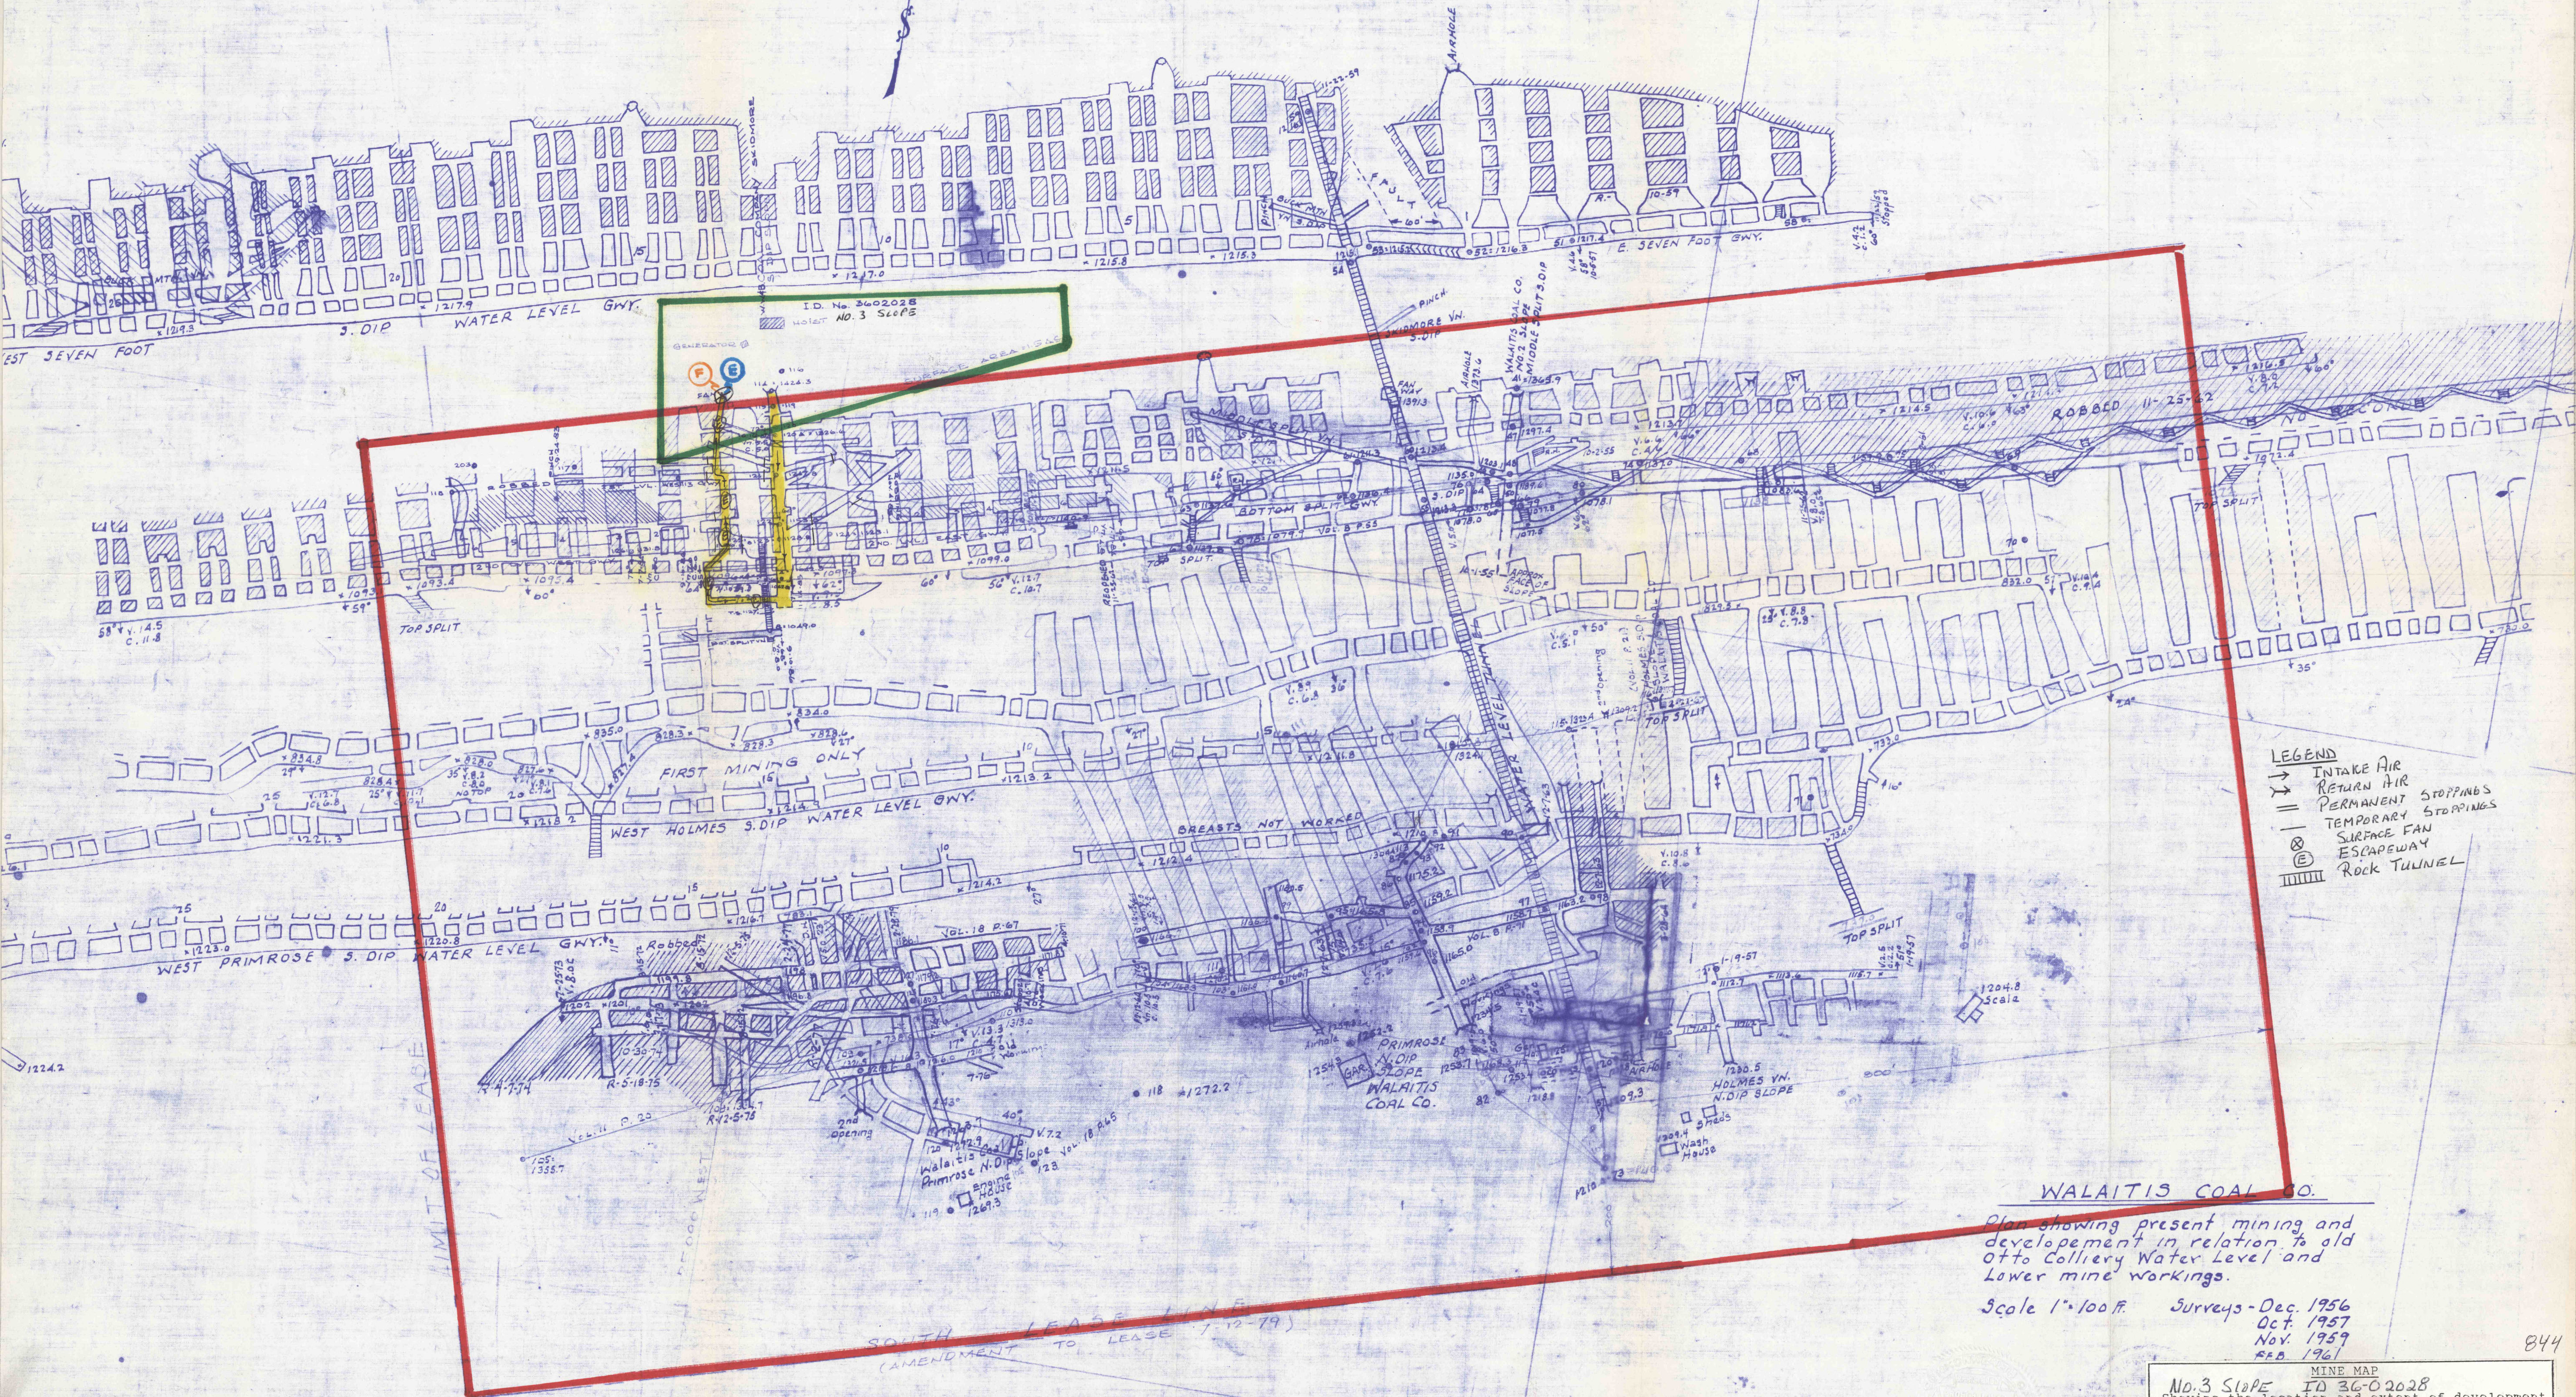

- LEGEND**
- INTAKE AIR
 - RETURN AIR
 - PERMANENT STOPPINGS
 - - - TEMPORARY STOPPINGS
 - ⊗ SURFACE FAN
 - ⓔ ESCAPEWAY
 - ▨ ROCK TUNNEL

WALAITIS COAL CO.

Plan showing present mining and development in relation to old Otto Colliery Water Level and Lower mine workings.

Scale 1"=100' Surveys - Dec. 1956
Oct. 1957
Nov. 1959
Feb. 1961

NO. 3 SLOPE I.D. 3602028
Showing the location and extent of development of the W.W. & B. Coal Company Slope Mine. Situate on the South dip Skidmore Vein, Reilly Township, Schuylkill County, Pa.