


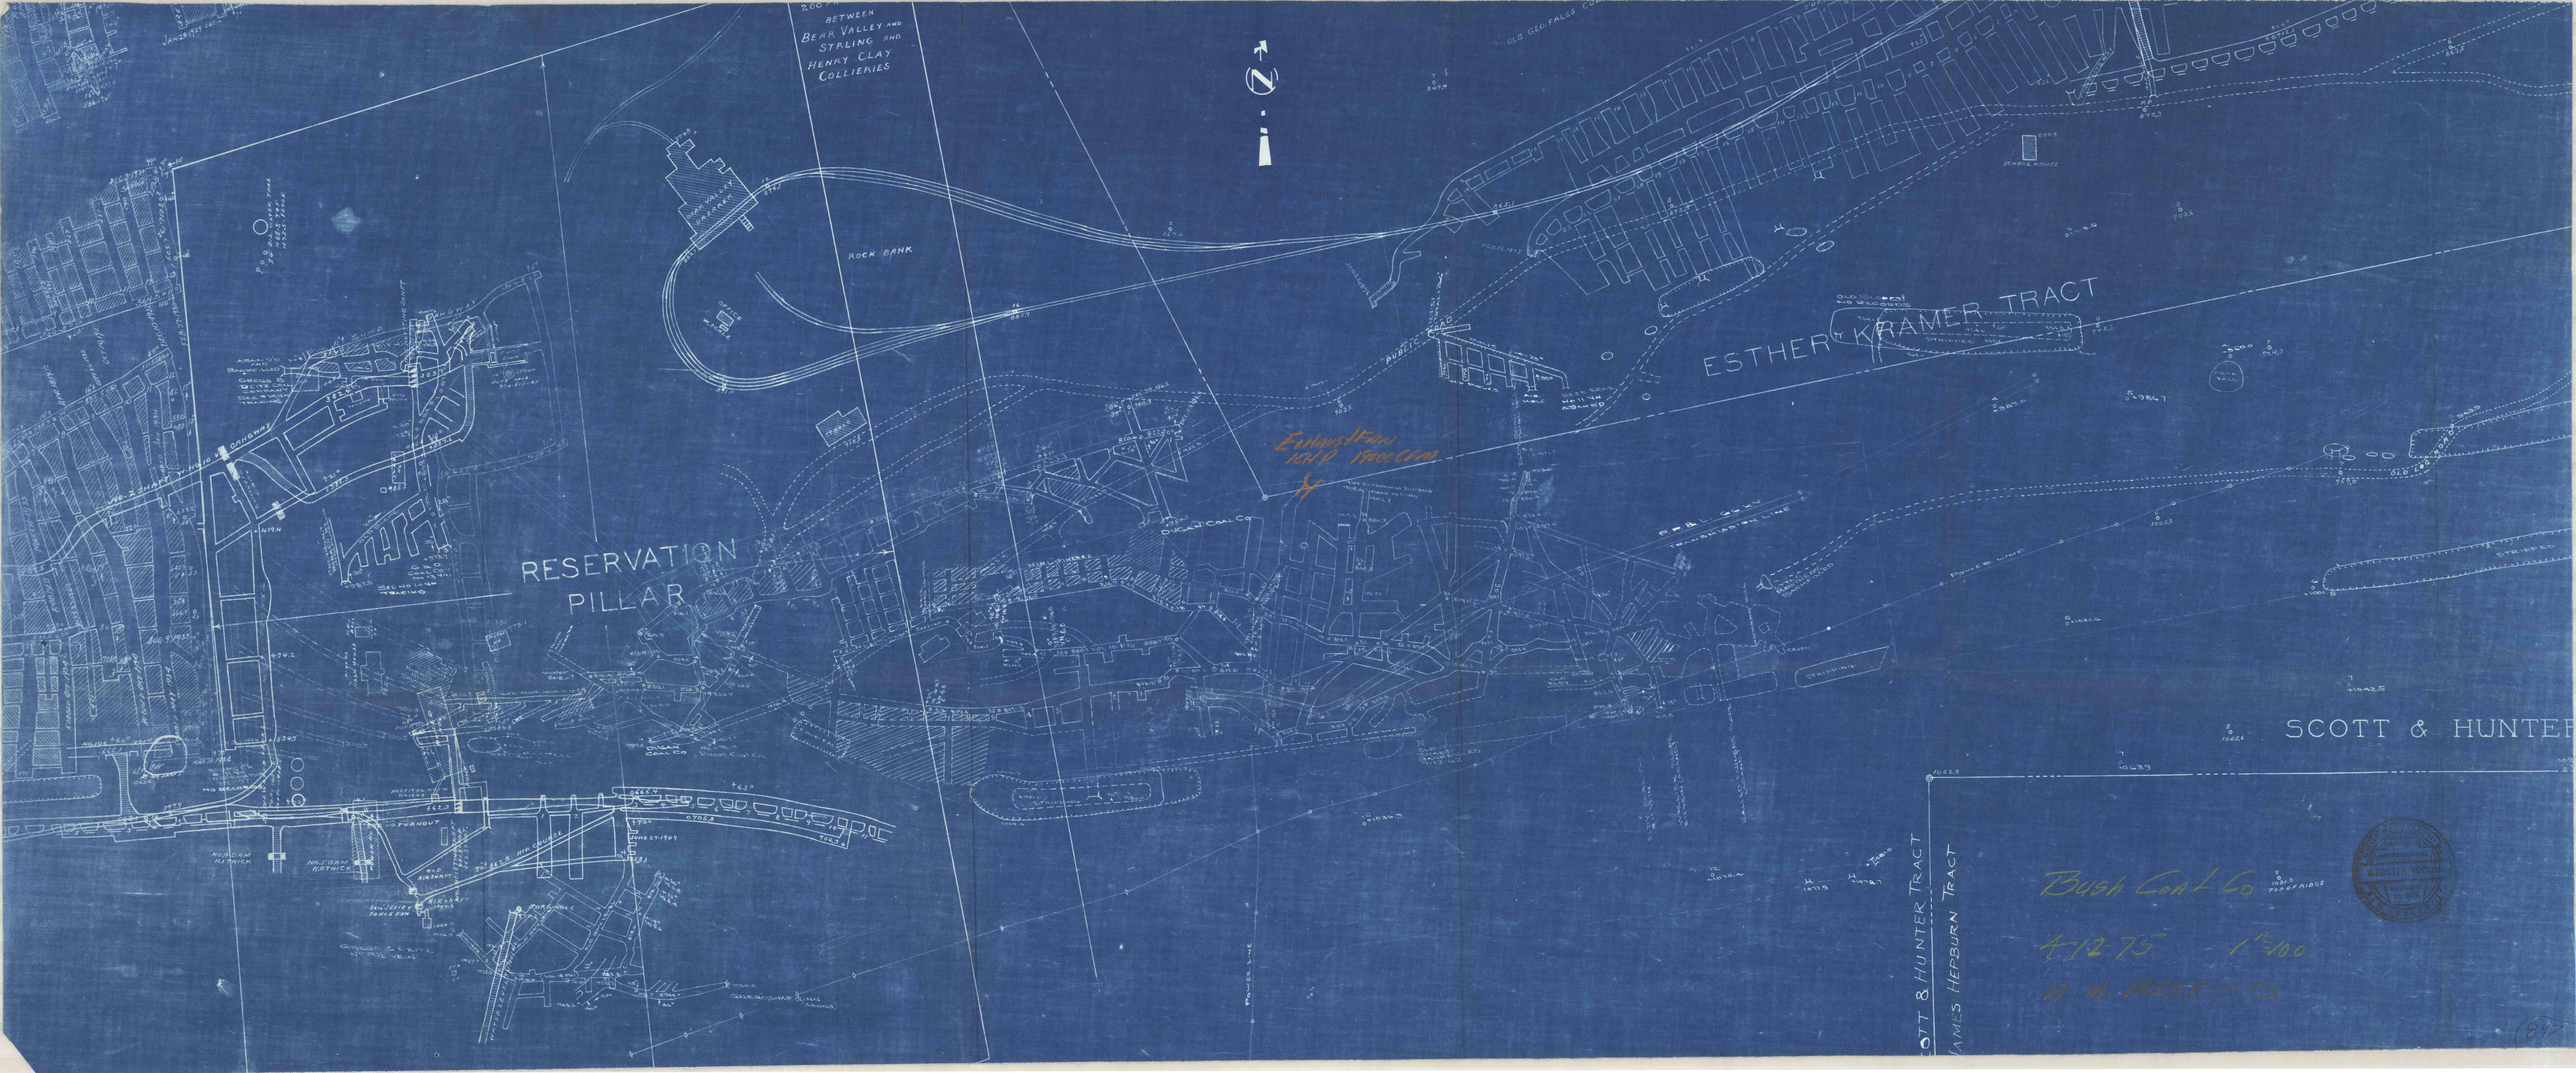

BETWEEN
BEAR VALLEY AND
STALING AND
HENRY CLAY
COLLIERIES



ROCK BANK

ESTHER KRAMER TRACT

RESERVATION
PILLAR


SCOTT & HUNTER

SCOTT & HUNTER TRACT
JAMES HEPBURN TRACT

Bush Coal Co

4-12-75 1"=100'

W. M. MERRITT

