


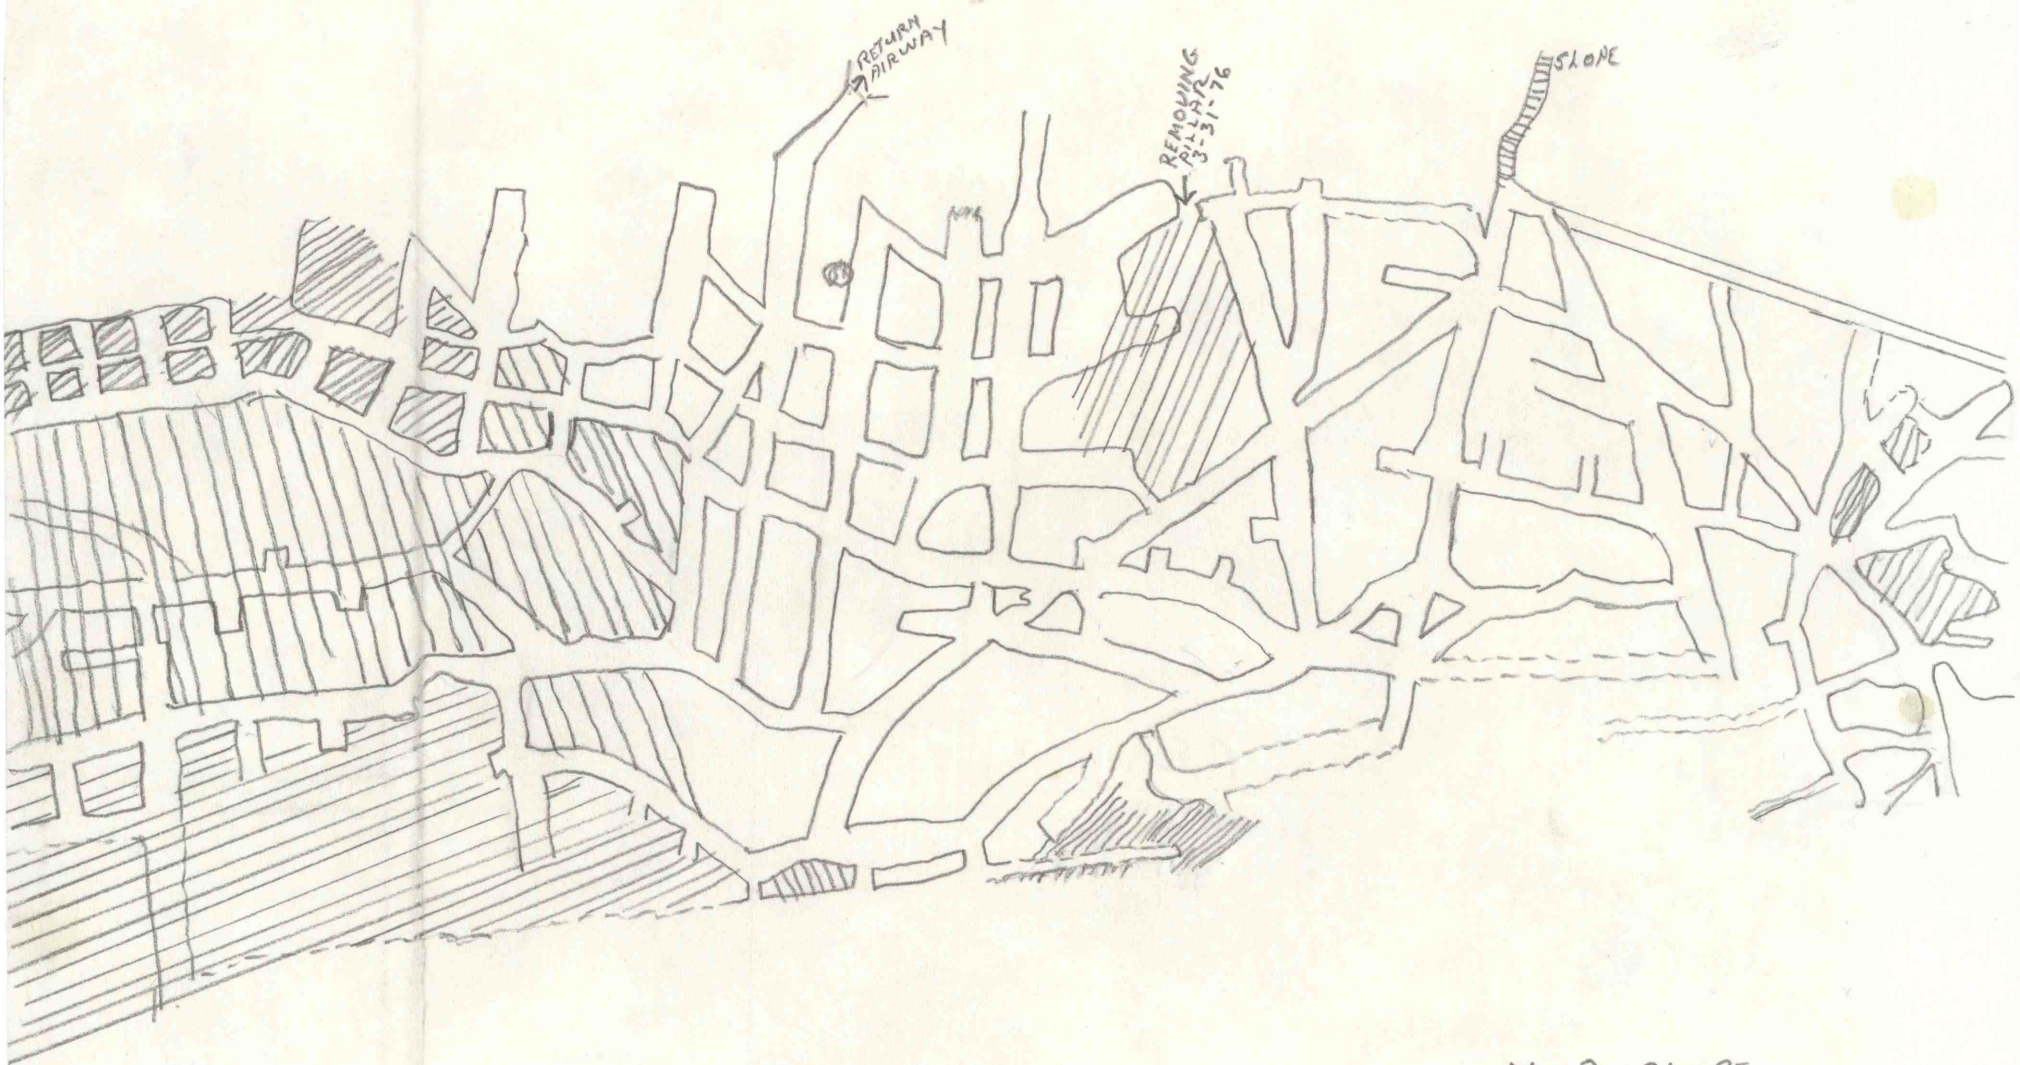

THIS IS AN ACCURATE AND
UP-TO DATE MAP.

No 2 SLOPE

BUSH COAL COMPANY

SHAMOKIN, NORTHUMBERLAND COUNTY, PA

I.D. 36-02083