



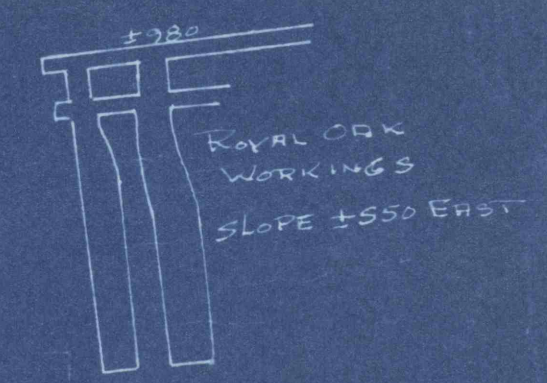

700 Cont Company
1-100 10-2-76

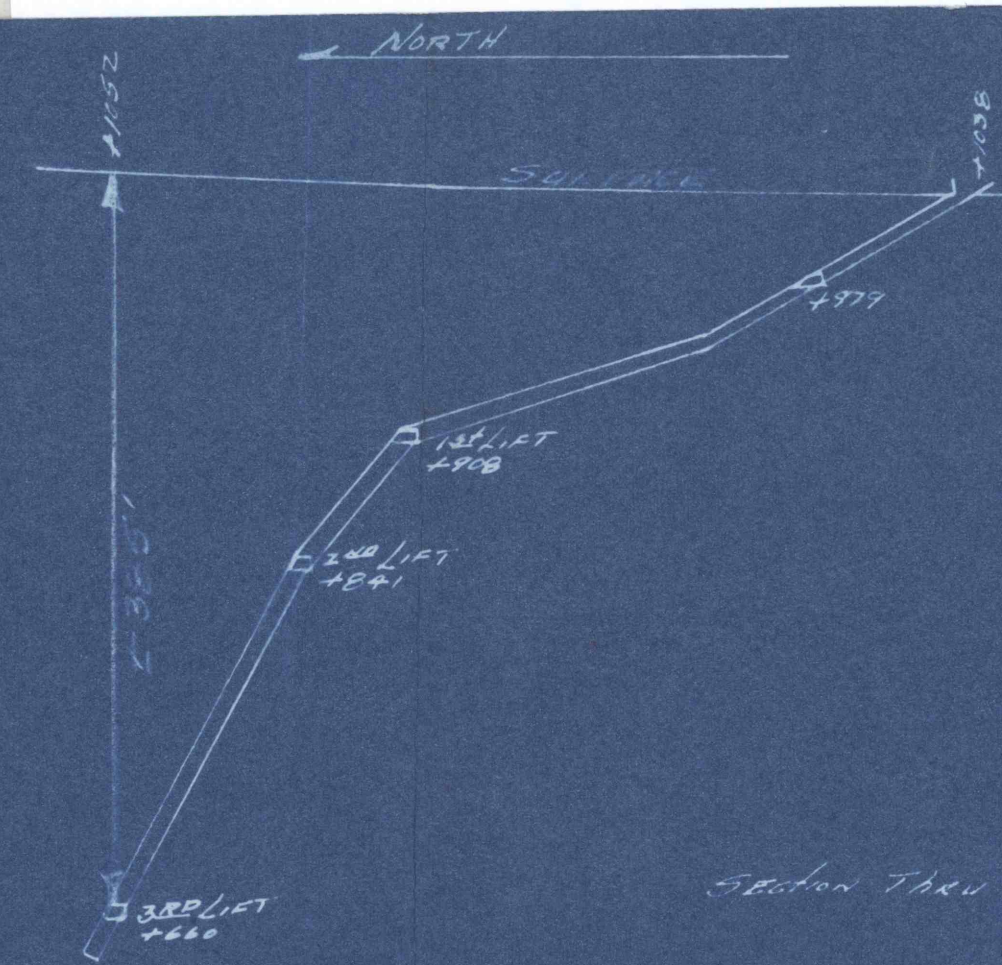