
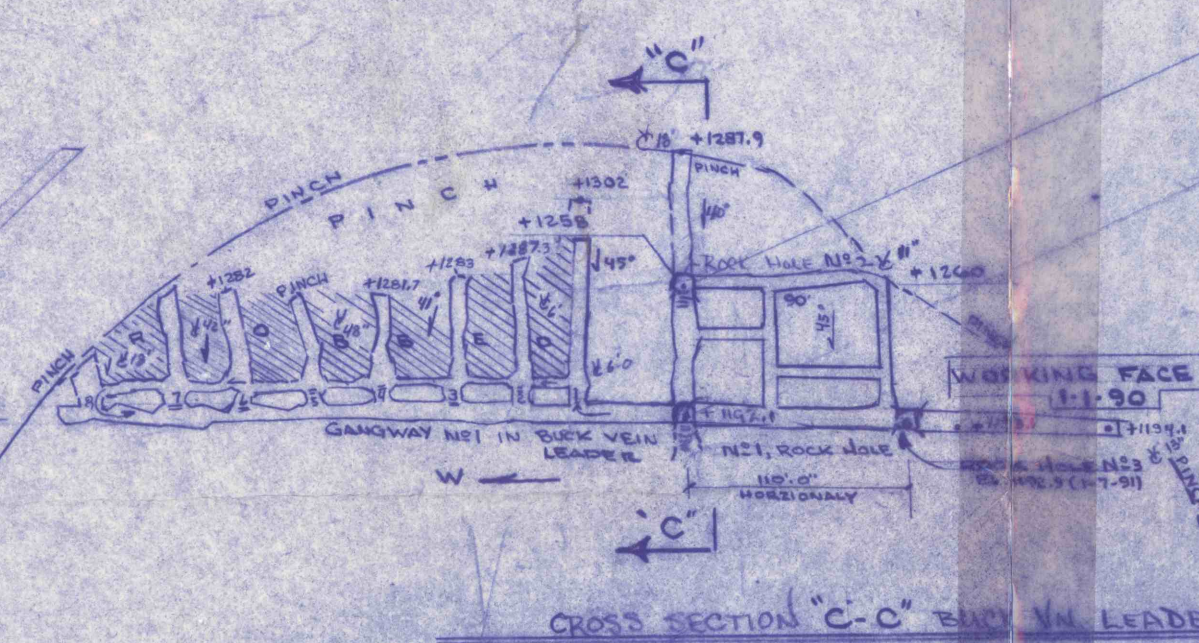
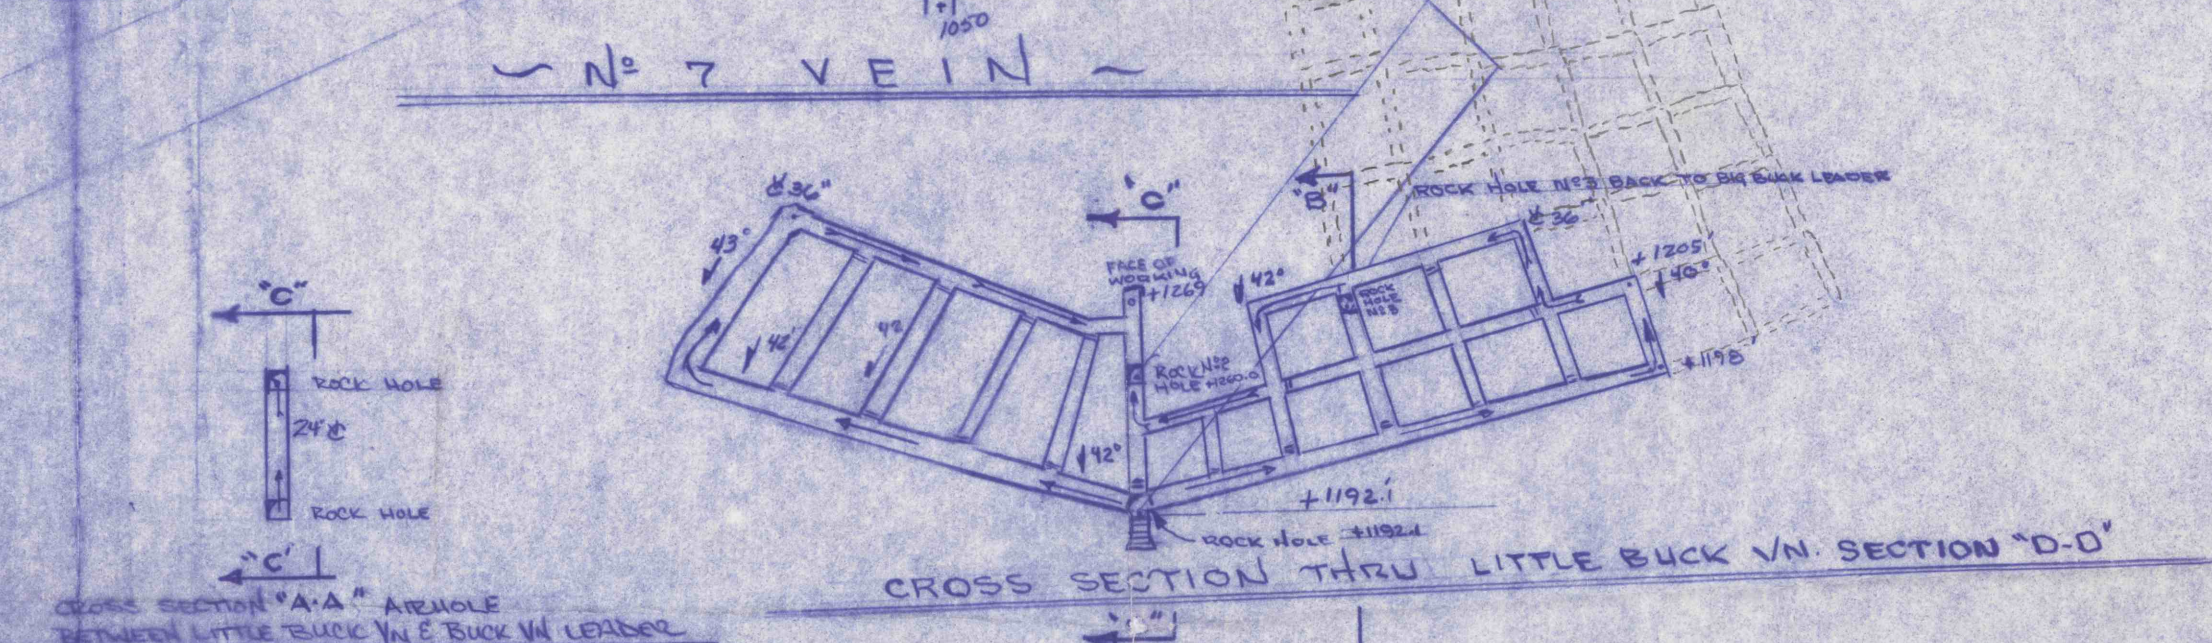
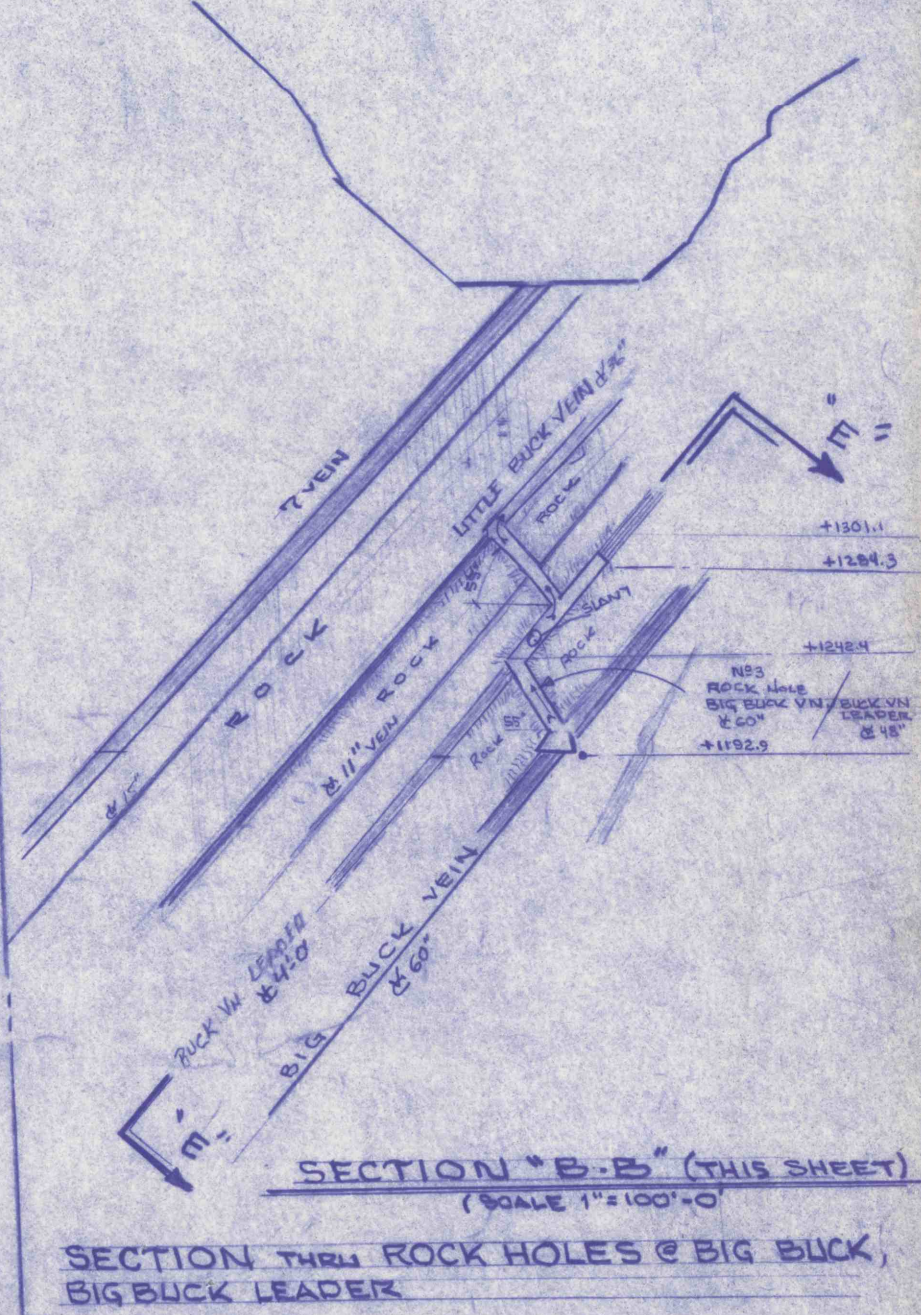
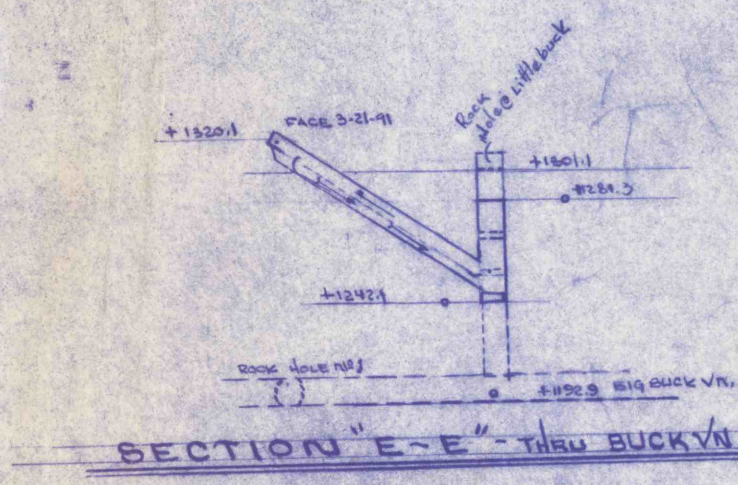


JOHN YOUNG TRACT


**KENO COAL CO.
SEVEN FOOT VEIN SLOPE**

R & L SLOPE (ABANDONED)

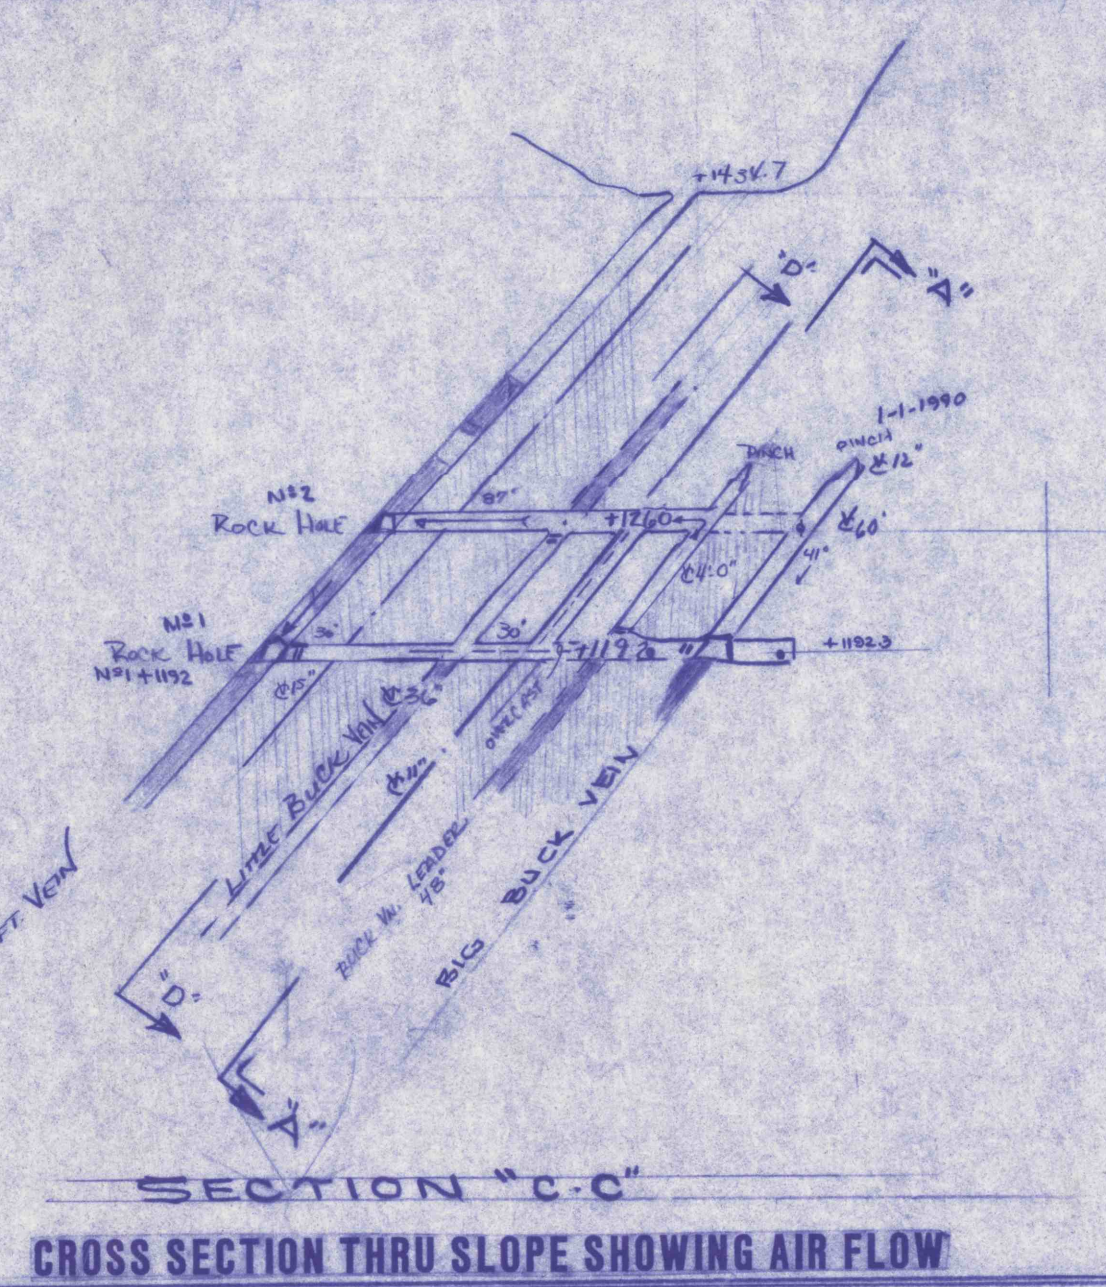

LEGEND

- THROUGH STOPPING
- PERMANENT STOPPING
- AIR INTAKE
- AIR RETURN
- ESCAPEWAY
- MAIN FAN
- TREATMENT
- ROCK HOLE

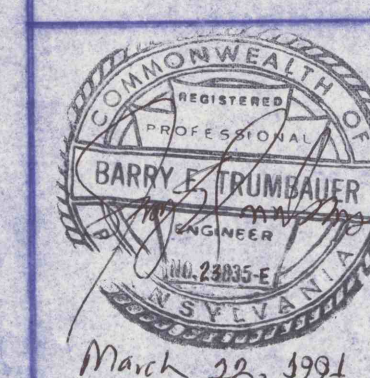

KENO COAL CO. No. 1 Slope
SOUTH DIP
CONYNGHAM TOWNSHIP
COLUMBIA COUNTY
ID-36-02257

SCALE: 1"=100'-0"

OCT. 1986
JAN. 1, 1990
MARCH 20, 1991

C-121