

JOHN YOUNG TRACT

KEENO COAL CO.
SEVEN FOOT VEIN SLOPE

B & L SLOPE (ABANDONED)


CROSS SECTION THRU SLOPE SHOWING AIR FLOW

CROSS SECTION THRU LITTLE BUCK VN.

CROSS SECTION THRU LITTLE BUCK VN LEADER
SCALE 1"=100'-0"

LEGEND

- TEMPORARY STOPPING
- PERMANENT STOPPING
- AIR INTAKE
- AIR RETURN
- ESCAPEWAY
- MAIN FAN
- BEATICE

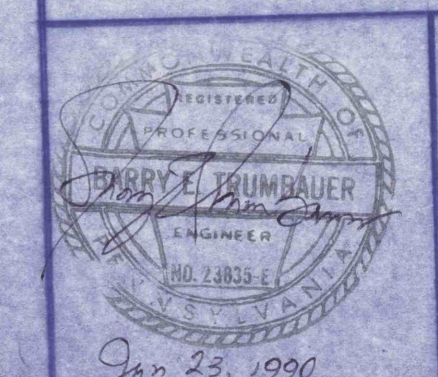

KEENO COAL CO.
SEVEN FOOT VEIN
SOUTH DIP
CONYNGHAM TOWNSHIP
COLUMBIA COUNTY
ID-36-02257
SCALE: 1"=100'-0"

Oct. 1988
Jan. 1, 1990

874
C-12