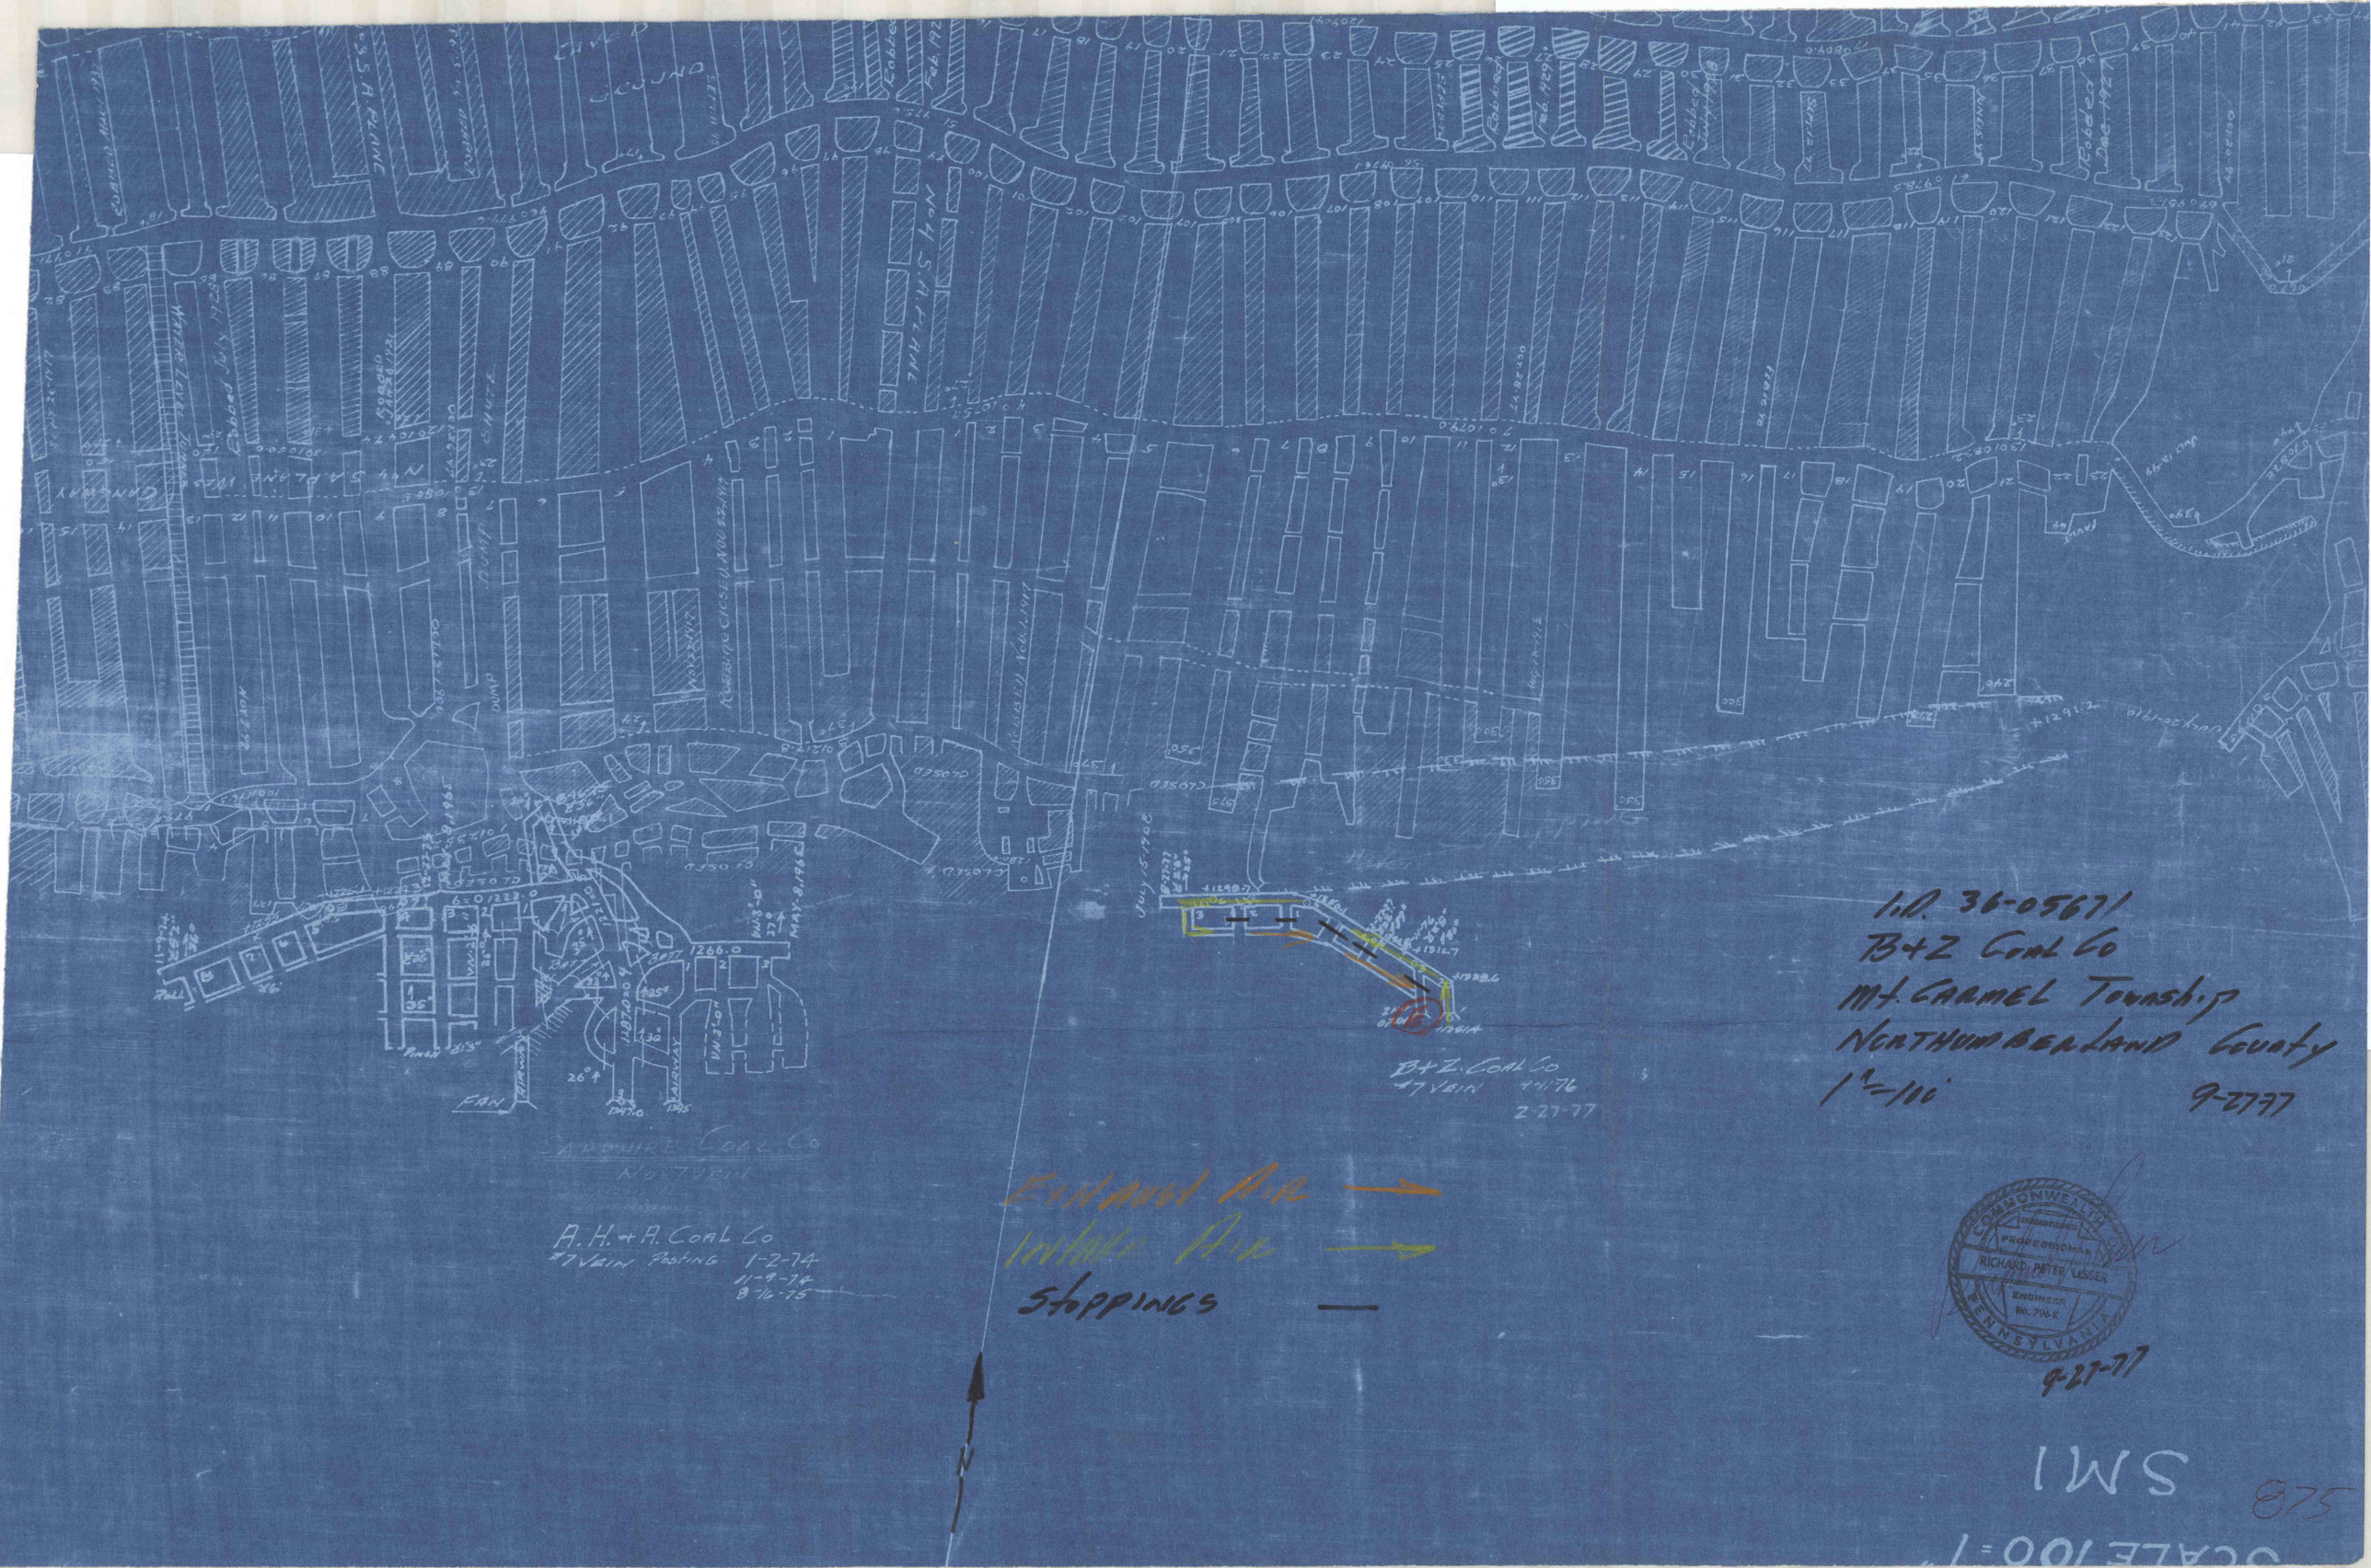
I.D. 36-05671
B+Z Coal Co
Mt. Carmel Township
Northumberland County
1"=100'
9-27-77
B+Z Coal Co
#7 Vein 4-11-76
2-27-77
Exhaust Air
Intake Air
Stoppings
A.H. + A. Coal Co
#7 Vein Posting 1-2-74
11-9-74
8-16-75
Fan
Railway
Dump
Closed
Mt. Carmel Tunnel
Mt. Carmel Avenue
Commonwealth of Pennsylvania
Registered Professional
Richard Peter Lesser
Engineer
No. 796-E
9-27-77
SM1
875
SCALE 100=1'