




SAPPHIRE COAL CO
NO TWIN

A.H. & P. COAL CO
TWIN Posting 1-2-74
11-9-74
8-16-75

No 1 Slope
I.D. 36-05671
EXELSIOR, NORTH'D.CO; P.A.

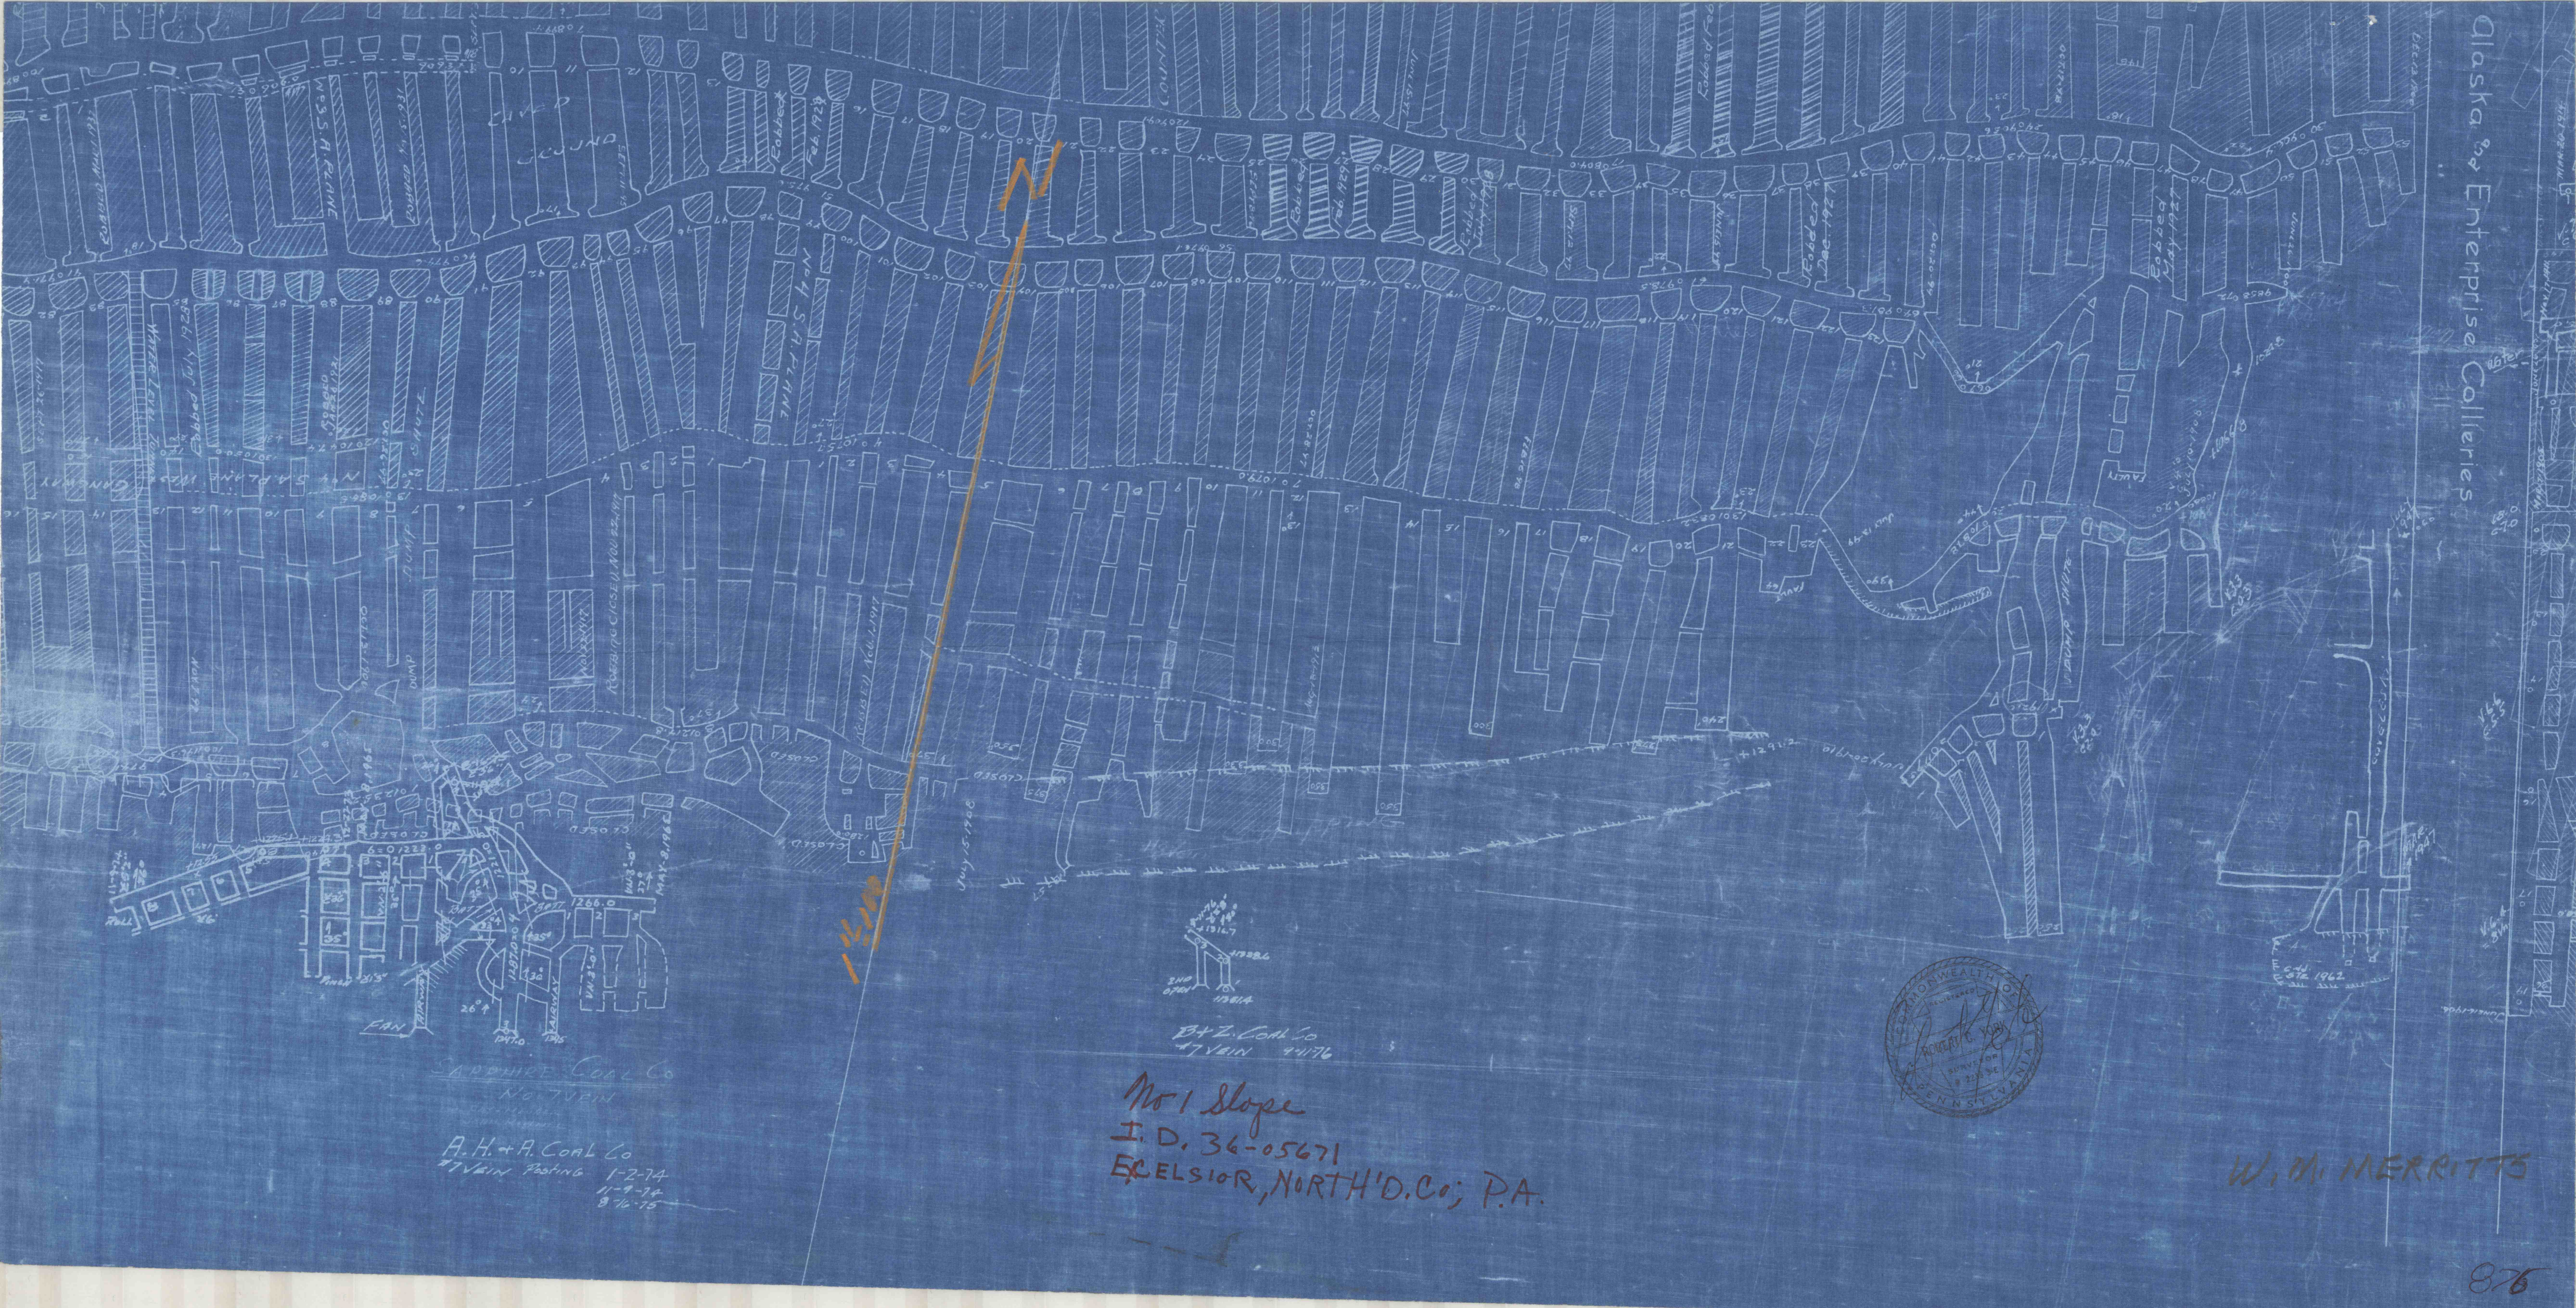

W.M. MERRITT