


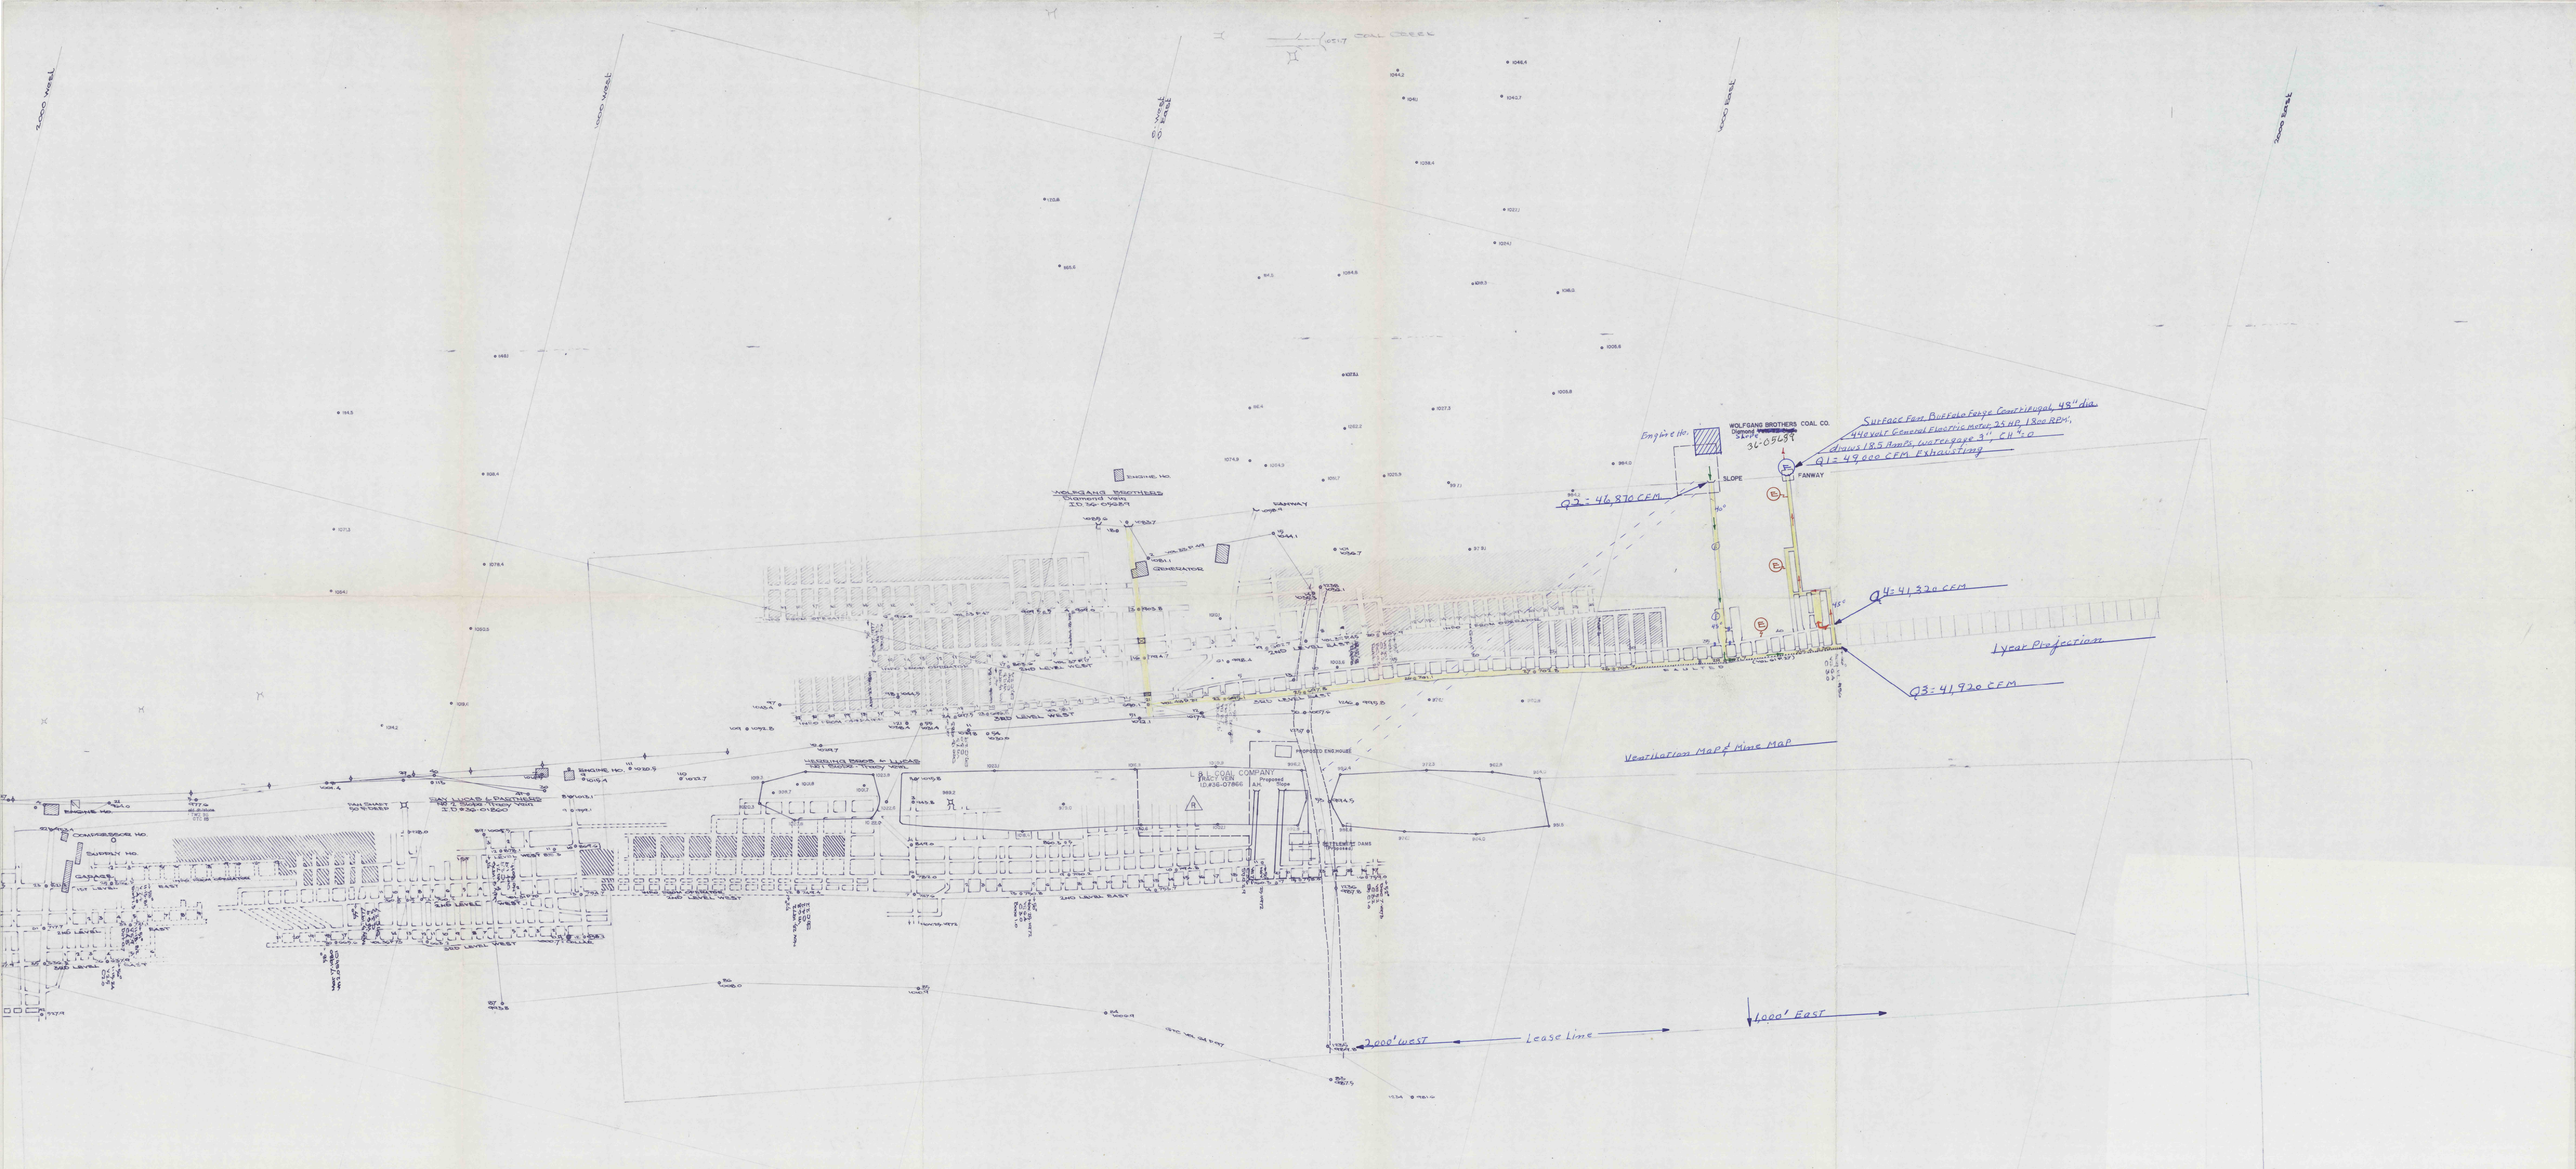

MINE MAP
Showing the location and extent of development as per operator of the Wolfgang Brothers Coal Company slope mine. Situate on the South dip, Diamond Vein, Frailley Twp., Schuylkill Co., Pa.
A.B. Riedel, P.E. October 7, 1987
Scale 1" = 100'

VENTILATION SYMBOLS	
(F) = Main Fan	□ = Air Bridge
(A) = Auxiliary Fan	⌋ = Regulator
→ = Air Flow - Intake	⋈ = Man Door
→ = Air Flow - Exhaust	V = Velocity, fpm
+ = Permanent Stopping	Q = Quantity, cfm
+ = Temporary Stopping	WG = Water Gauge