


LEGEND

- = PERMANENT STOPPING
- TEMPORARY STOPPING
- INTAKE AIR
- RETURN AIR
- 1/11 OVERCAST
- Ⓔ ESCAPEWAY
- Ⓕ SURFACE FAN

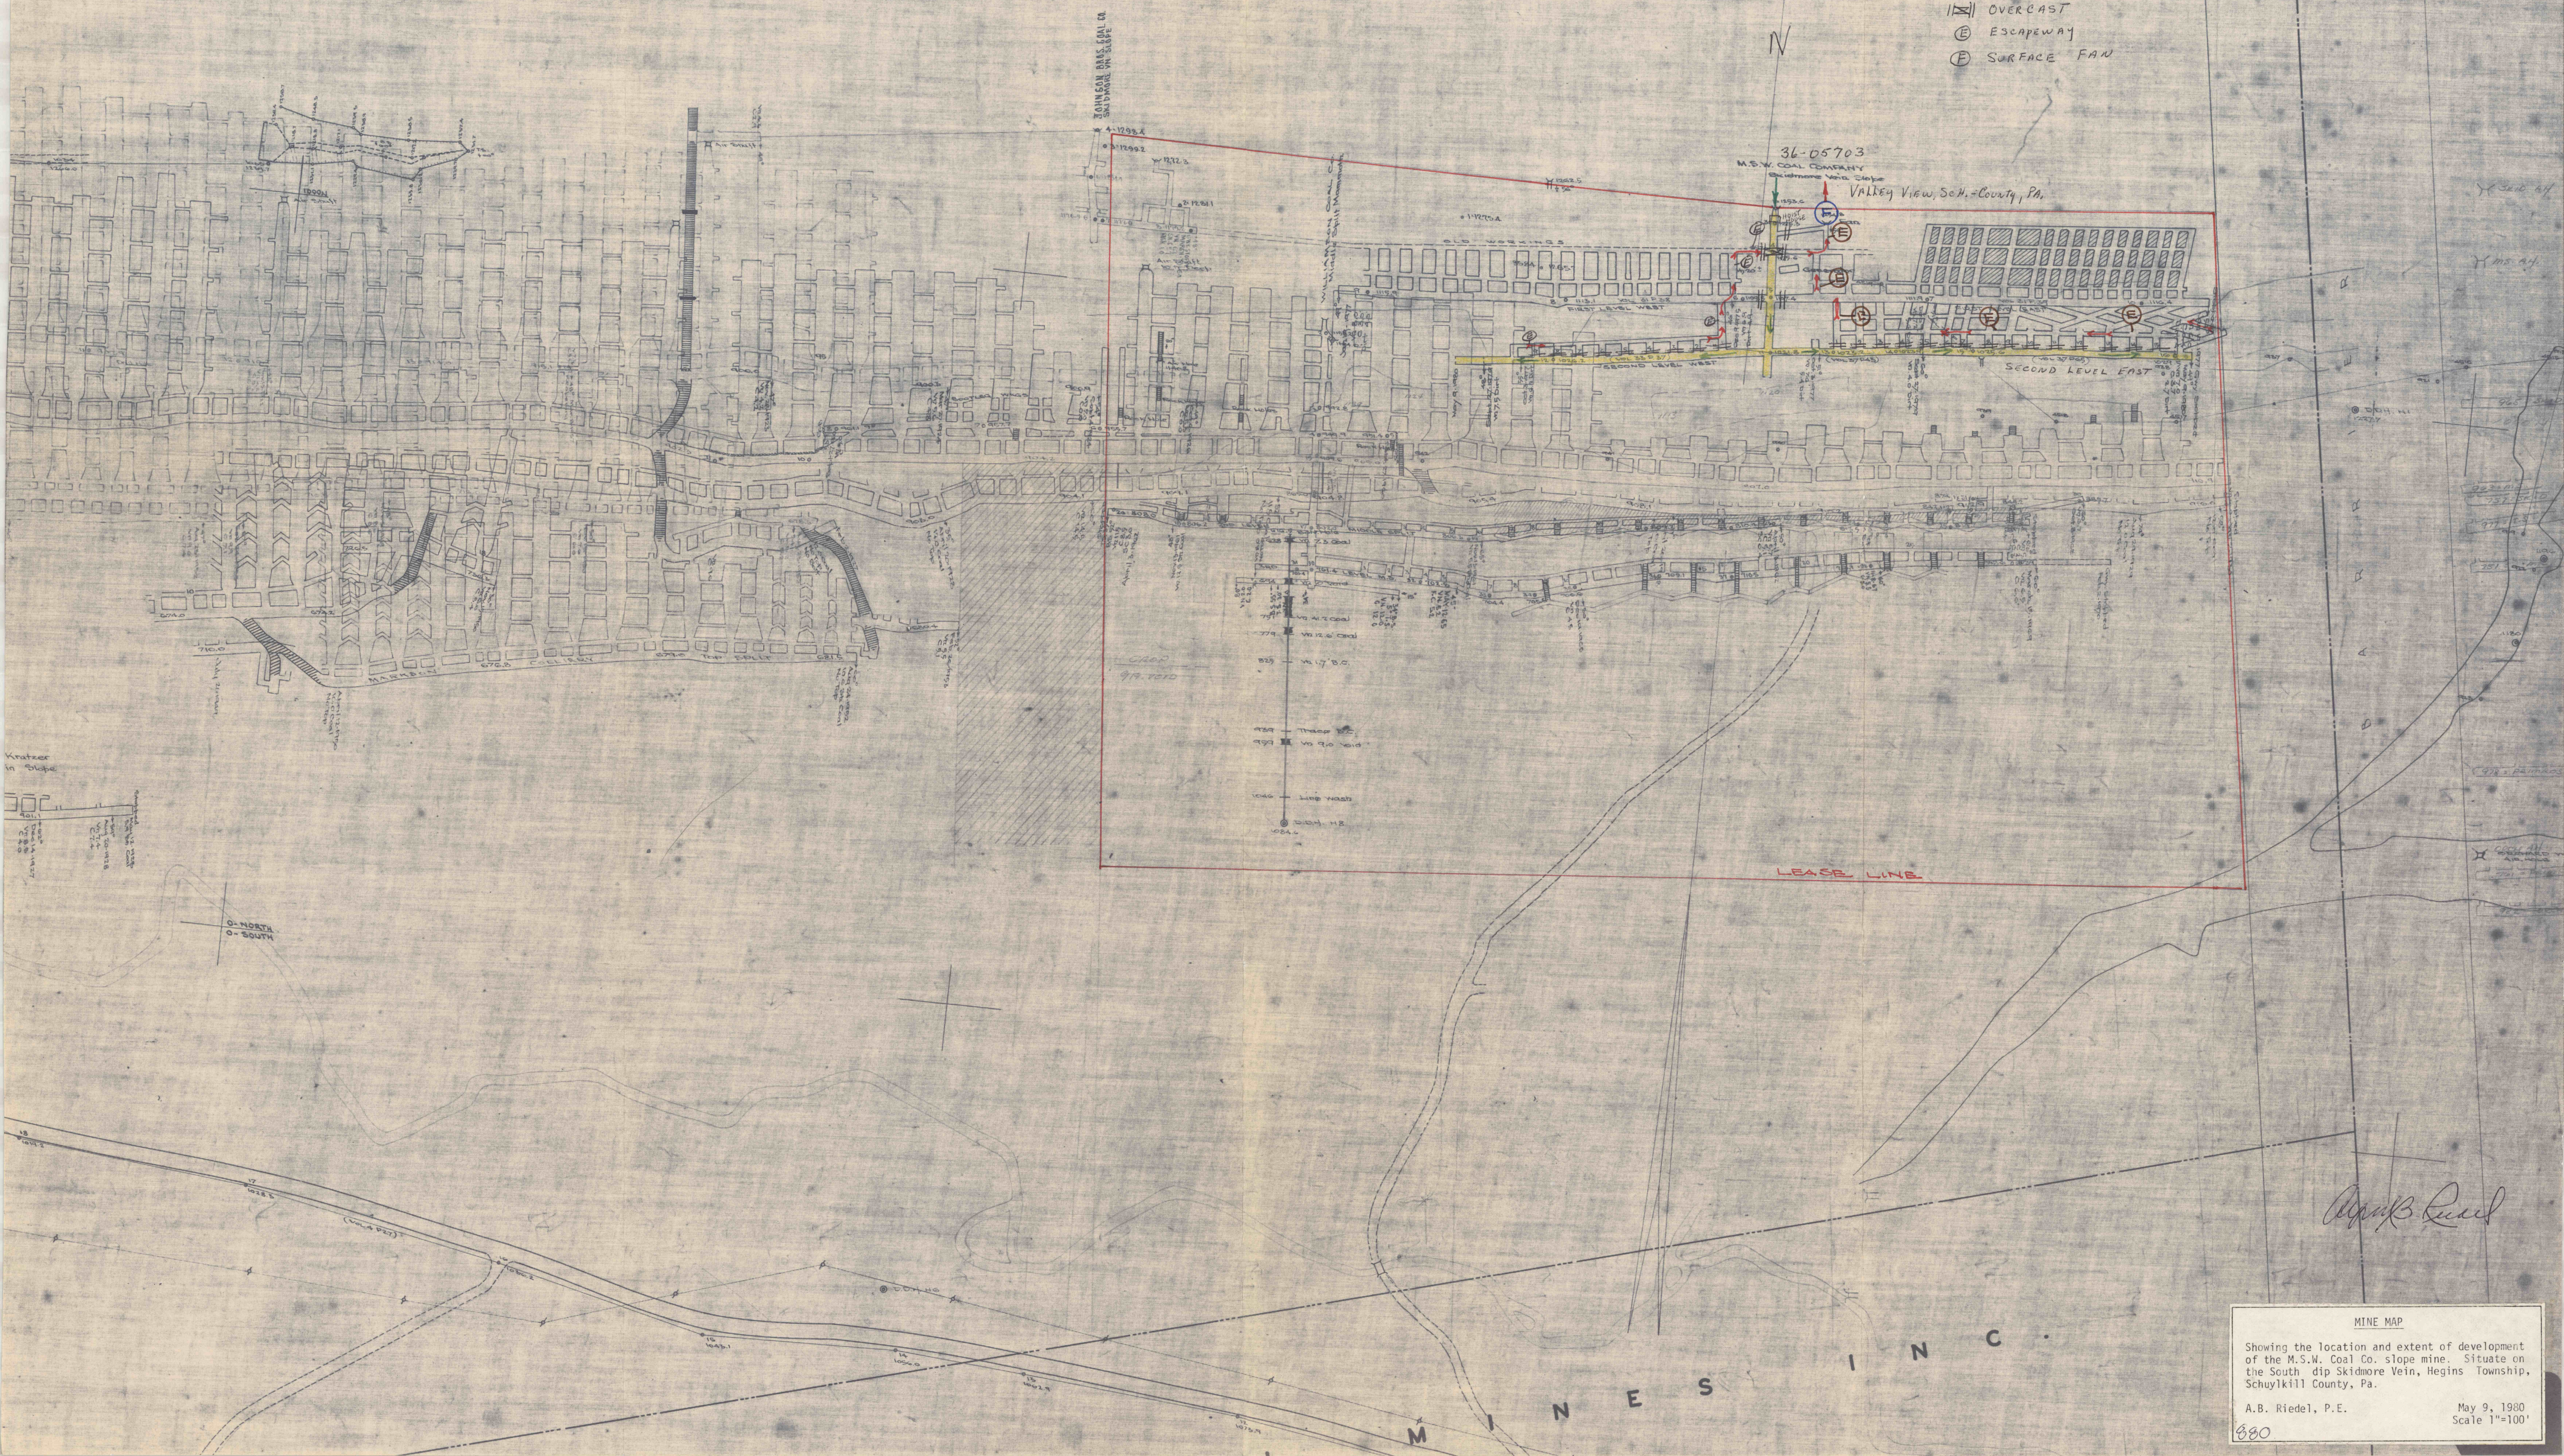

MINE MAP

Showing the location and extent of development of the M.S.W. Coal Co. slope mine. Situate on the South dip Skidmore Vein, Hegins Township, Schuylkill County, Pa.

A.B. Riedel, P.E.

May 9, 1980
Scale 1"=100'

