



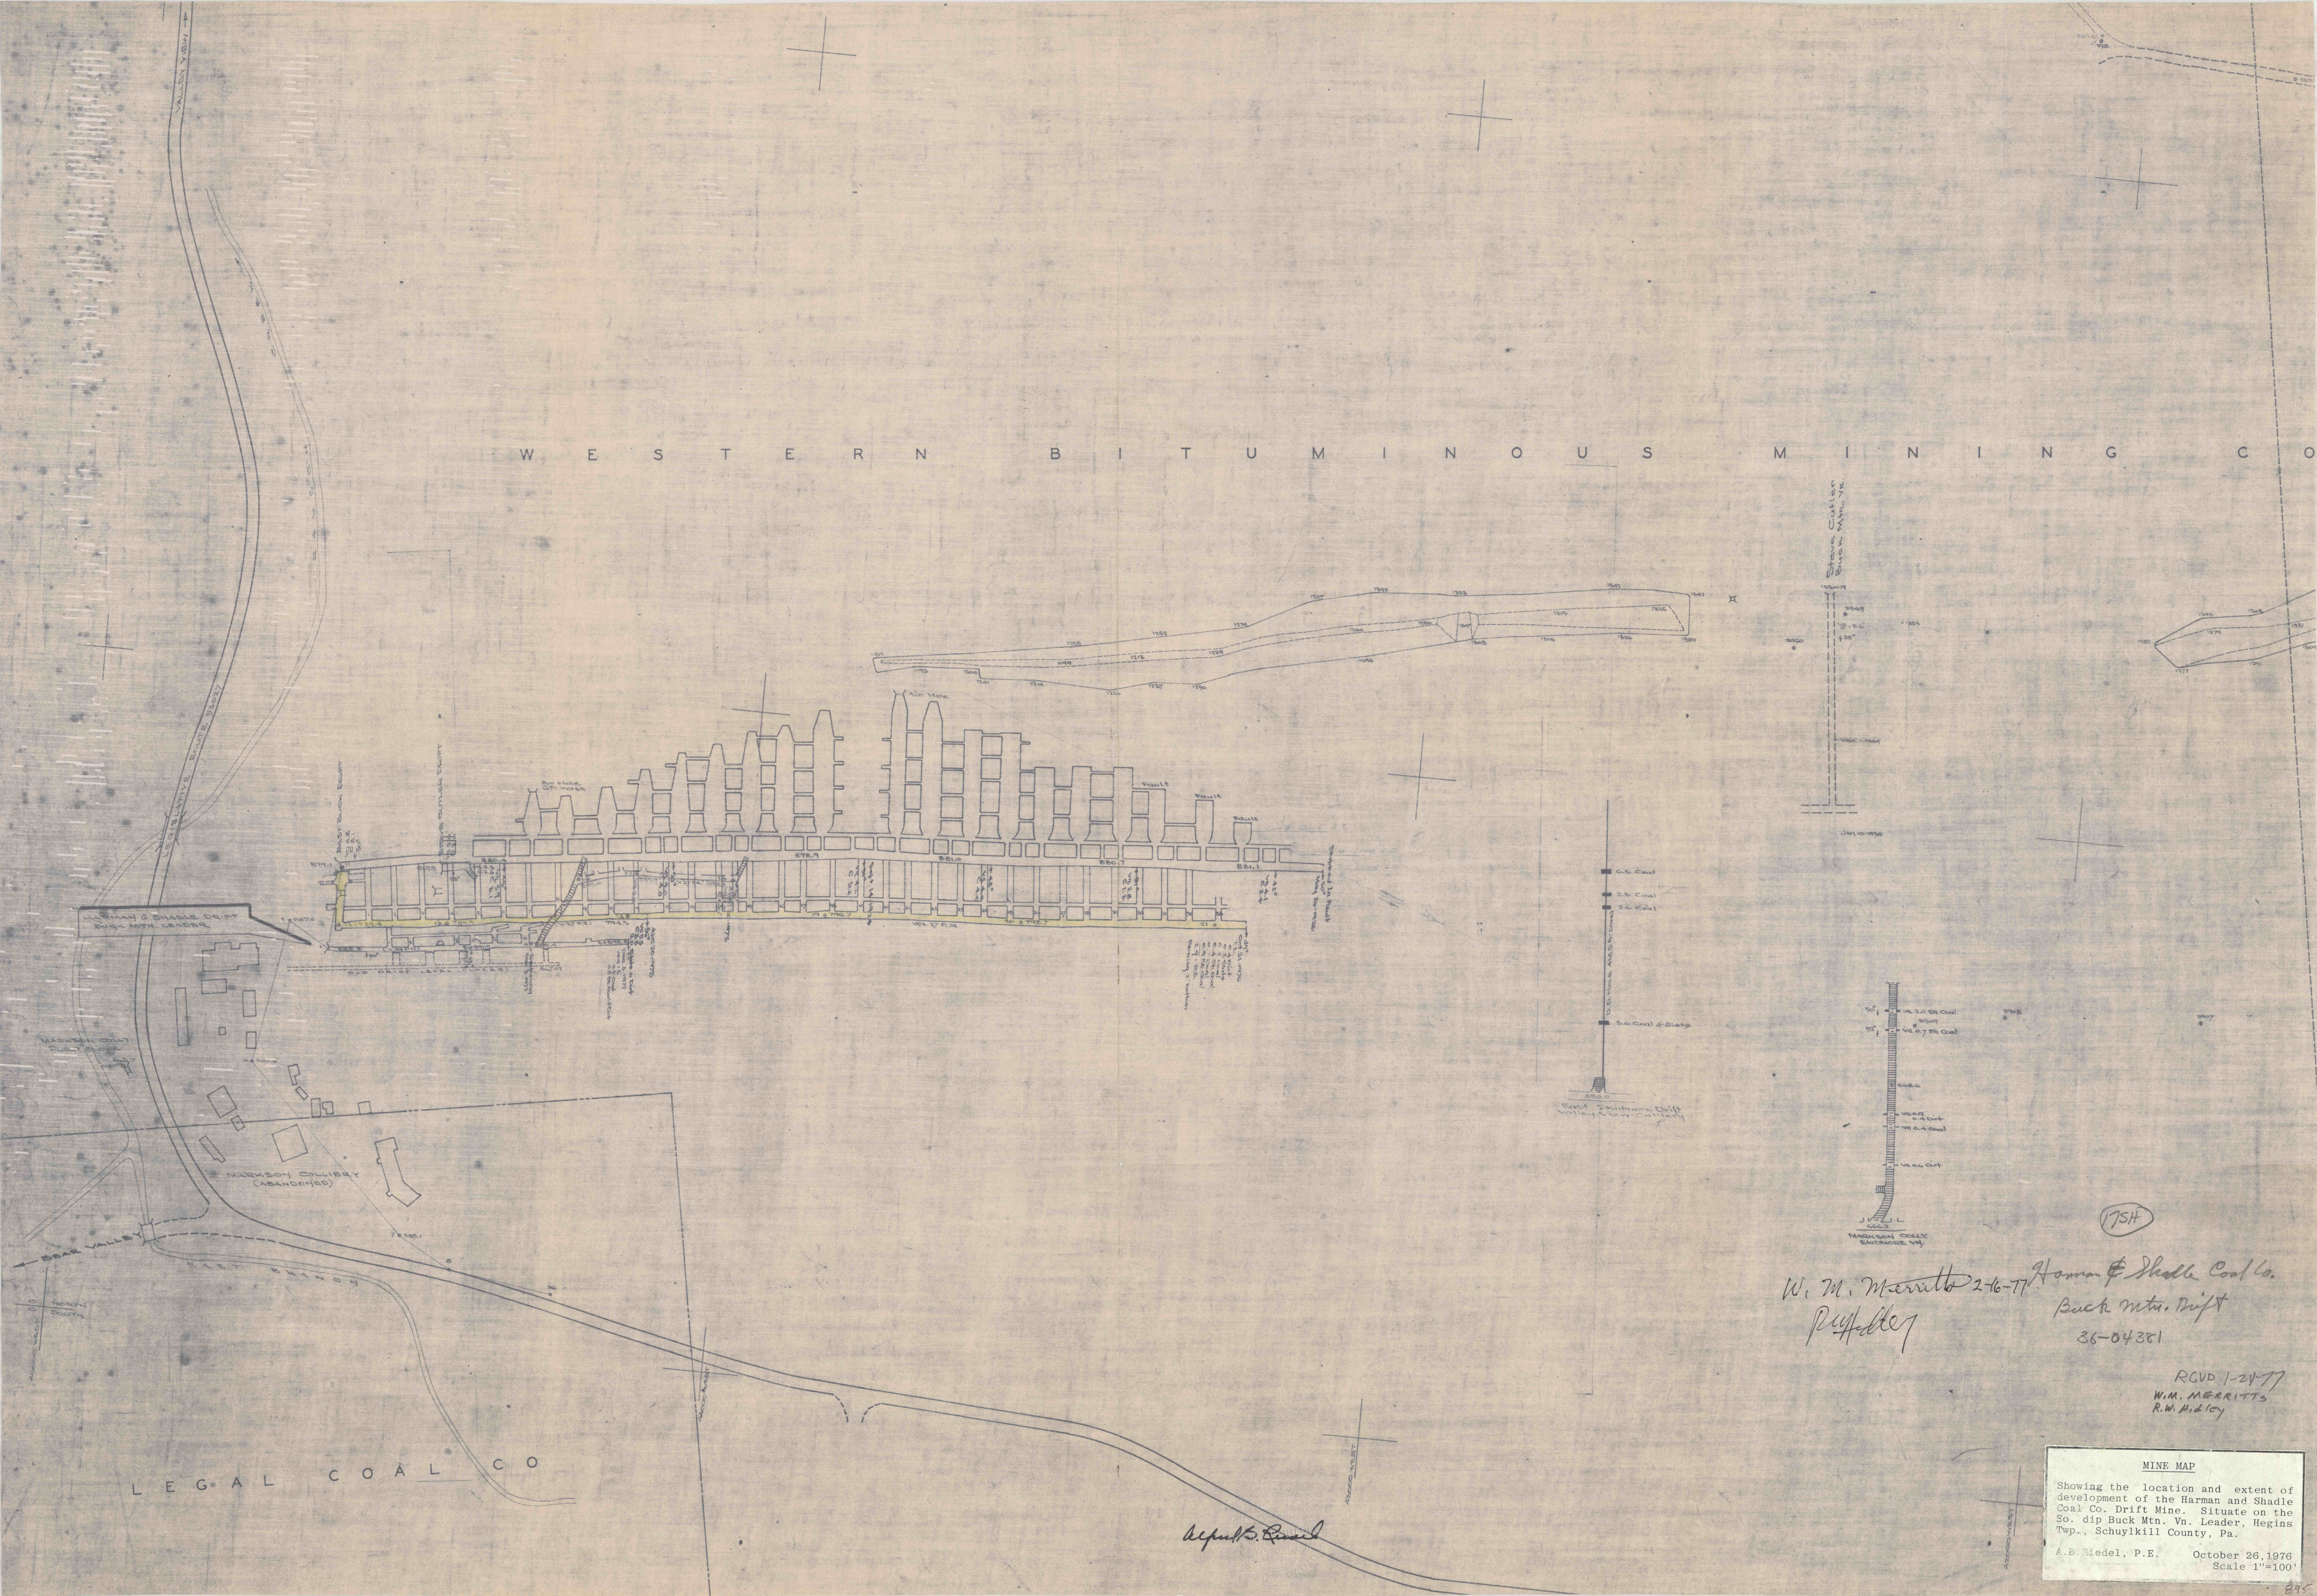

W. M. Merritts 2-6-77
Payoff Key
Harman & Shadle Coal Co.
Buck mtn. Drift
36-04381

RGVD 1-24-77
W.M. MERRITTS
R.W. Hickey

MINE MAP
Showing the location and extent of
development of the Harman and Shadle
Coal Co. Drift Mine. Situate on the
So. dip Buck Mtn. Vn. Leader, Hegins
Twp., Schuylkill County, Pa.
A.B. Biedel, P.E. October 26, 1976
Scale 1"=100'