



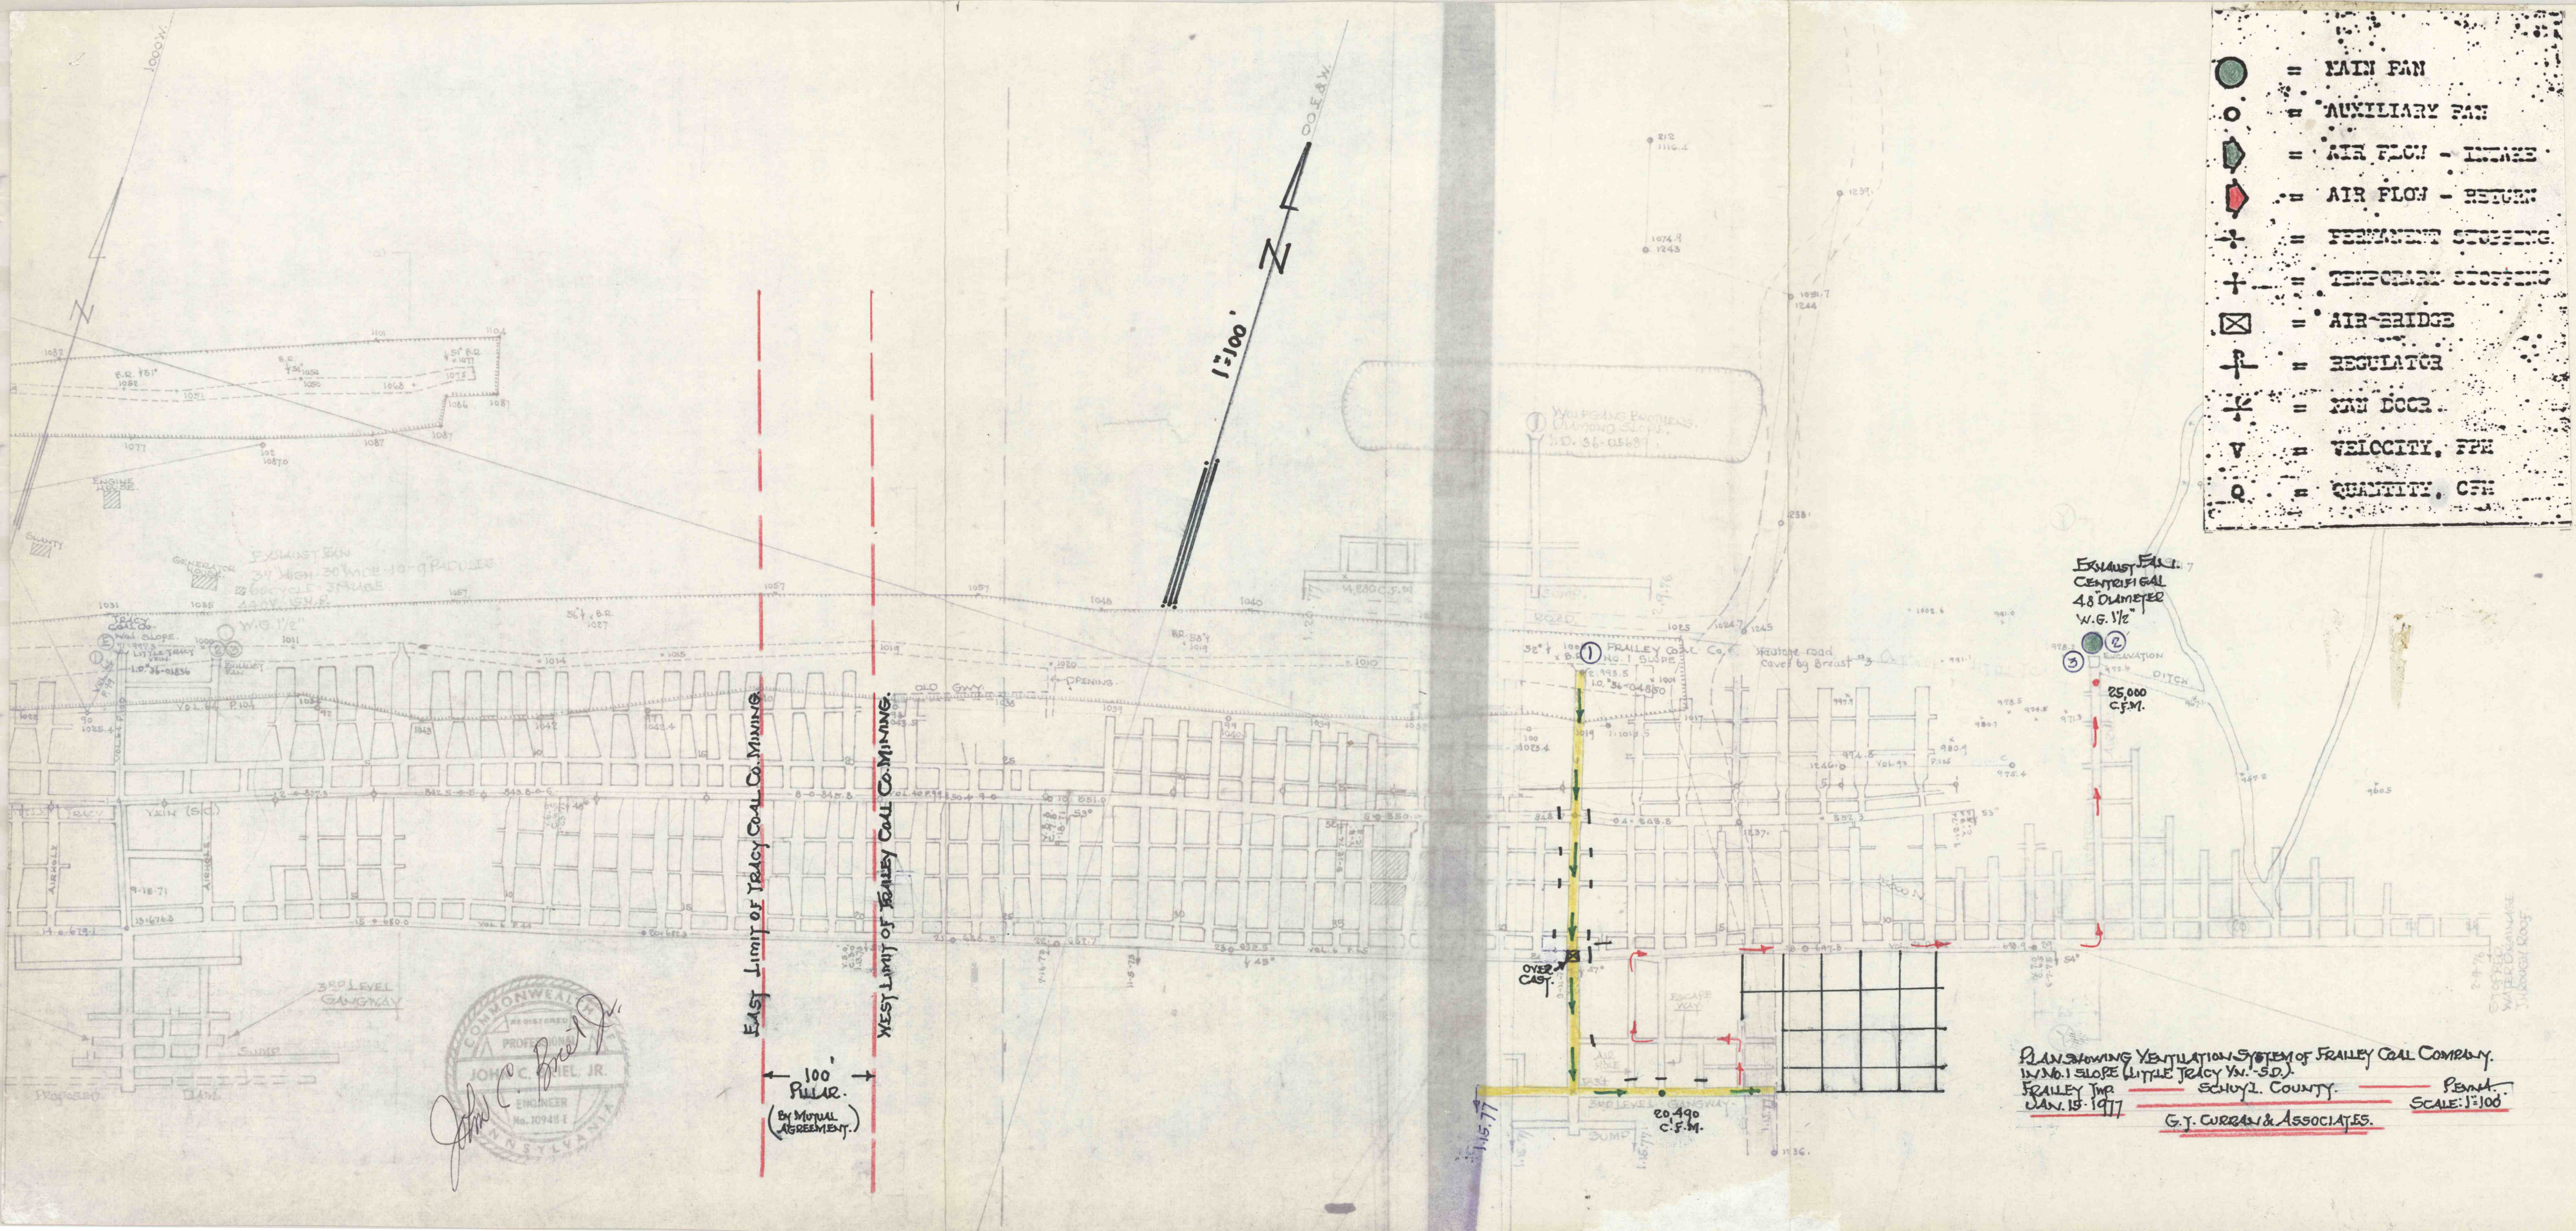

- = MAIN FAN
- = AUXILIARY FAN
- = AIR FLOW - INTAKE
- ← = AIR FLOW - RETURN
- + = PERMANENT STOPPING
- + = TEMPORARY STOPPING
- ⊠ = AIR BRIDGE
- ⊥ = REGULATOR
- ⋈ = MAIN DOOR
- V = VELOCITY, FPM
- Q = QUANTITY, CFM

EXHAUST FAN
 CENTRIFUGAL
 48" DIAMETER
 W.G. 1/2"
 25,000 C.F.M.
 20,490 C.F.M.
 PLAN SHOWING VENTILATION SYSTEM OF FRAILEY COAL COMPANY.
 IN NO. 1 SLOPE (LITTLE TRACY M. S.D.).
 FRAILEY TWP. SCHUYLER COUNTY, PENN.
 JAN. 15, 1977
 G.Y. CURRAN & ASSOCIATES. SCALE: 1"=100'

W. M. Merrill 3-28-77
 Ruffley 3-28-77

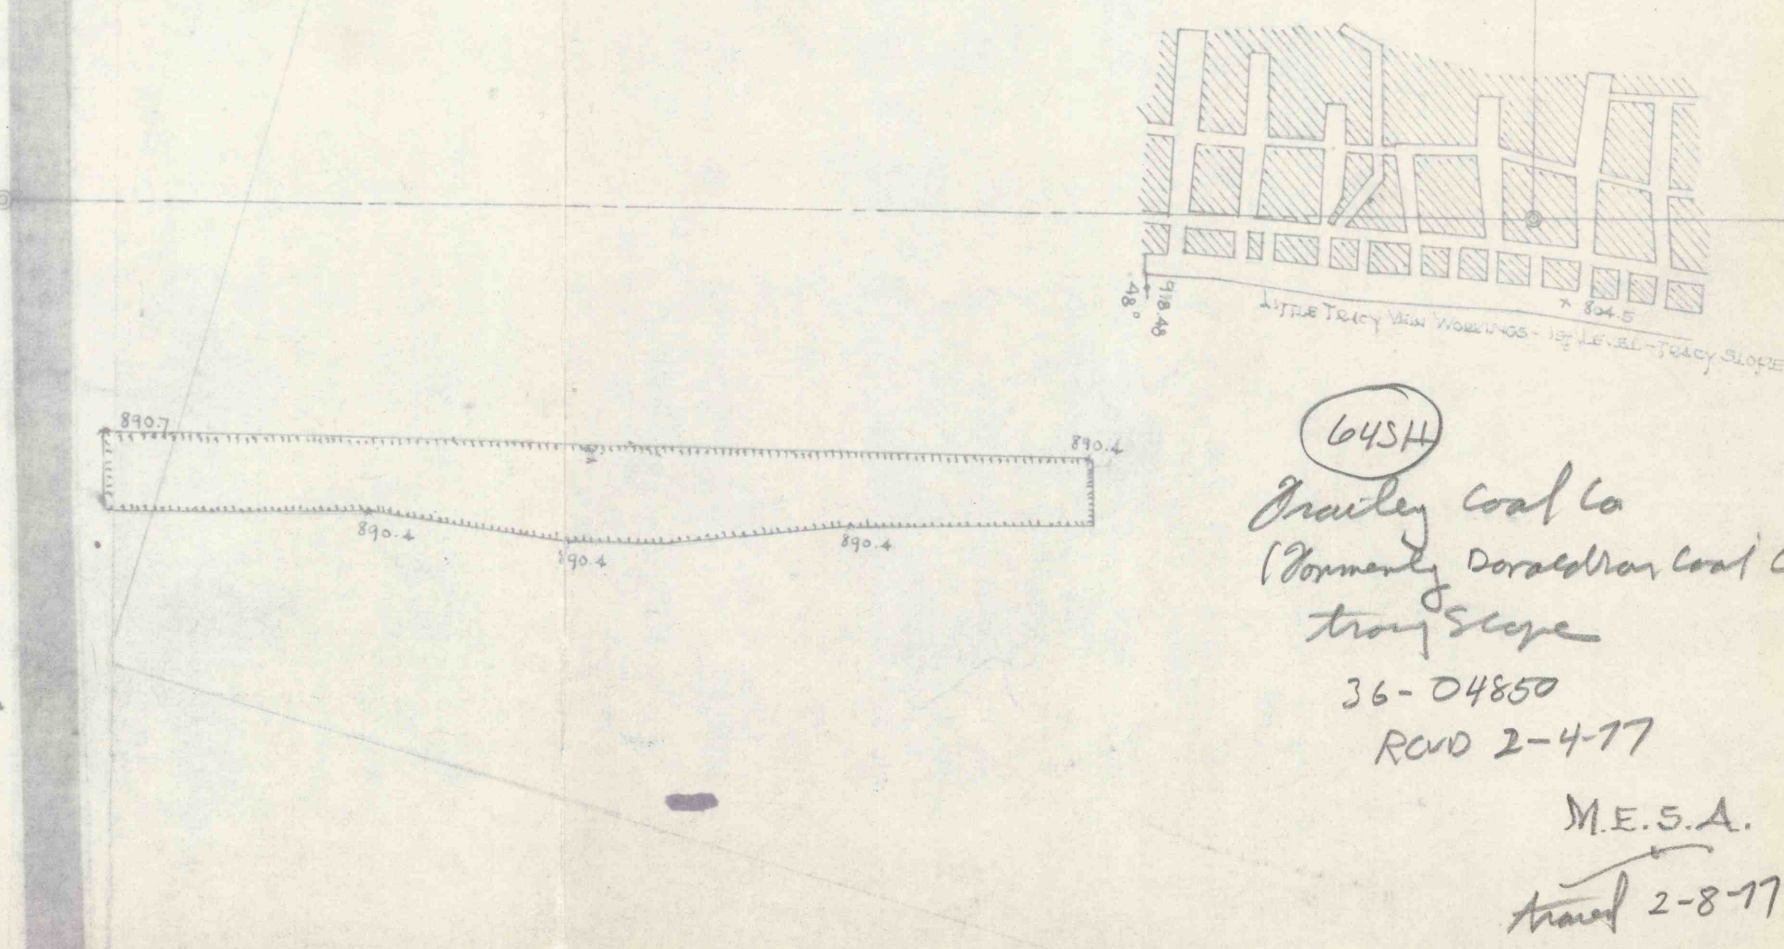

645H
 Frailey Coal Co
 (Formerly Doradon Coal Co)
 Tracy Slope
 36-04850
 RCD 2-4-77
 M.E.S.A.
 dated 2-8-77