


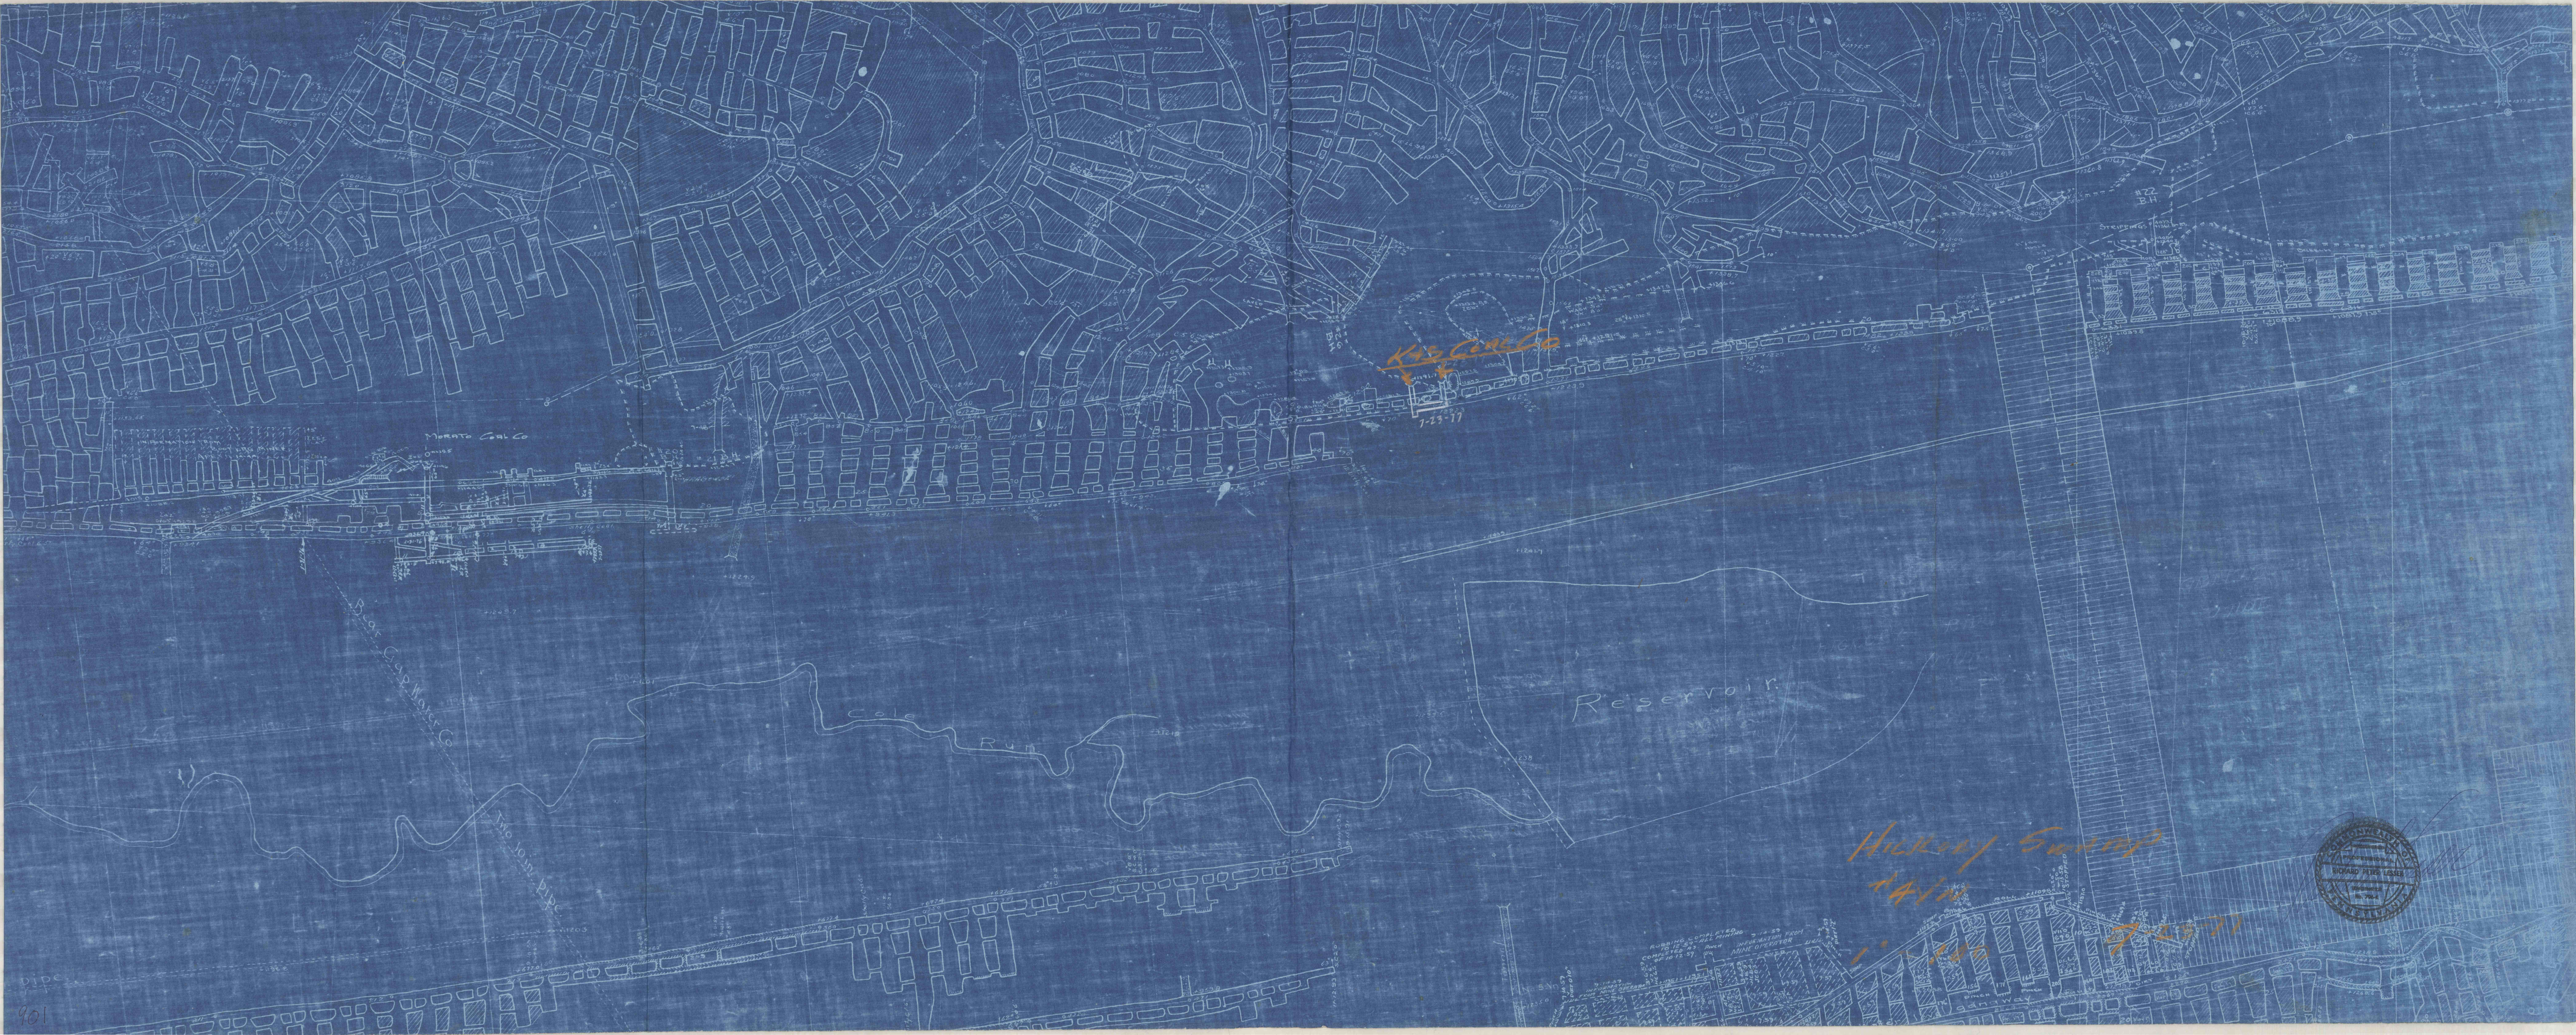


KID CONCO

1-23-77

HICKORY SWAMP

1-23-77

7-23-77

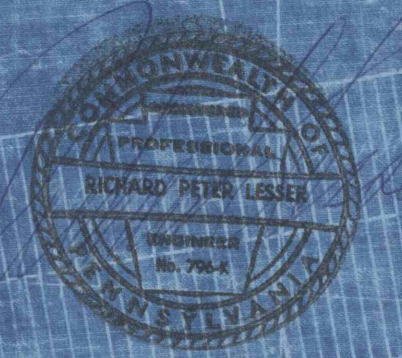

ROBING COMPLETED
INFORMATION FROM
MINE OPERATOR