



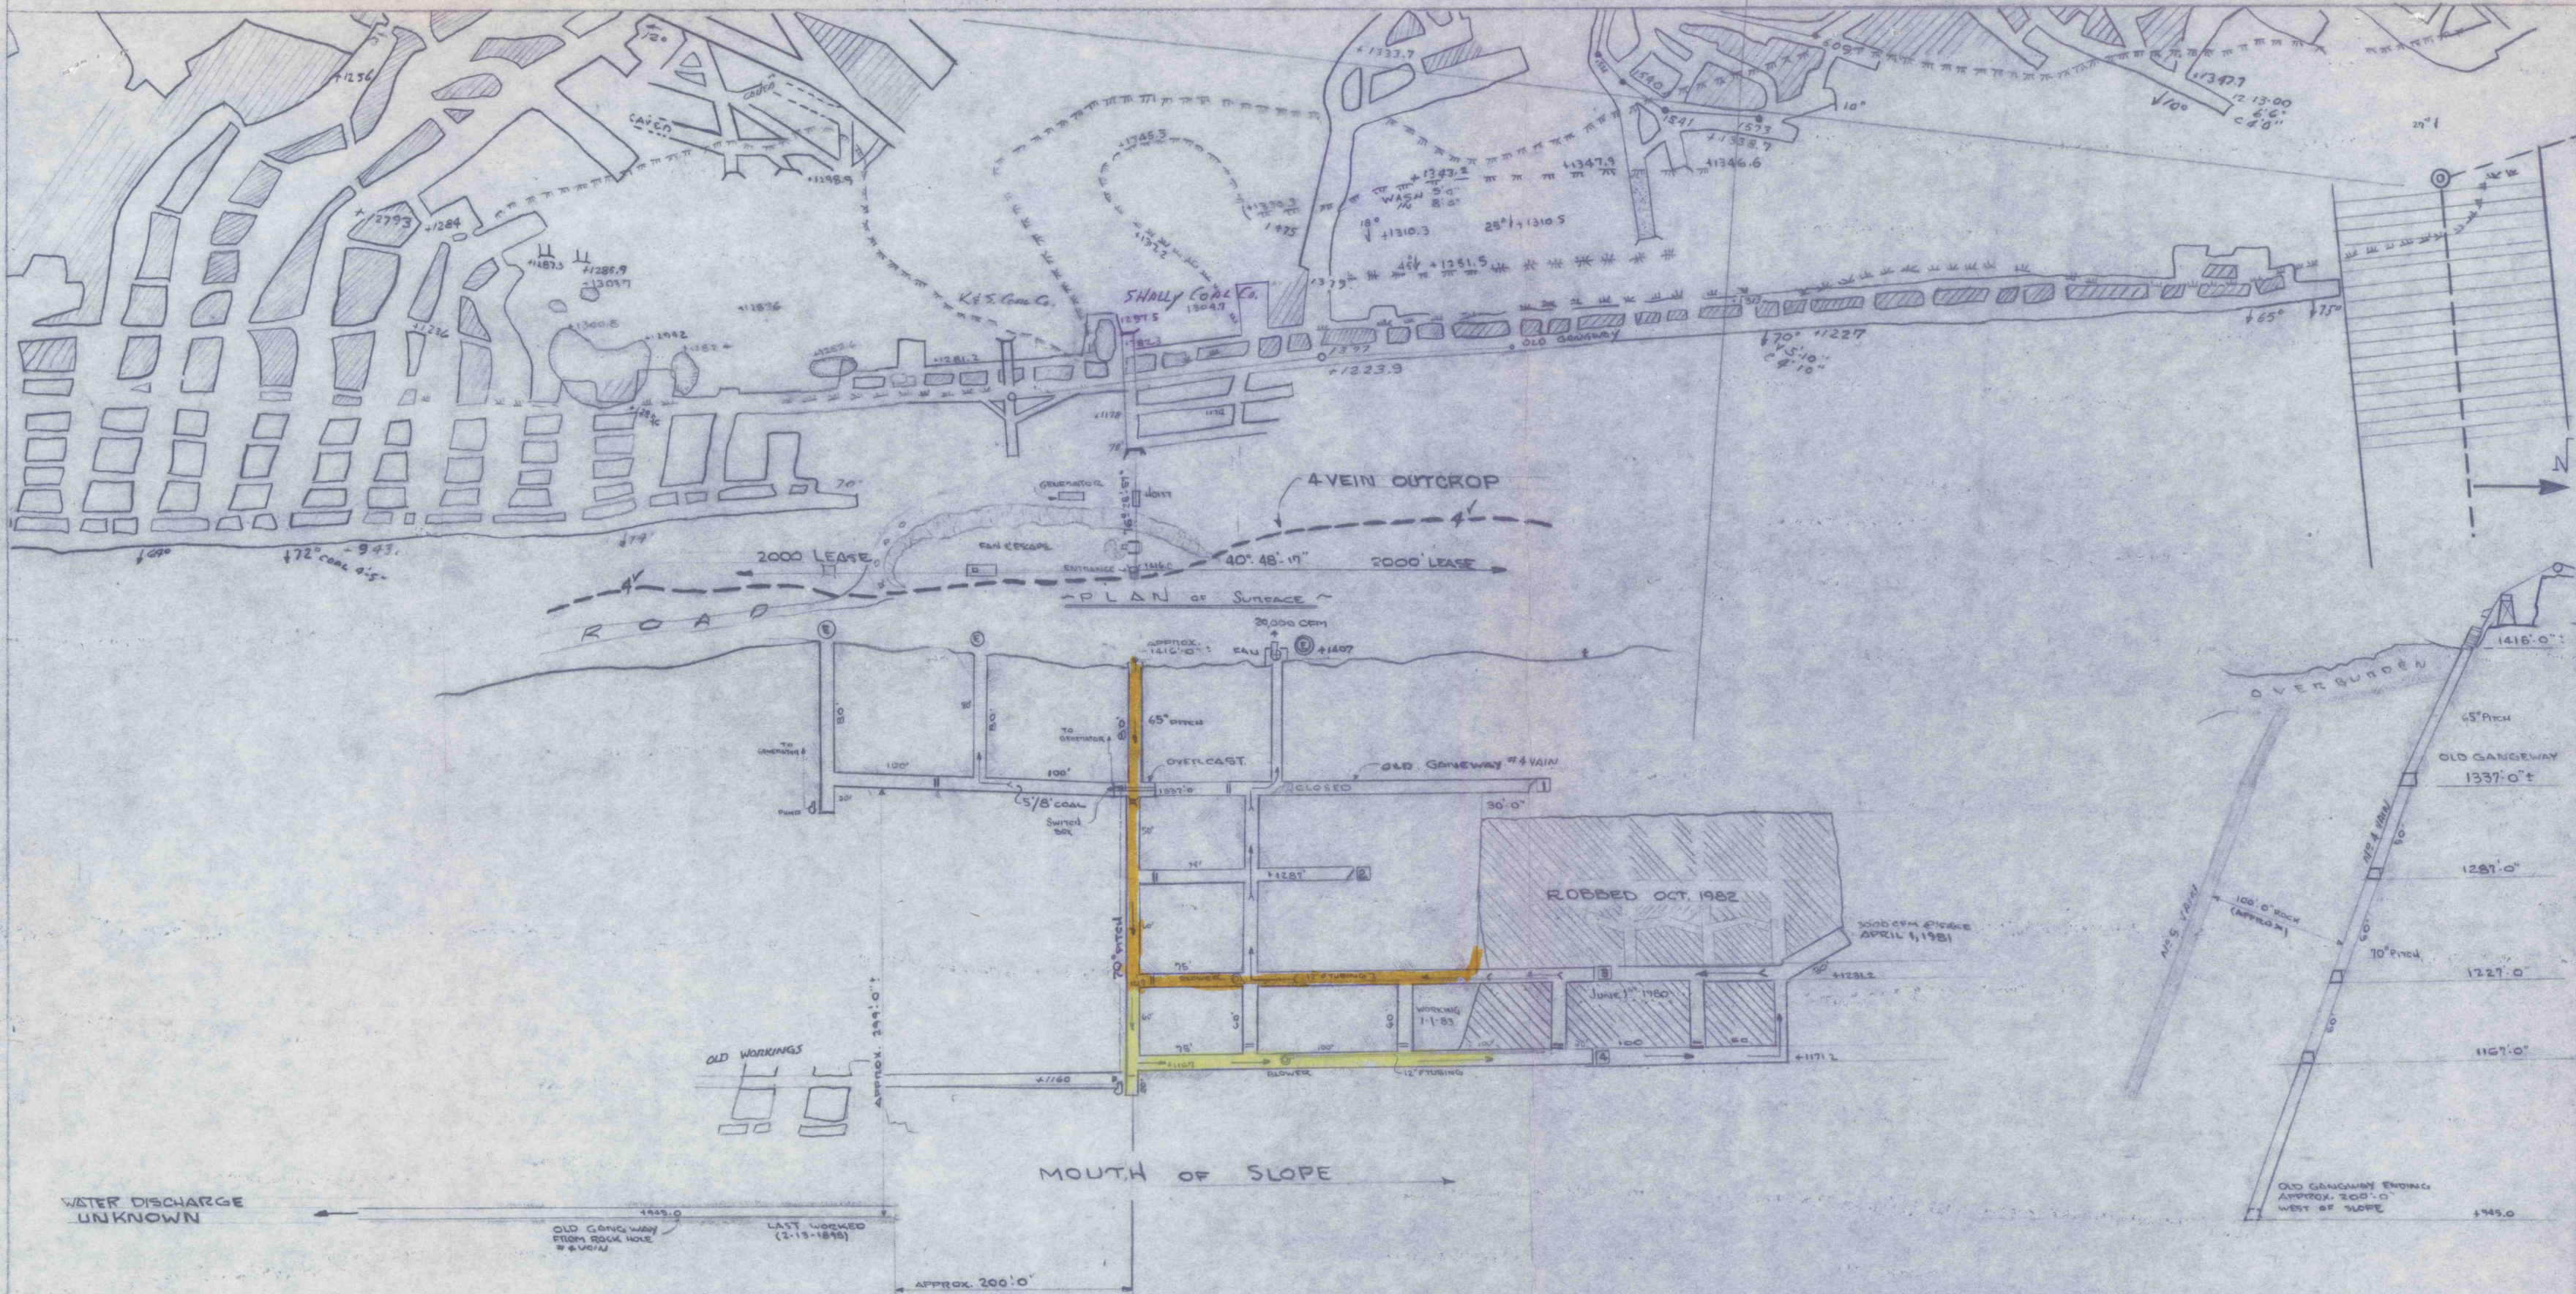

JOE SHALAMAMDA COAL CO.  
 ID No 3604866  
 #4 VEIN SLOPE  
 SAGON  
 MT. CARMEL TWP.  
 NORTH'D COUNTY PA.  
 SCALE 1"=100' 0"

### ~LEGEND~

- ⊕ MAIN FAN
- INTAKE AIR
- RETURN AIR
- = PERMANENT STOPPING
- TEMPORARY STOPPING
- BRATTICE
- ⊕ ESCAPEWAY RETURN AIR WAY
- ⊕ ESCAPEWAY INTAKE AIR
- ⊕ OVERCAST

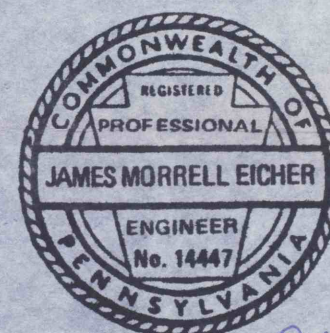

*James M Eicher*  
 12/30/1982

# EXHIBIT - B

#C-115903