


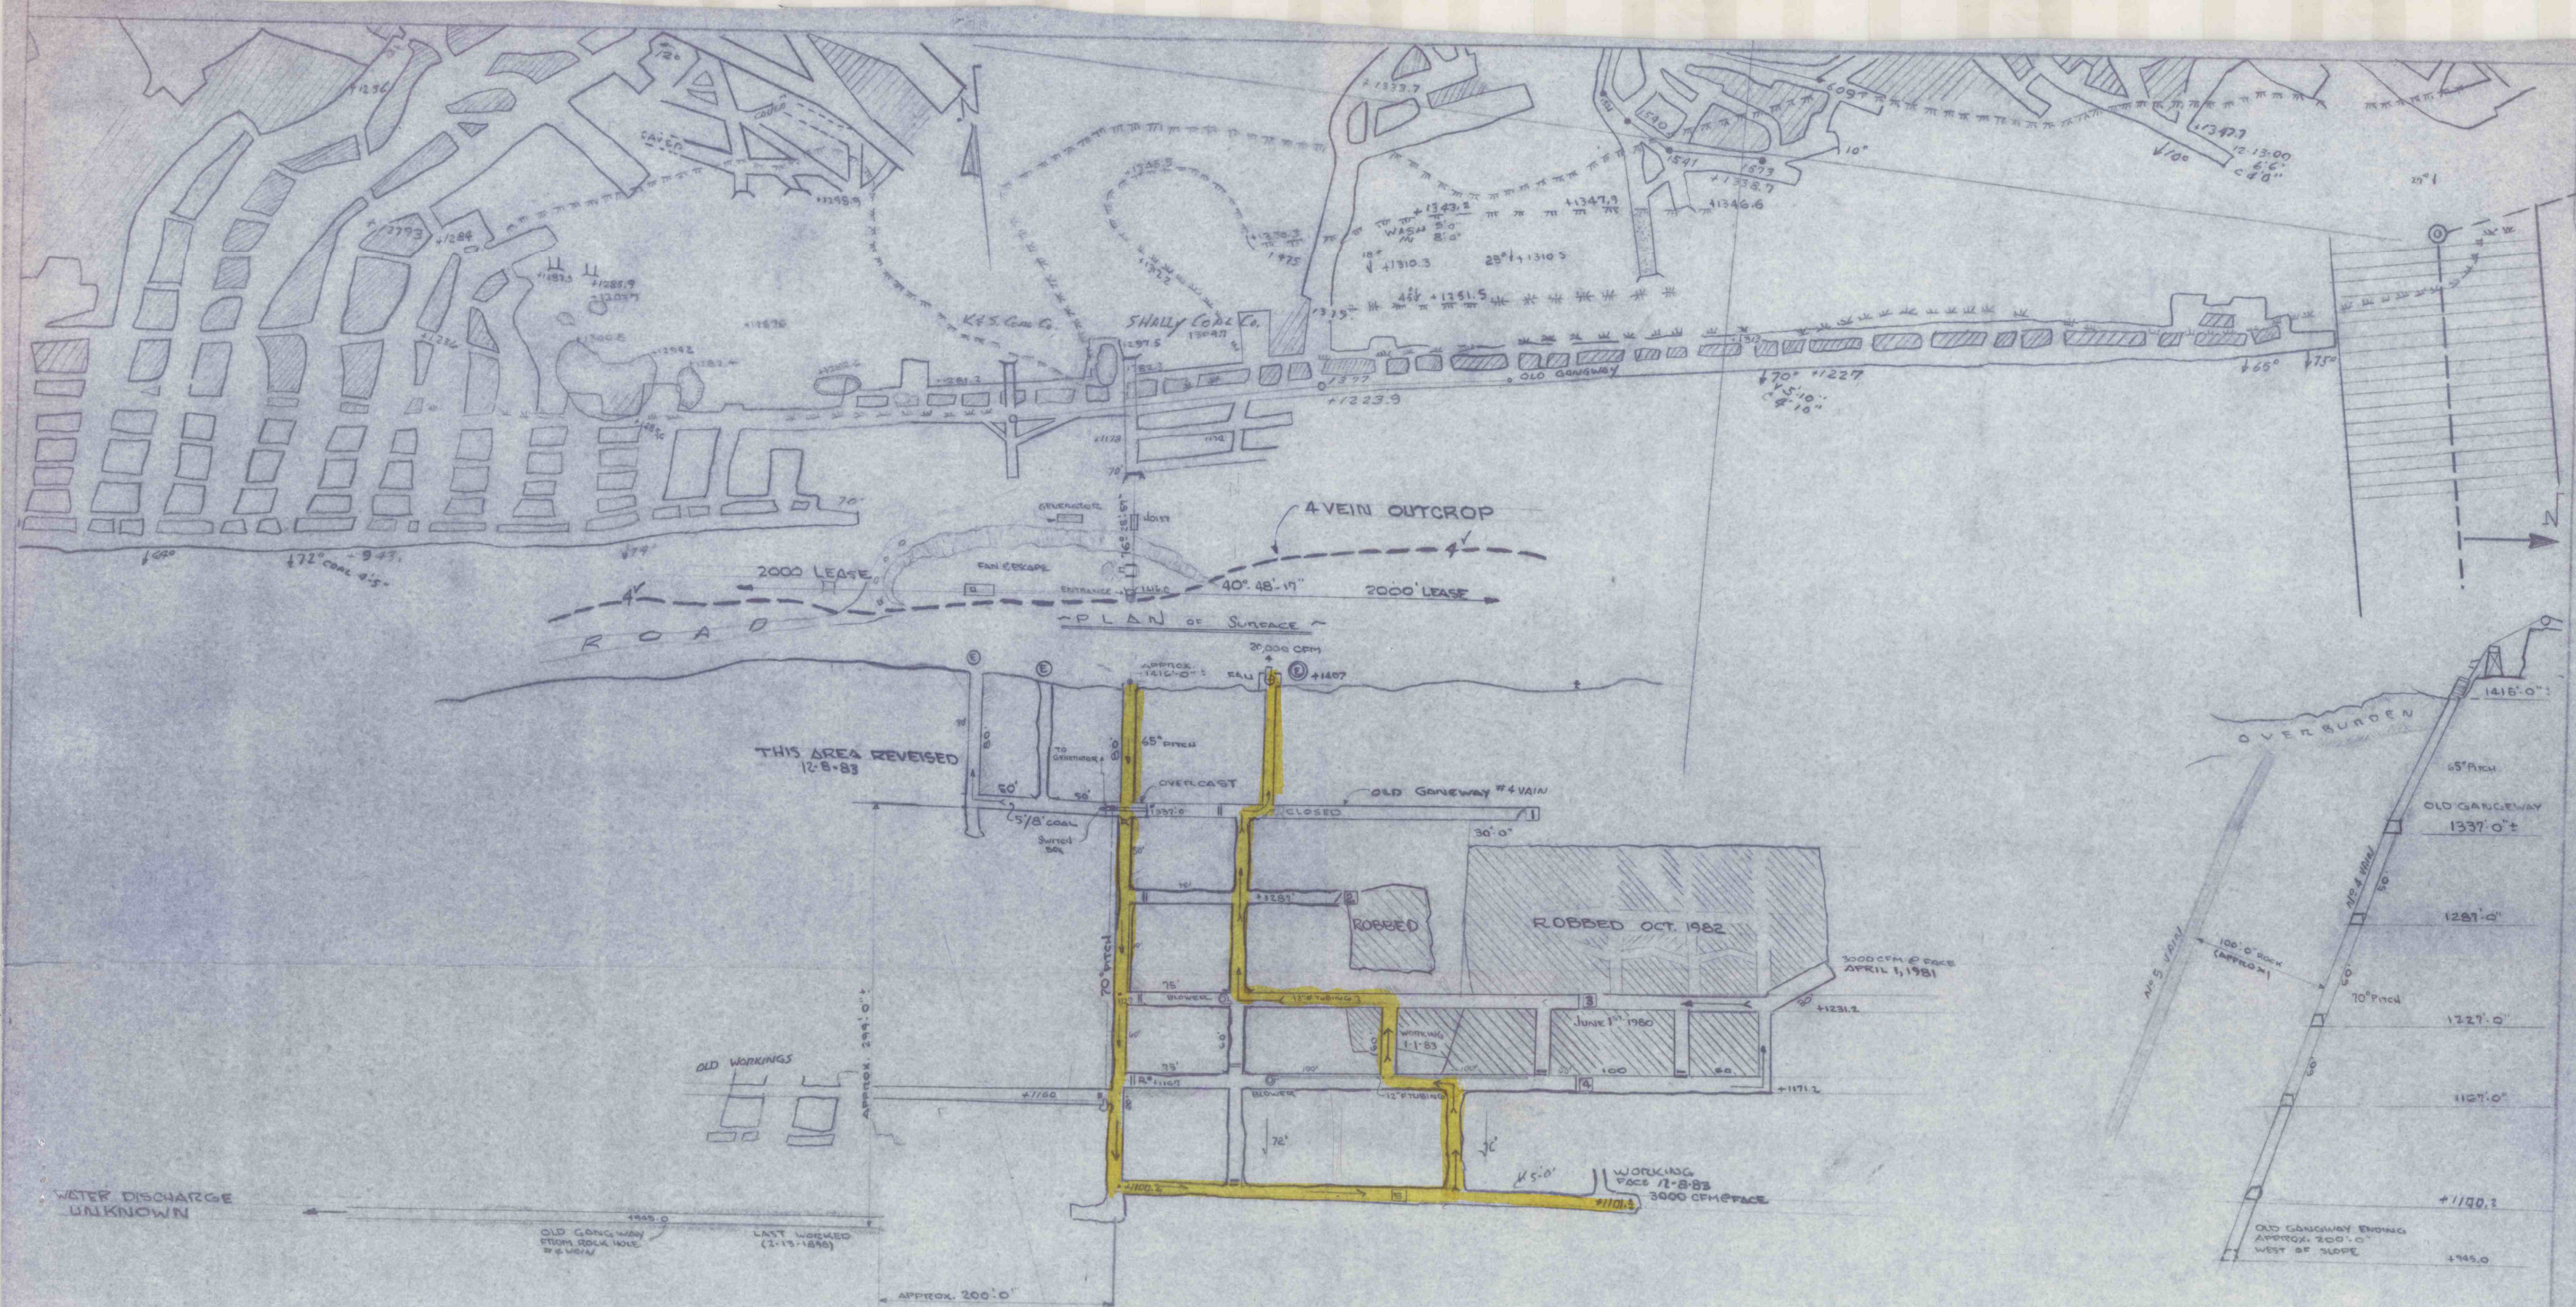

JOE SHALAMAMDA COAL CO.
 ID NO 3604866
 #4 VEIN SLOPE
 SAGON
 MT CARMEL TWP.
 NORTH'D COUNTY PA.
 SCALE 1"=100'-0"

~LEGEND~

- ⊕ MAIN FAN
- INTAKE AIR
- RETURN AIR
- = PERMANENT STOPPING
- TEMPORARY STOPPING
- BRATTICE
- ⊙ ESCAPEWAY RETURN AIR WAY
- ⊙ ESCAPEWAY INTAKE AIR
- ⌘ OVER CAST

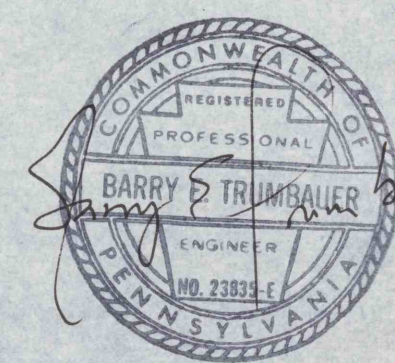


EXHIBIT - B