



3,510 H

ADIRACK

ZUNES

ZUNES

HUNES

HECKER CONSTRUCTION CO LANDS

LYNETT LANDS

ZUNES


711
1446.2

712
1459.7

713
1466.7

1458.7


1472.9

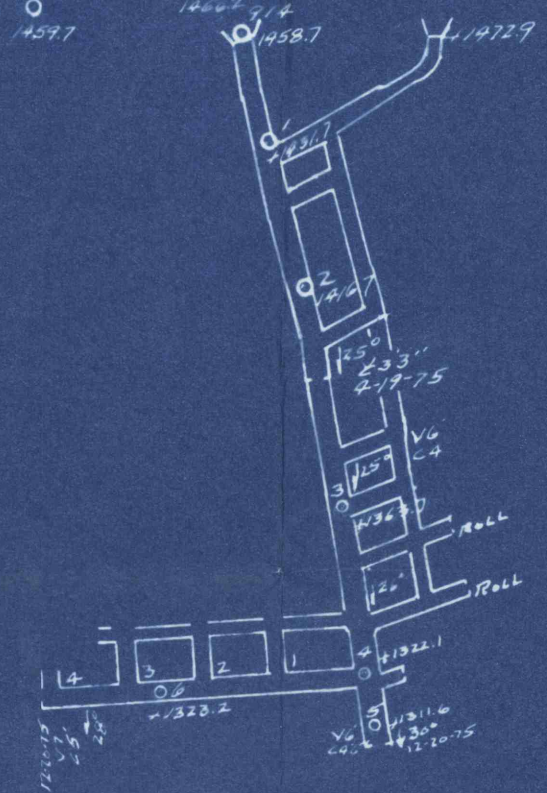

LEHIGH VALLEY RAILROAD

SE 15

SE 15

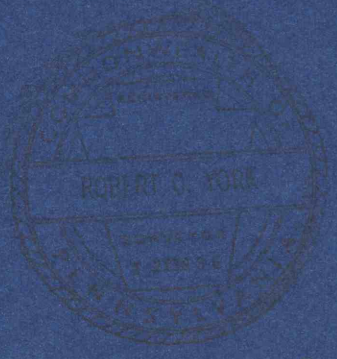

W. A. McRITT

WOLFGANG BROTHERS SLOPE
BUCK VEIN
ABANDONED LOGAN MINE WORKINGS
CONYNGHAM TOWNSHIP
SOLUMBER COUNTY
PENNSYLVANIA

TO MT. CARMEL

ROUTE #61

Scale 1"=100'
4-19-75
12-26-75