


SHADE COAL COMPANY
BUCK MOUNTAIN VEIN SLOPE

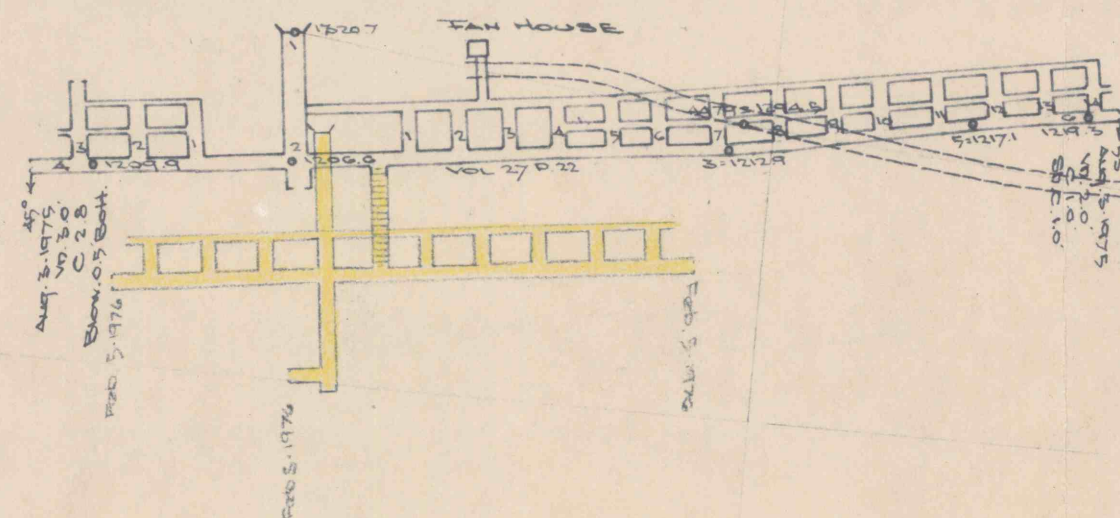

1902
KIMMEL & SCHWARTZ

0. North
0. South

HAW NO 2 SLOPE
1114.1

HAW NO 1 SLOPE
1118.3

SEIDER
1108.2

DAKWAY ANTHRACITE
1020.5

DANIEL MESSERMITH TRACT

(82) 36-05222
SH

5500 West

BEAR VALLEY ROAD

5200 West

1000 South

A. B. Riedel

MINE MAP

Showing the location and extent of development (as reported by the Operator) of the Shade Coal Company Slope Mine. Situate on the South dip Buck Mountain Veins, Hegins Twp., Schuylkill County, Pennsylvania.

A. B. Riedel, P. E.

Feb. 5, 1976
Scale 1"=100'

W. M. MERRITT