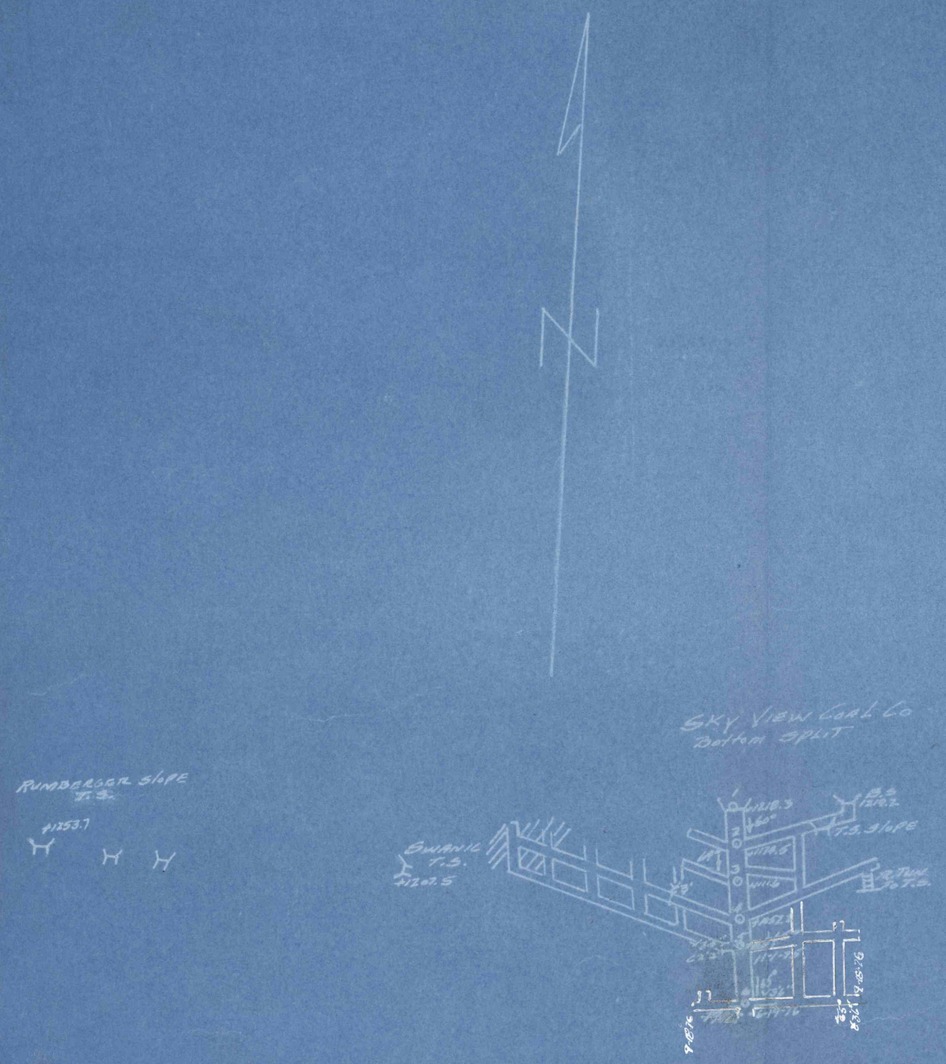
SKY VIEW COAL CO
Bottom Split
RUMBARGER SLOPE
T.S.
#1253.7
SWANN'S
T.S.
#1202.5
T.S. SLOPE
