


NORTHUMBERLAND COUNTY
COLUMBIA



all sections showing Robbed,
mine abandoned
Roy Hamer, Partner

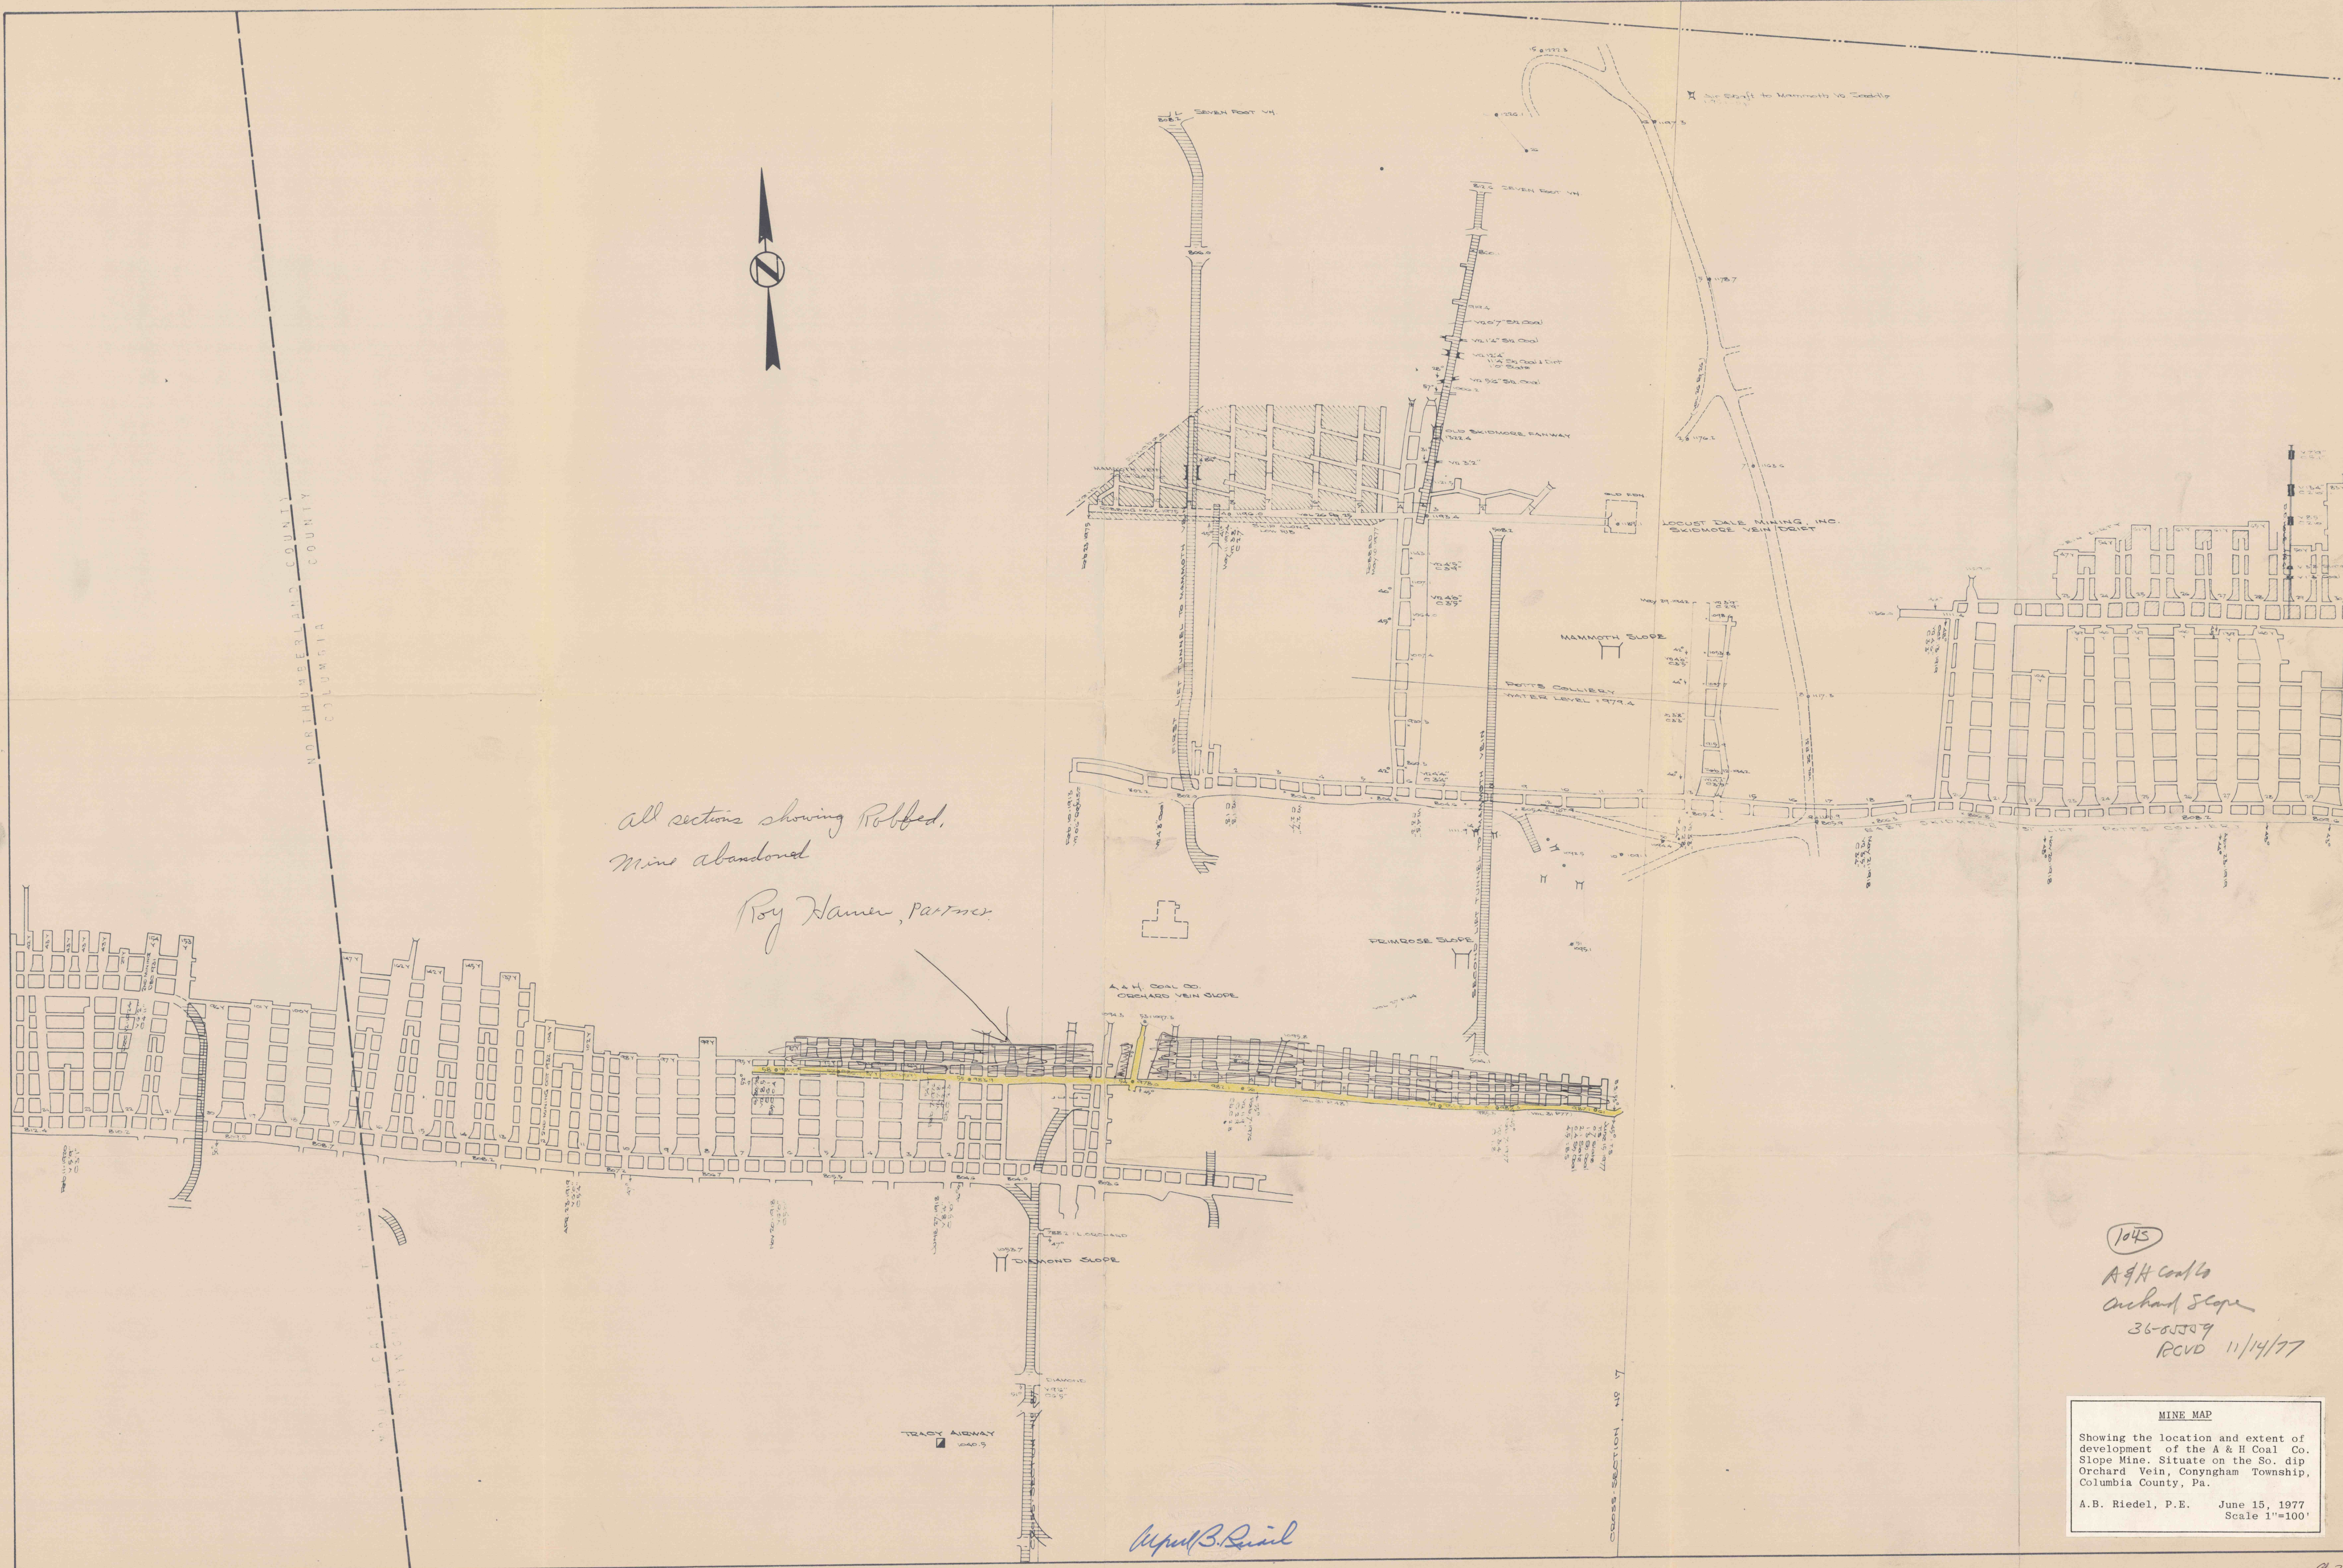

1045
A & H Coal Co
Orchard Slope
36-55599
RCVD 11/14/77

MINE MAP
Showing the location and extent of
development of the A & H Coal Co.
Slope Mine. Situate on the So. dip
Orchard Vein, Conyngham Township,
Columbia County, Pa.
A.B. Riedel, P.E. June 15, 1977
Scale 1"=100'