
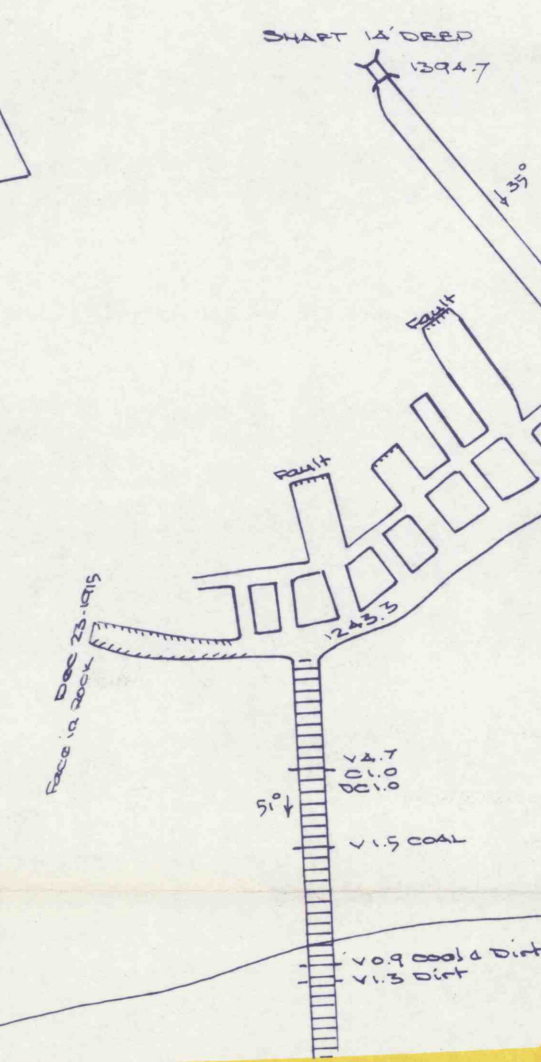


KILLMAN TRACT

BARBARA TRACT

HARTMAN AND MYER TRACT

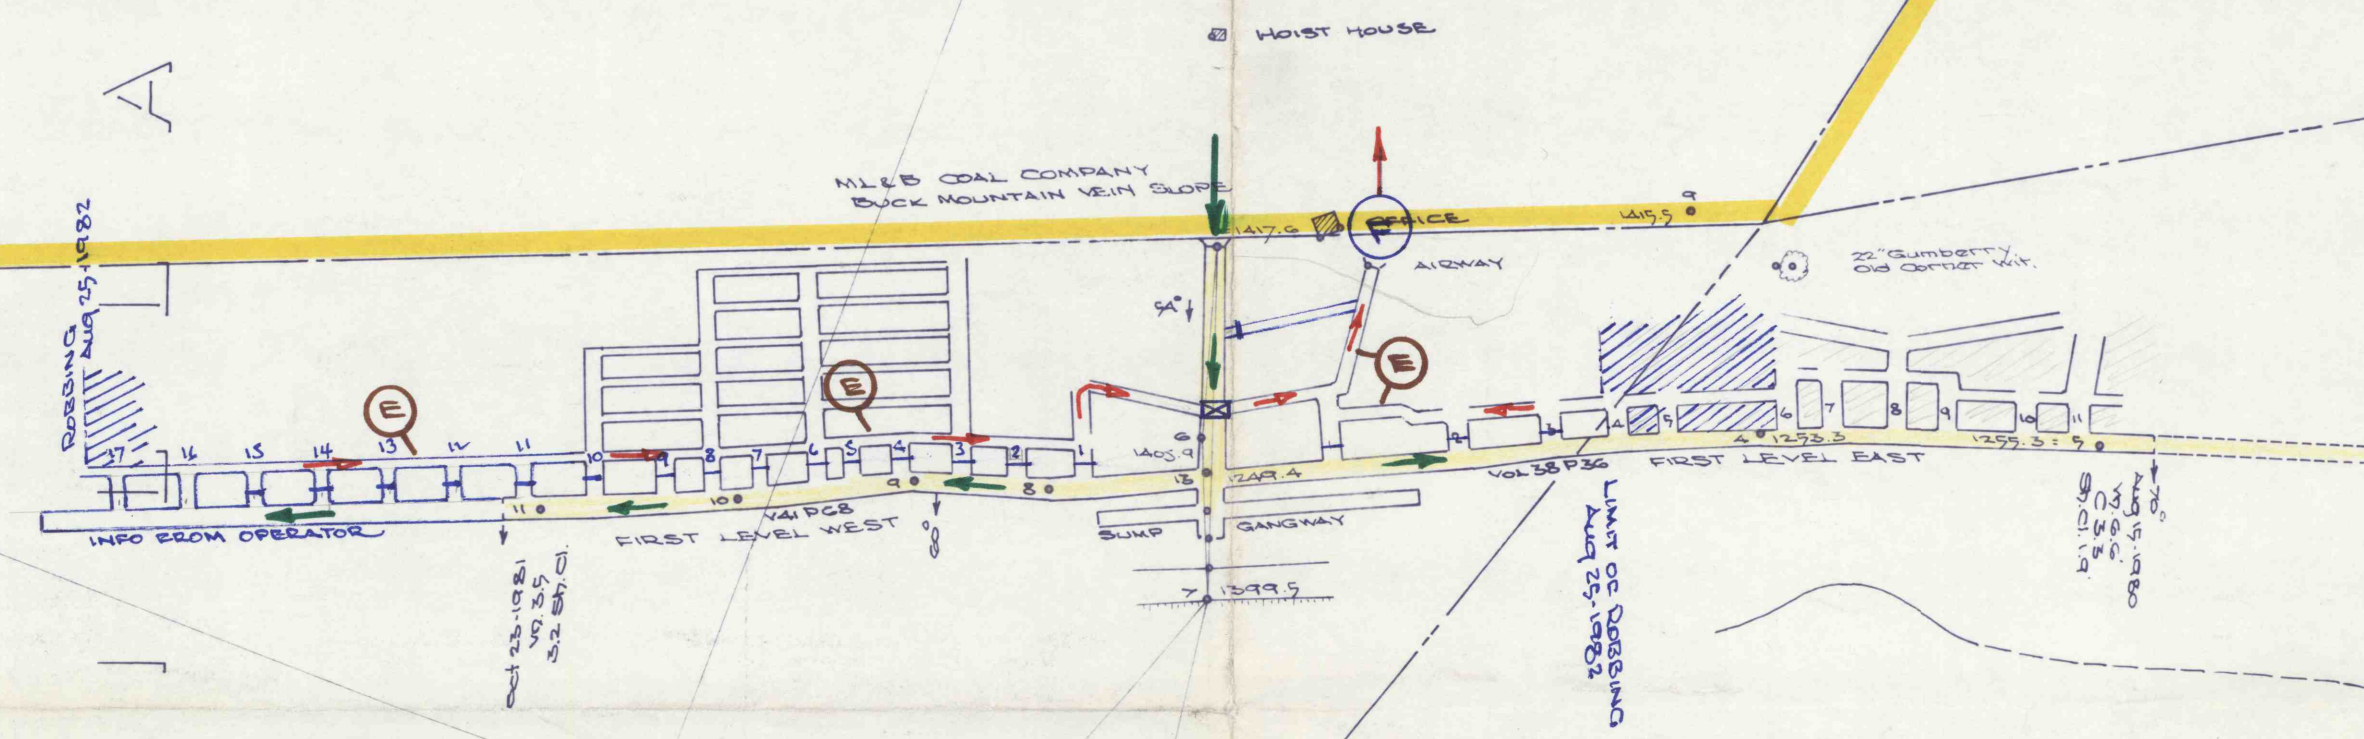

VENTILATION SYMBOLS	
(F) = Main Fan	⊞ = Air Bridge
(A) = Auxiliary Fan	⊞ = Regulator
→ = Air Flow - Intake	⊞ = Man Door
↗ = Air Flow - Exhaust	V = Velocity, fpm
⊞ = Permanent Stopping	Q = Quantity, cfm
⊞ = Temporary Stopping	WG = Water Gauge

MINE MAP MINE I. D. No. 36-05544
Showing the location and extent of development of the M L & B Coal Co. slope mine. Situate on the So. dip Buck Mountain Vein, Foster Township, Schuylkill County, Pa.
A.B. Riedel, P.E.
Oct. 23, 1981
Scale 1" = 100'