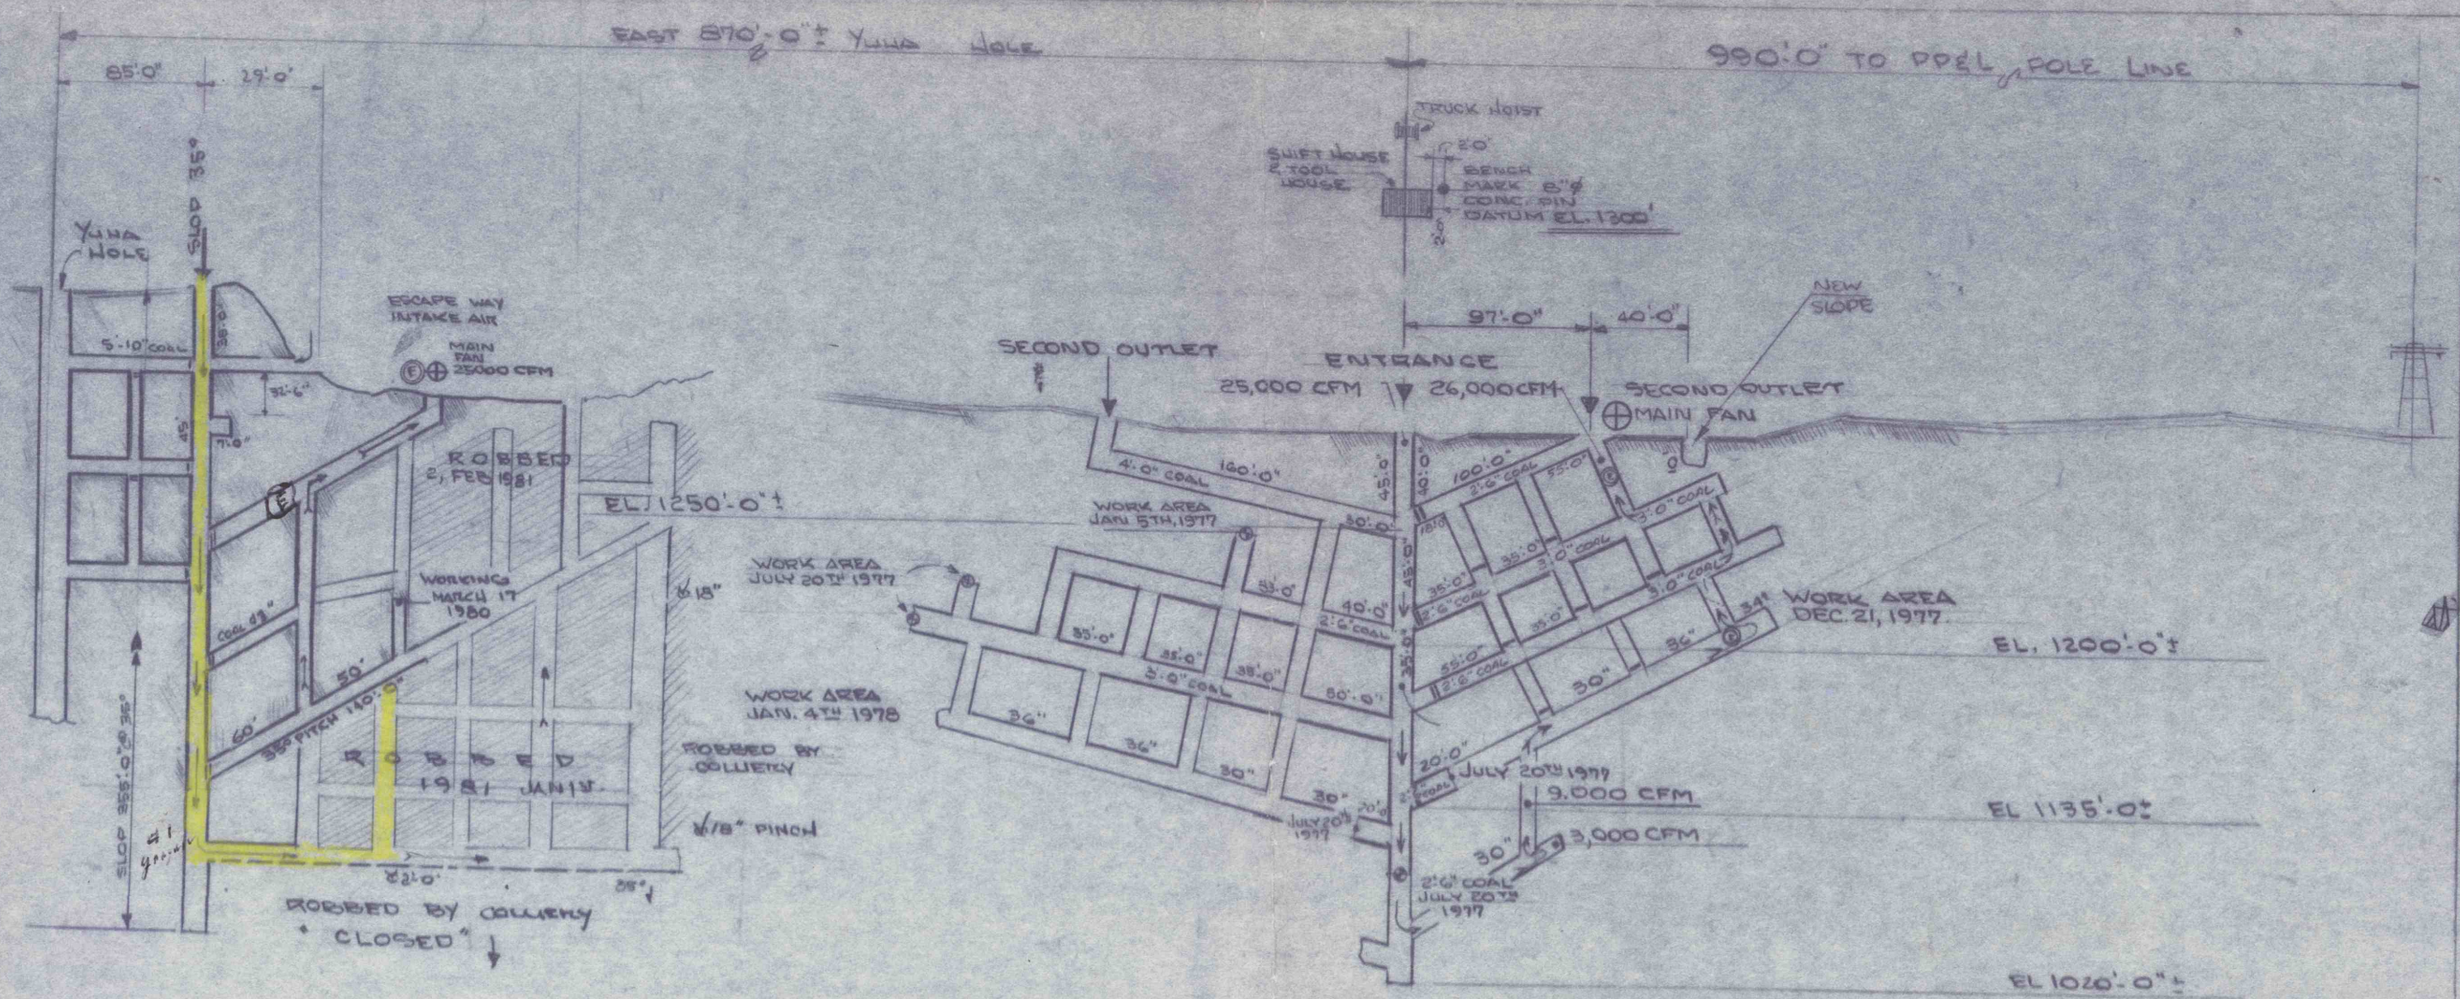

MOUTH OF SLOPE

No 1 SLOPE ID 36-0-5906
Z & Z COAL CO. EXCELSIOR PA.

9½ VAIN ~ 45° PITCH SCALE 1"=100'-0"

ORIGINAL	JAN 5TH 1977
REVISED	JULY 20TH 1977
REVISED	FEB 2ND 1978
REVISED	MARCH 17TH 1980

COMMONWEALTH OF PENNSYLVANIA
REGISTERED PROFESSIONAL
MICHAEL F. CATINO
ENGINEER
No. 22154 E

Michael F Catino
Feb 1, 1981

LEGEND

- ⊕ MAIN FAN
- → INTAKE AIR
- ⇢ RETURN AIR
- = PERMANENT STOPPING
- – TEMPORARY STOPPING
- ---- BRATTICE
- Ⓔ ESCAPE WAY RETURN AIR WAY
  ESCAPE WAY INTAKE AIR
- [E] ESCAPE WAY

941

C-119