


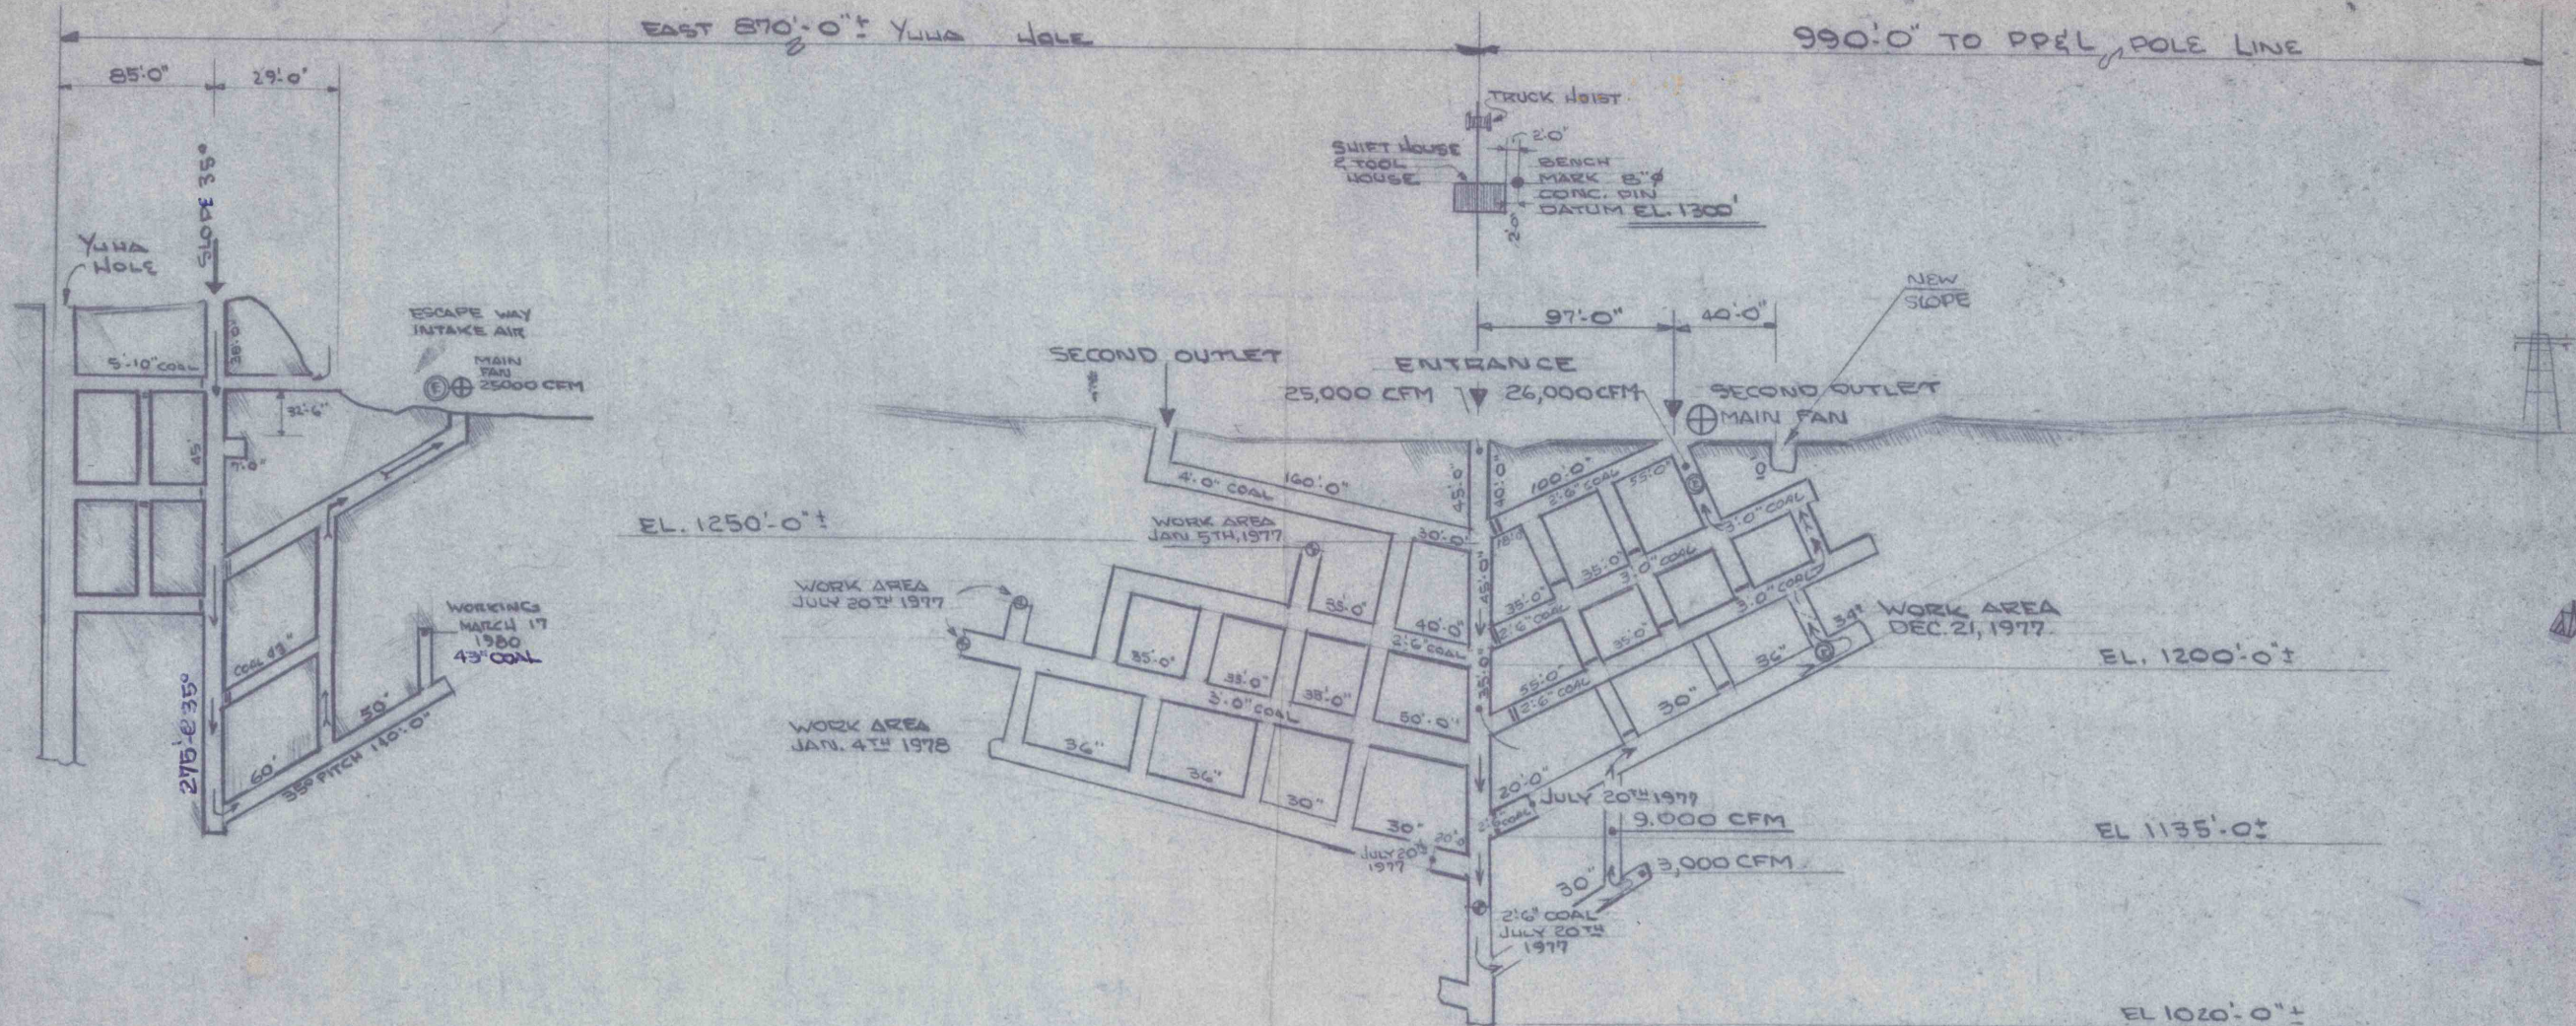

Nº1 SLOPE ID 36-0-5908
Z & Z COAL CO. EXCELSIOR PA.

9 1/2 VAIN ~ 45° PITCH SCALE 1"=100'-0"

ORIGINAL Jan 5TH 1977
REVISED July 20TH 1977
REVISED FEB 2ND 1978
REVISED MARCH 17TH 1980



Trumbauer
3/24/80

LEGEND

- ⊕ MAIN FAN
- INTAKE AIR
- ↘ RETURN AIR
- = PERMANENT STOPPING
- TEMPORARY STOPPING
- BRATTICE
- ⓔ ESCAPE WAY RETURN AIR WAY
- ⓔ ESCAPE WAY INTAKE AIR