


Scale = 100 feet per inch

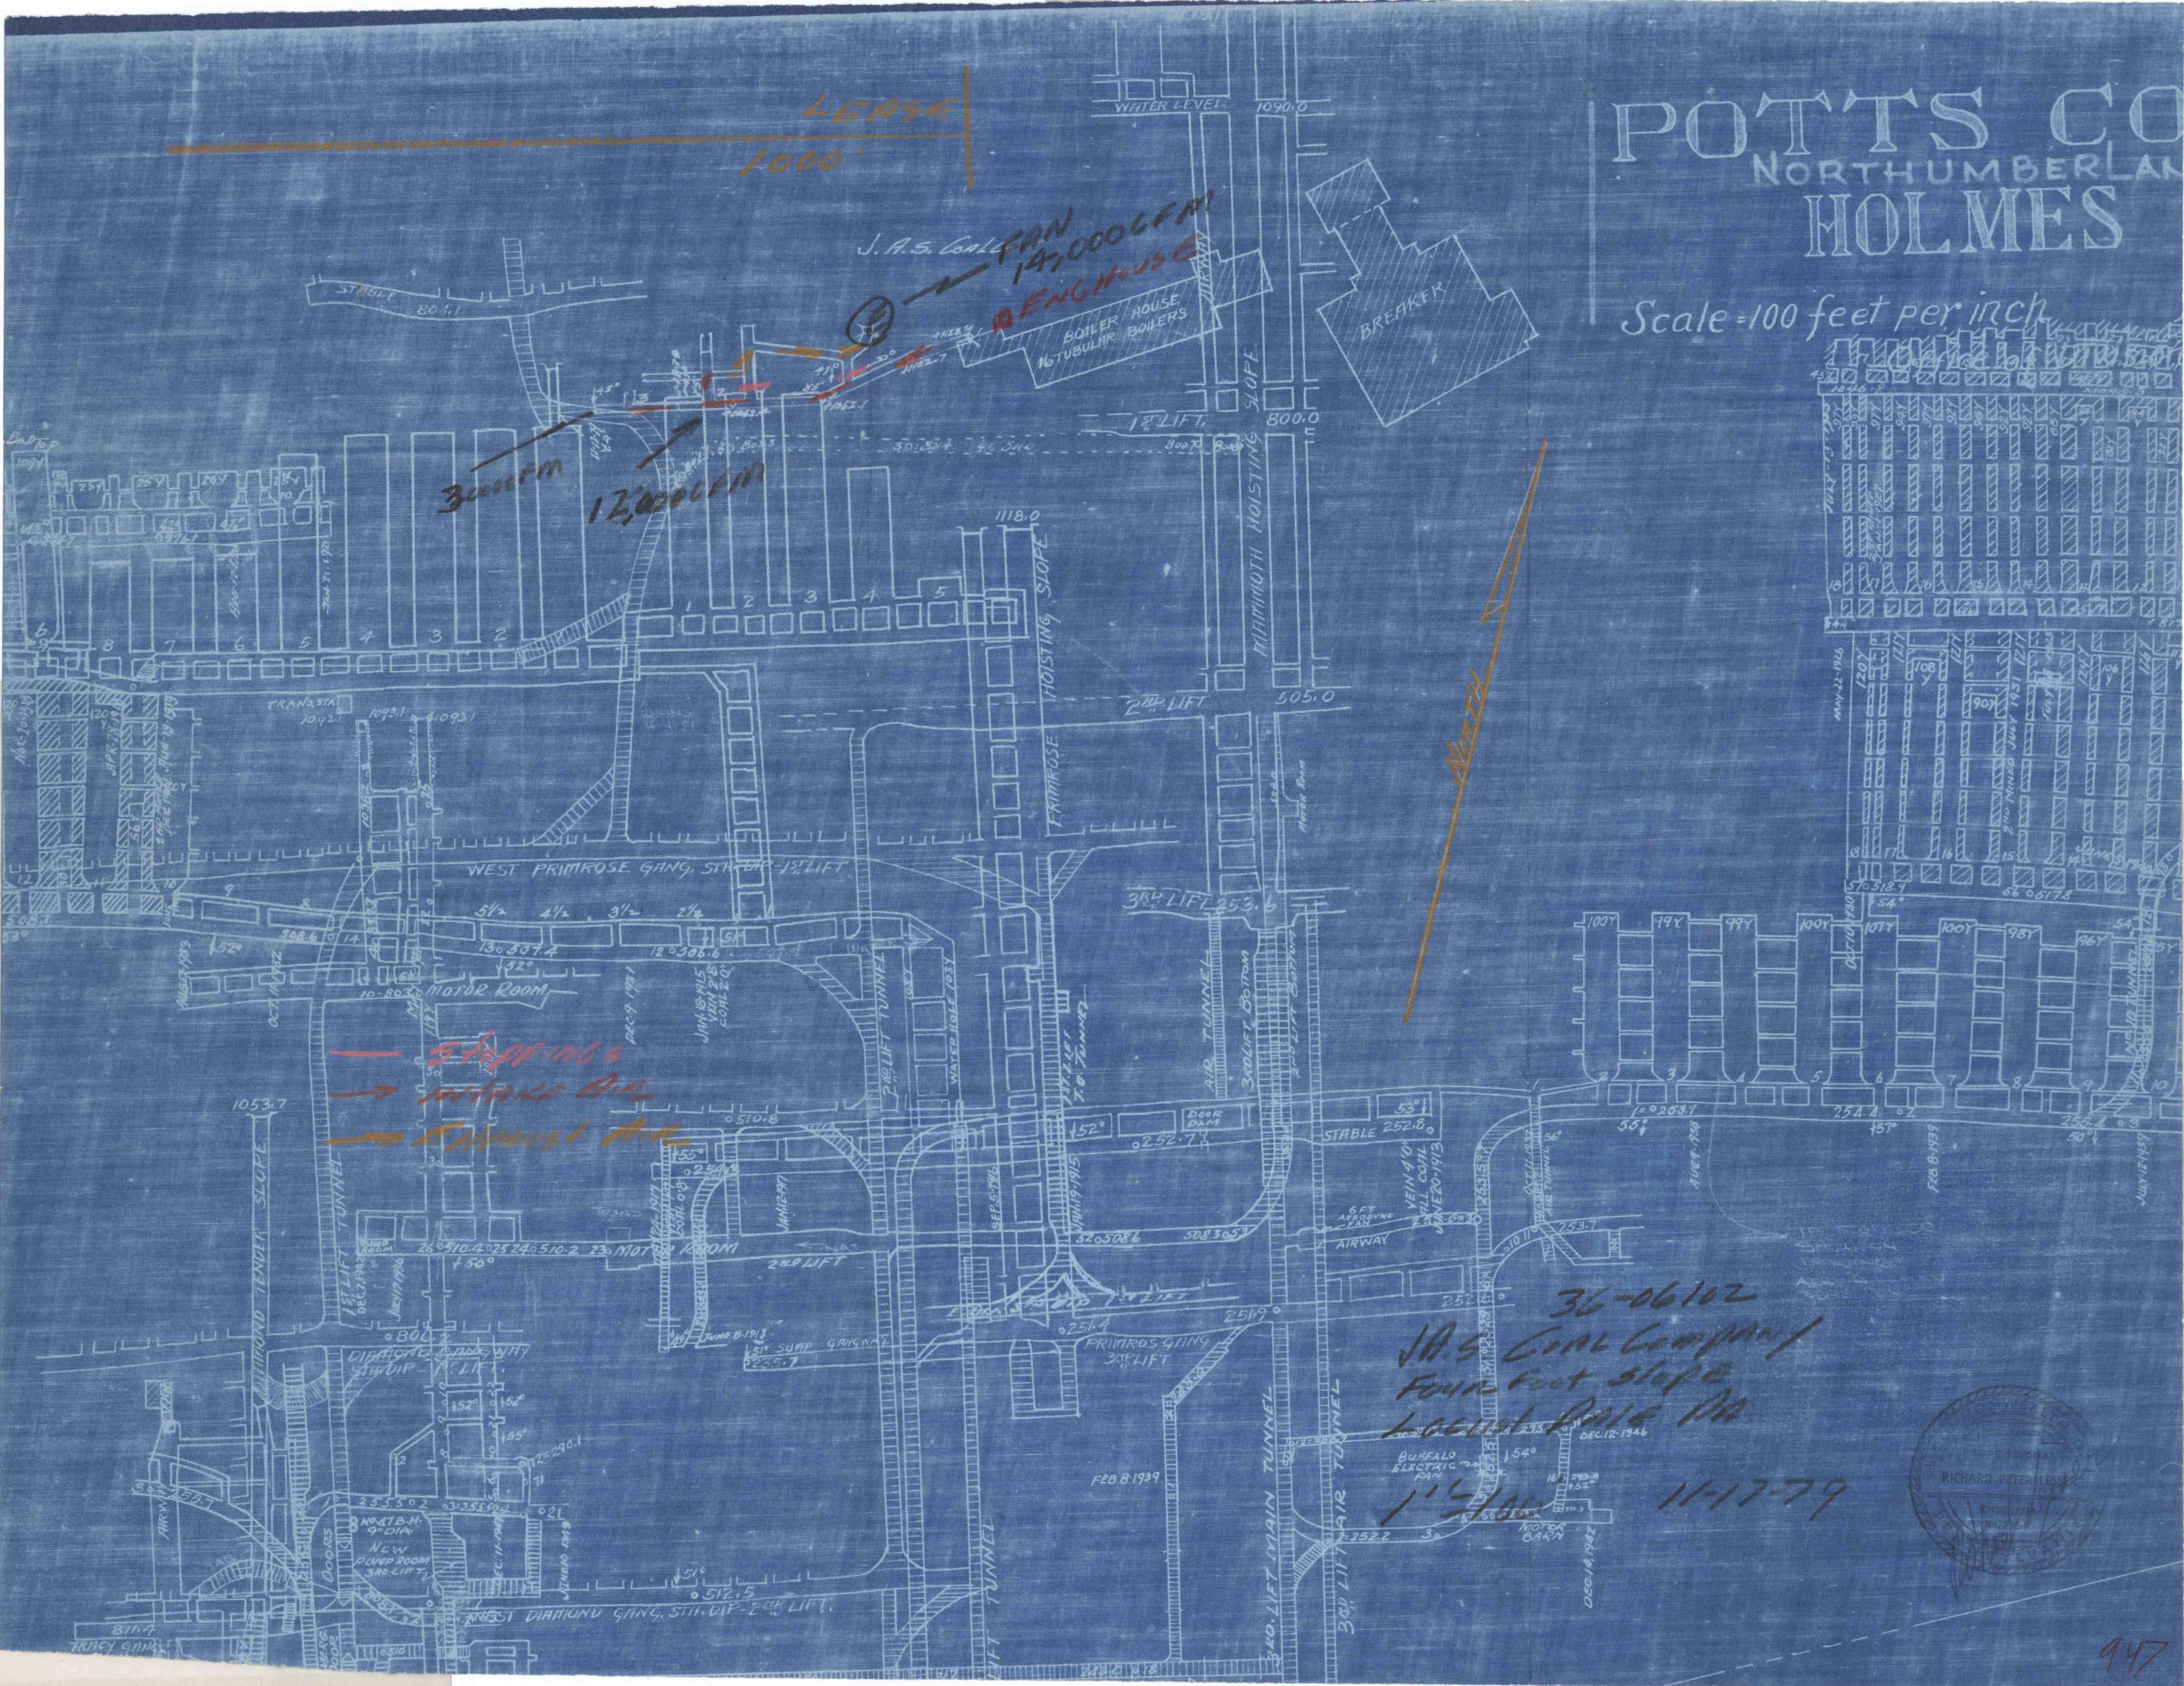

257-150 36-06102
J.A.S. Coal Company
Four foot slope
DEC 12 1946

15/06

11-17-79