
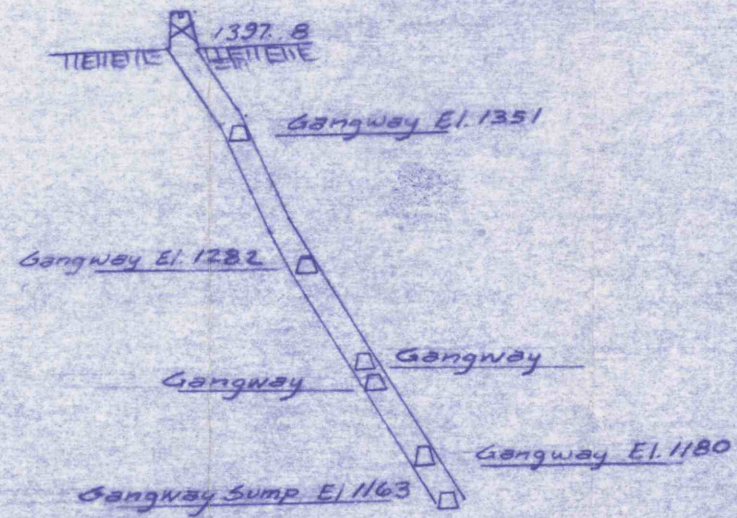
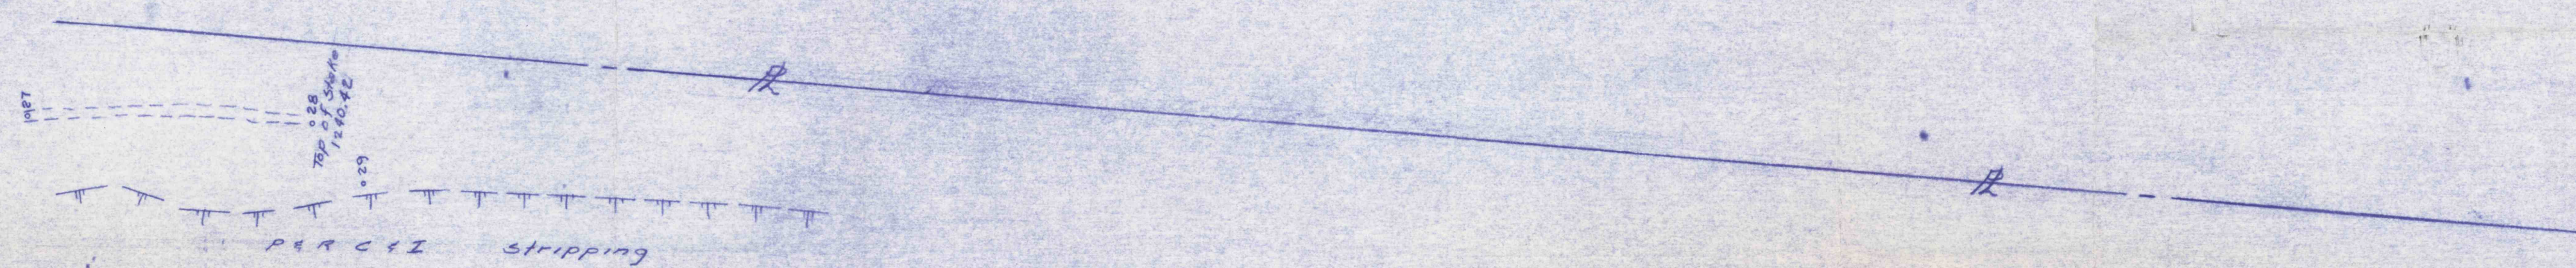


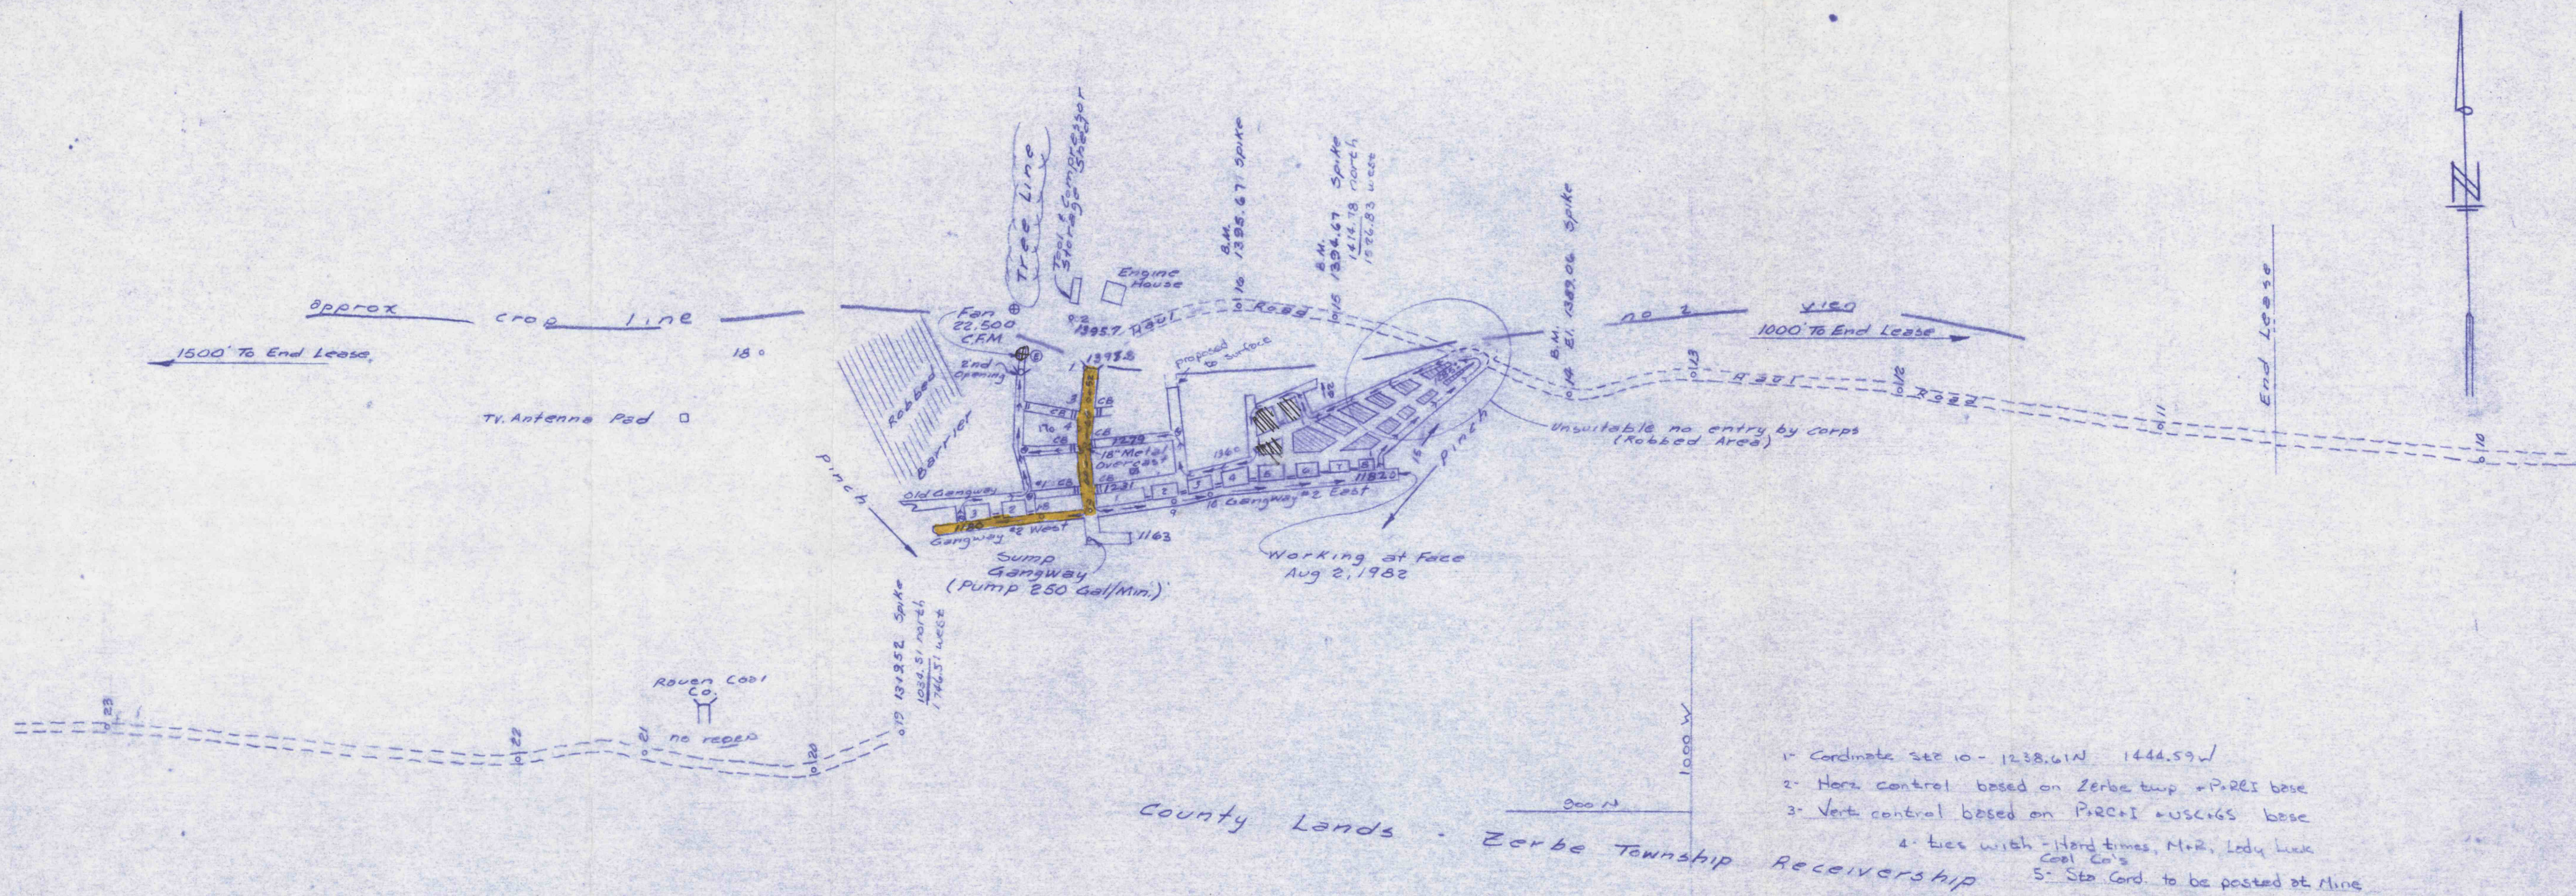

- Legend**
- ⊙ - Escapeway
 - ⊙ - Fen
 - - Air (Intake)
 - ← - Air (Return)
 - 1 - Stopping (Temporary)
 - 11 - Stopping (Permanent)
 - ⊠ - Overcast
 - BM - Benchmark

Cross Section
Looking East Thru Vein
Impounded Water Pool - North Franklin Colliery
868.04 Aug 82
P+RC+I B

WAGNER ASSOCIATES, INC. Engineers • Architects • Planners • Surveyors 312 Mauch Chunk Street, Pottsville, PA 17901		
Situate in Zerbe Township Northumberland County, Pa.		
K & D Coal Company I.D. 36-06130 No. 2 Vein C Bed, Pottsville Formation		
ISSUE DATE :	DATE : 9/1/82	ORDER NO : 5119-A
SCALE : 1" = 100'	CHKD. BY : S.C.B.	DWG. NO : 92117
DWG. BY : W.J.N.	PROJ. MGR : S.C.B.	DEPT. HD : C.W.S.