

K&D Coal Co
No 1 Scope

36-INCH DIAMETER BUFFALO TYPE FAN
BUFFALO FORGE COMPANY CENTRIFUGAL FAN
EXHAUSTING - 440-VOLT, 10 H.P. - 1725 RPM.
MOTOR - STATIC WATER PRESSURE - 0.45"
CH4 0.00%




K&D Coal Co
No 1 Scope

36-06130

County Lands - Zerbe Township Receiv



R C & I Stripping

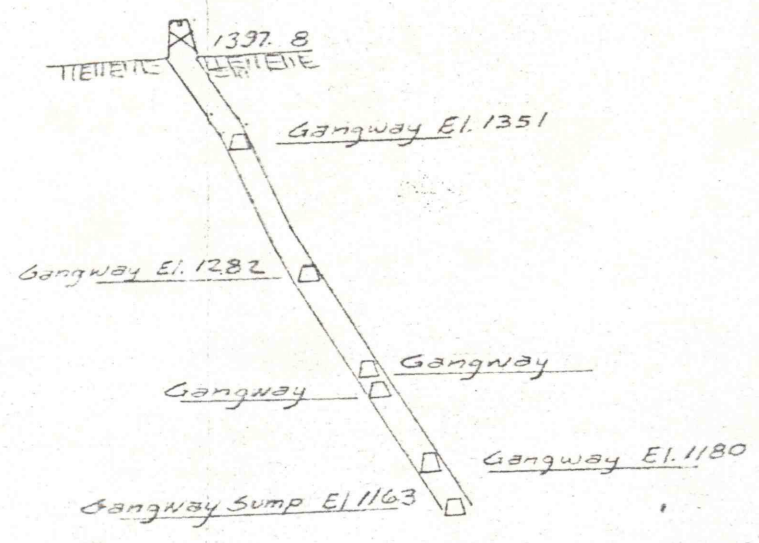

Treverton Estate Lands

Legend

- - Escapeway
- - Fan
- - Air (Intake)
- ↔ - Air (Return)
- I - Stopping (Temporary)
- II - Stopping (Permanent)
- - Overcast
- BM - Benchmark

WORKING AREA MARKED
IN YELLOW 5-16-83

Cross Section
Looking East Thru Vein
Impounded Water Pool - North Franklin Colliery
868.04' - Aug 82
P+RC+I B