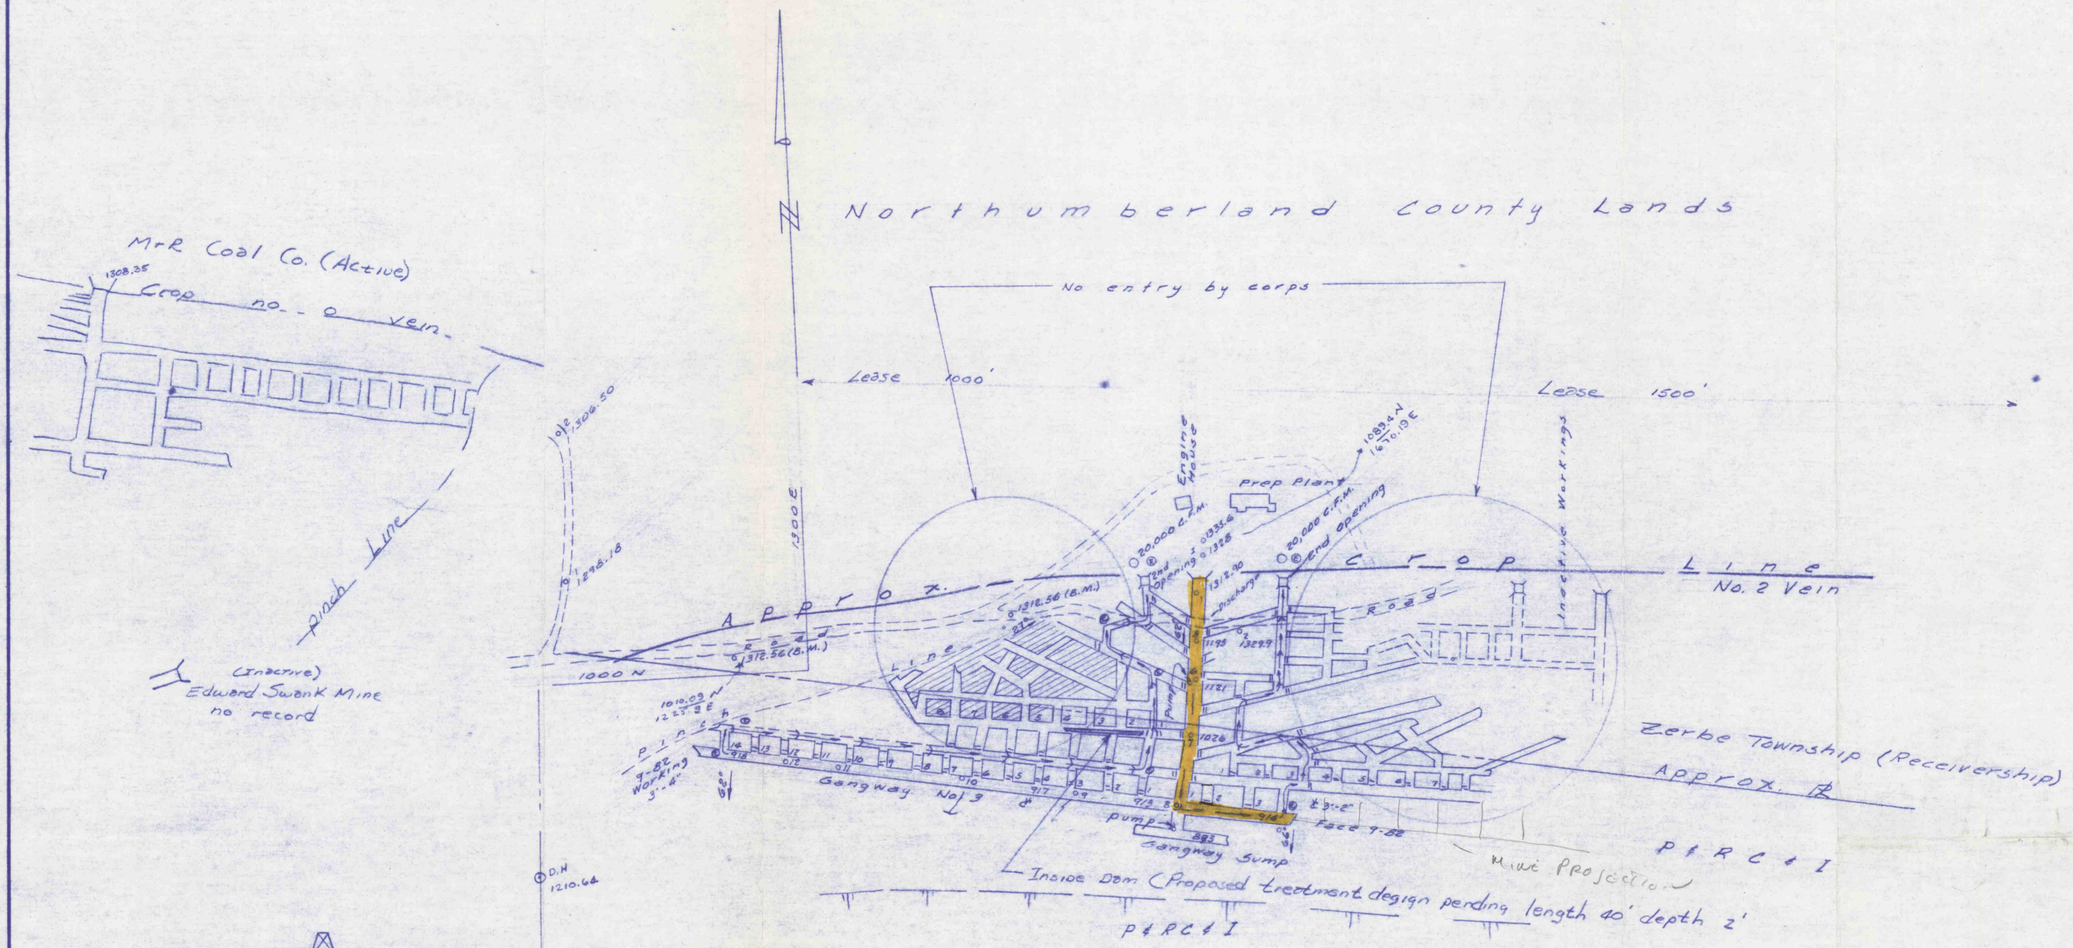

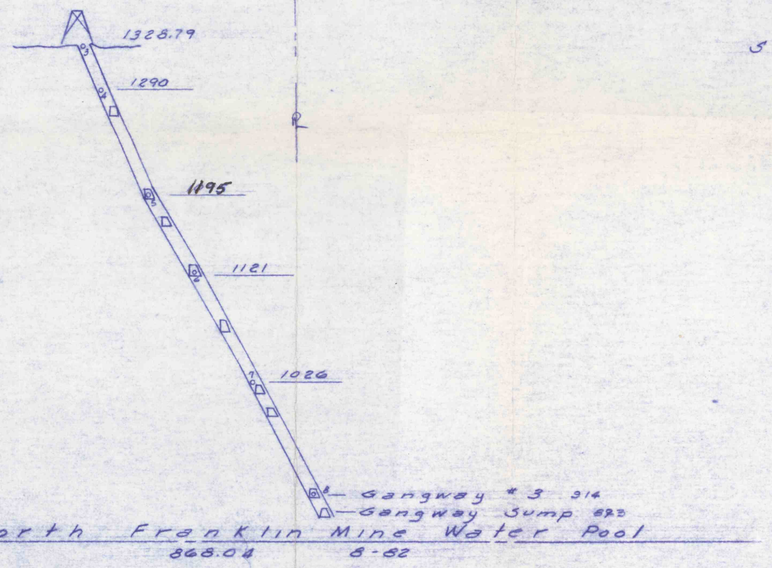

Section Thru Slope
Looking East

Notes:
1- tie in with Hard Times, MrR and K+O Coal Cos
2- Vert with P&RC&I And USC&GS
3- Sta Cord points posted at mine

0 50 100 200 400 Ft.
Graphic Scale
1" = 100'

Legend
→ - Indicates Air Intake
© - " Escapeway
⊕ - " Fan
|| - " Permanent Stopping
| - " Temporary Stopping
→ - " Air (Exhust)
o - " Survey Sta.
B.M - " Benchmark

WAGNER group
WAGNER ASSOCIATES, INC.
Engineers•Architects•Planners•Surveyors
312 Mauch Chunk Street, Pottsville, PA. 17901

Situate in Zerbe Township
Northumberland County, Pa.

Lady Luck Coal Co.
No. 2 Vein C Bed
I.D. 36-07153
Pottsville Formation

ISSUE DATE : 10/22/82		
SCALE : 1" = 100'	DATE : 10/28/82	ORDER NO : 5118-B
DWG. BY : W.J.N.	CHKD. BY : SCB	DWG. NO : 92148
PROJ. MGR : S.C.B.	DEPT. HD : C.W.S.	

957