
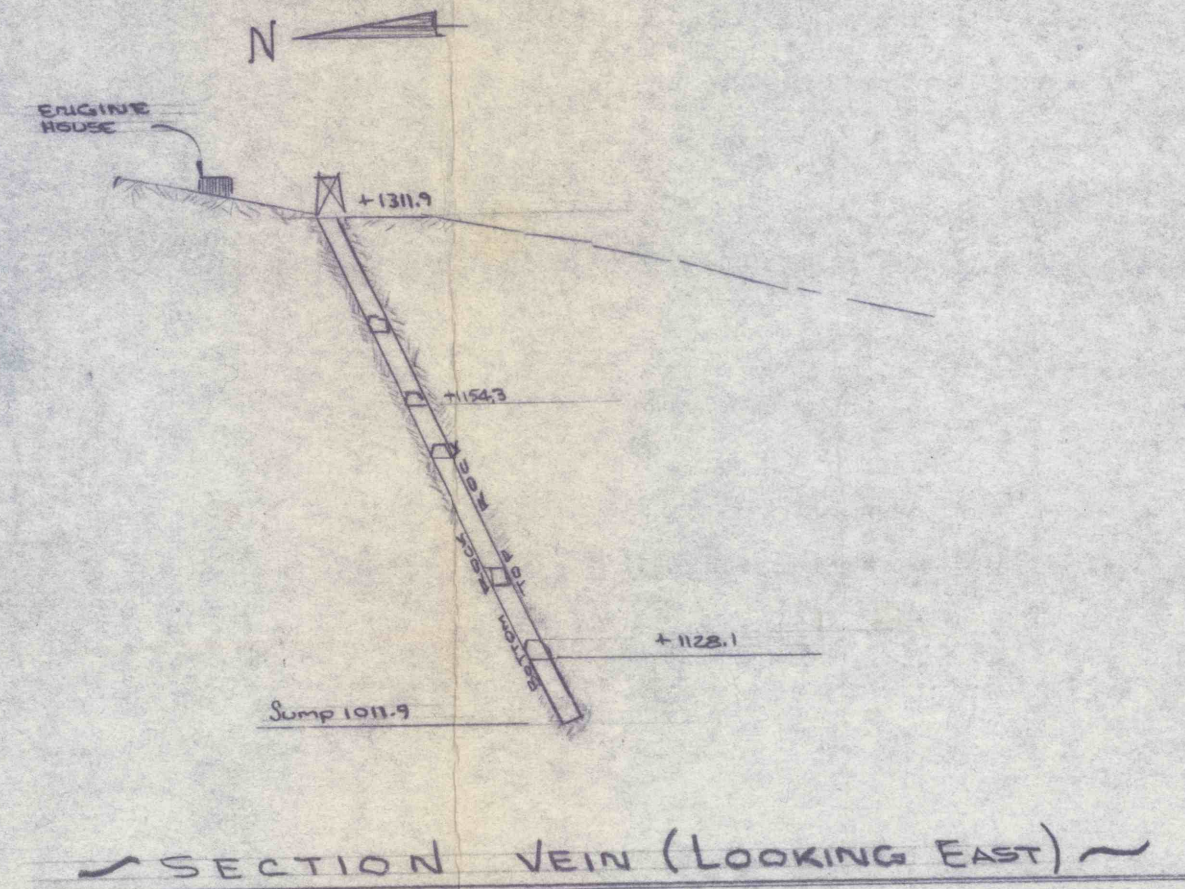


TREVORTON ESTATE

ASSOCIATE LANDS

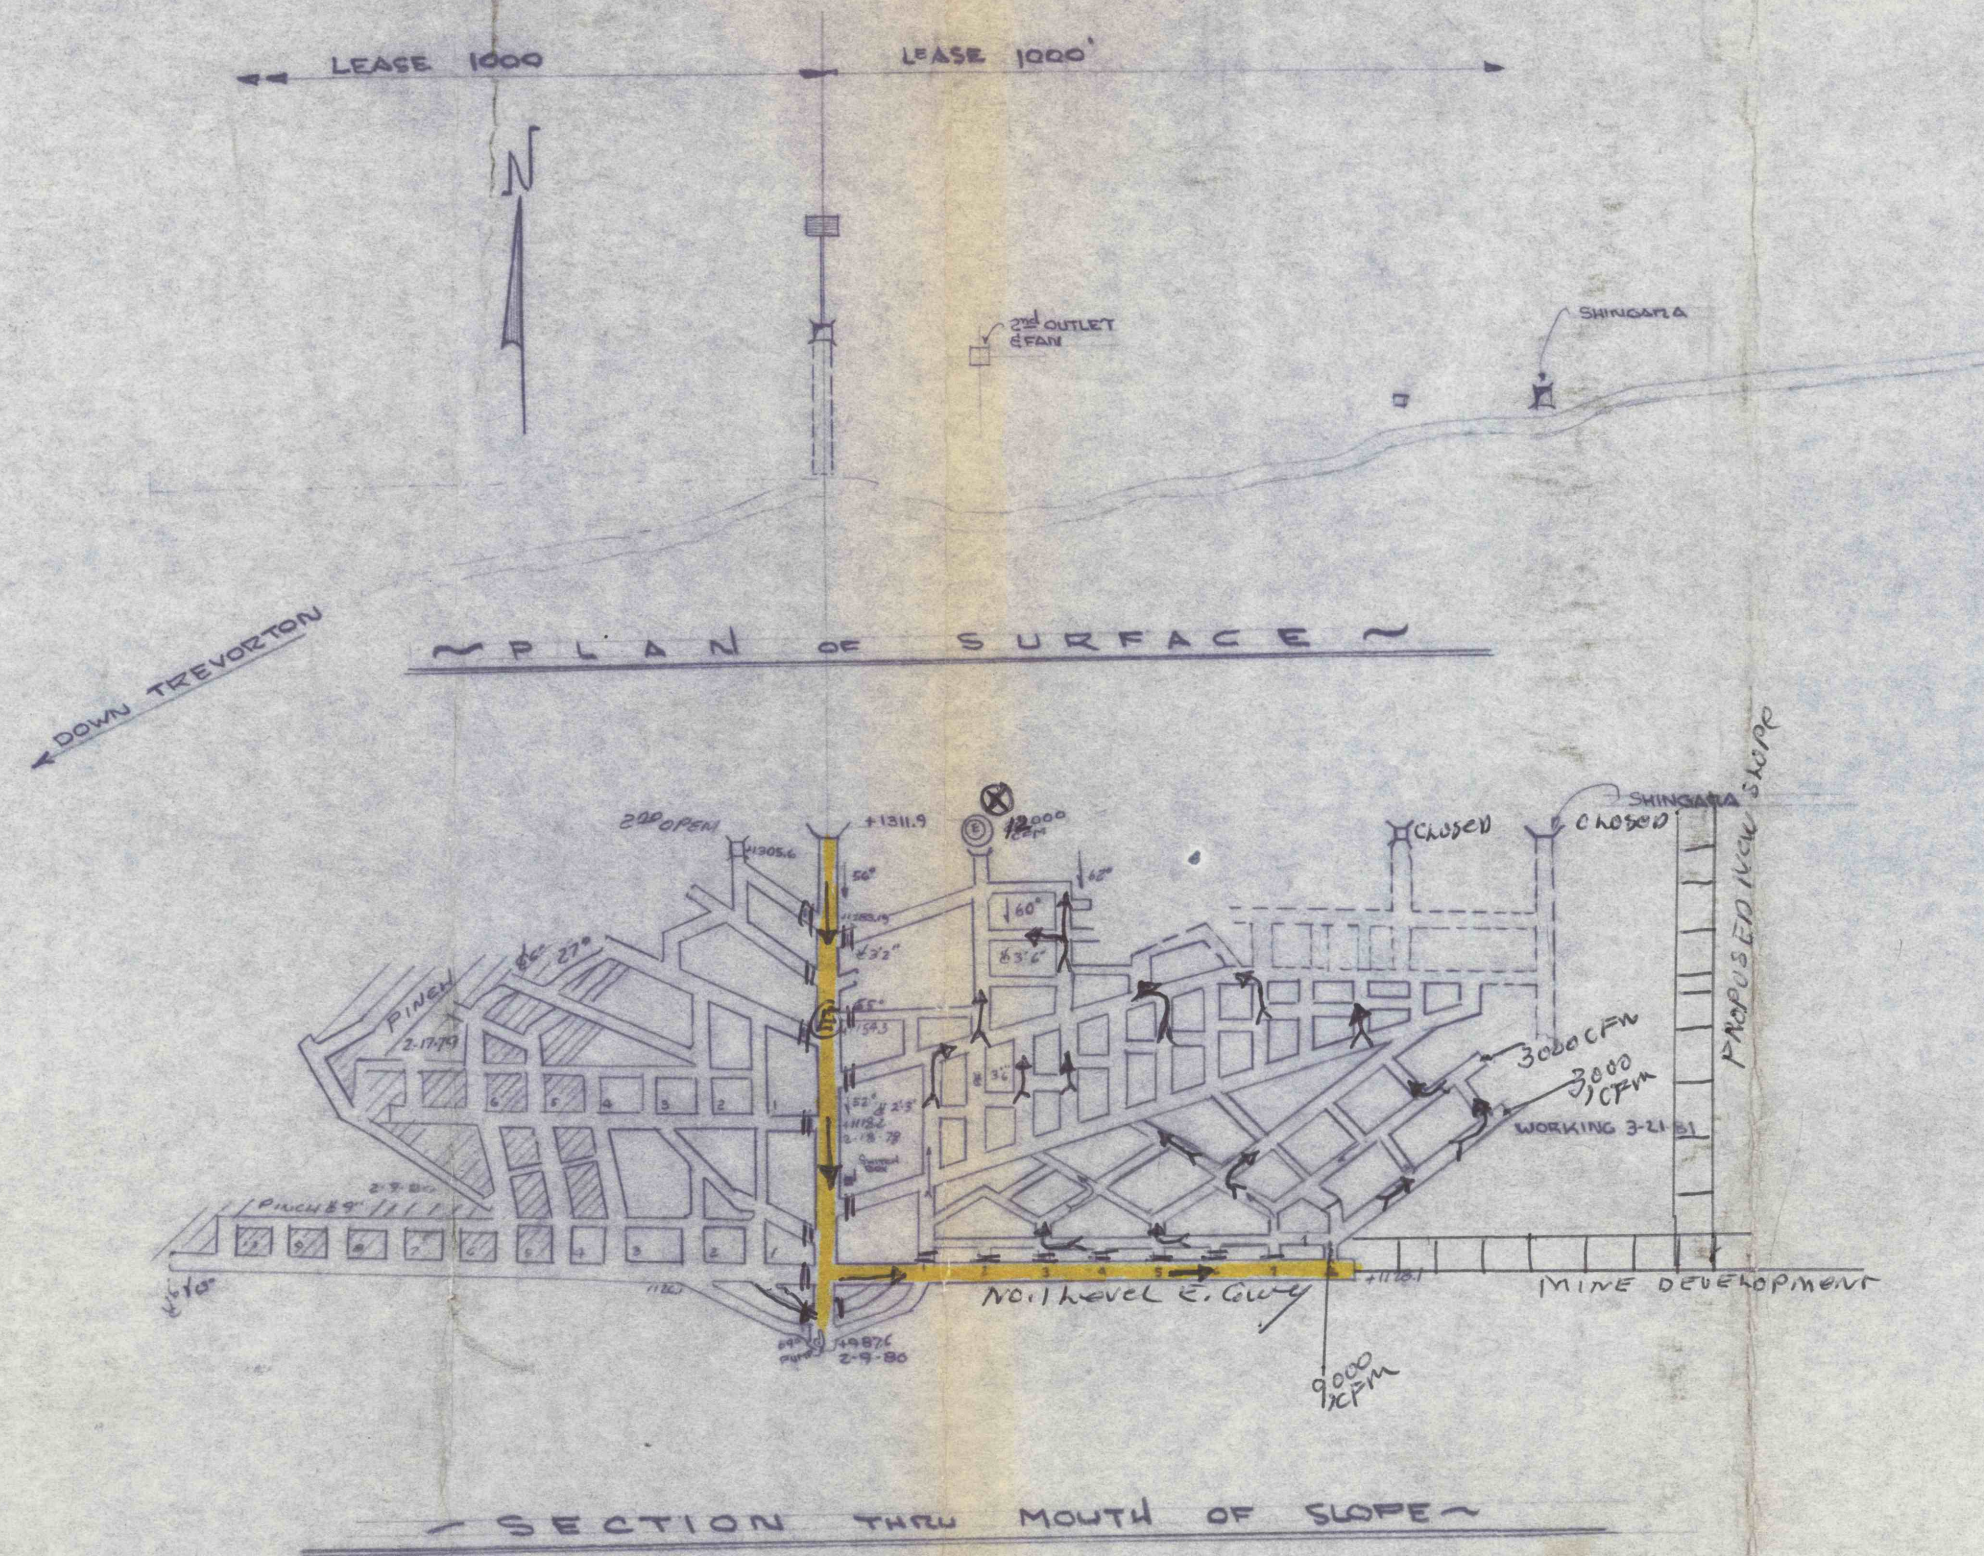

LADY LUCK COAL CO.
ZERBE TWP NORTH'D CO.
No. 2 VEIN SLOPE SCALE 1"=1'-0"
I.D. No 36-06160

LEGEND

- ← SUPPLY AIR
- RETURN AIR
- PERMANENT STOPPING
- TEMPORARY STOPPING
- BRATTIC OR CANVAS
- ⊙ ESCAPE AND RETURN AIR
- ⊕ ESCAPEWAY INTAKE AIR
- ⊕ SURFACE FAN

