


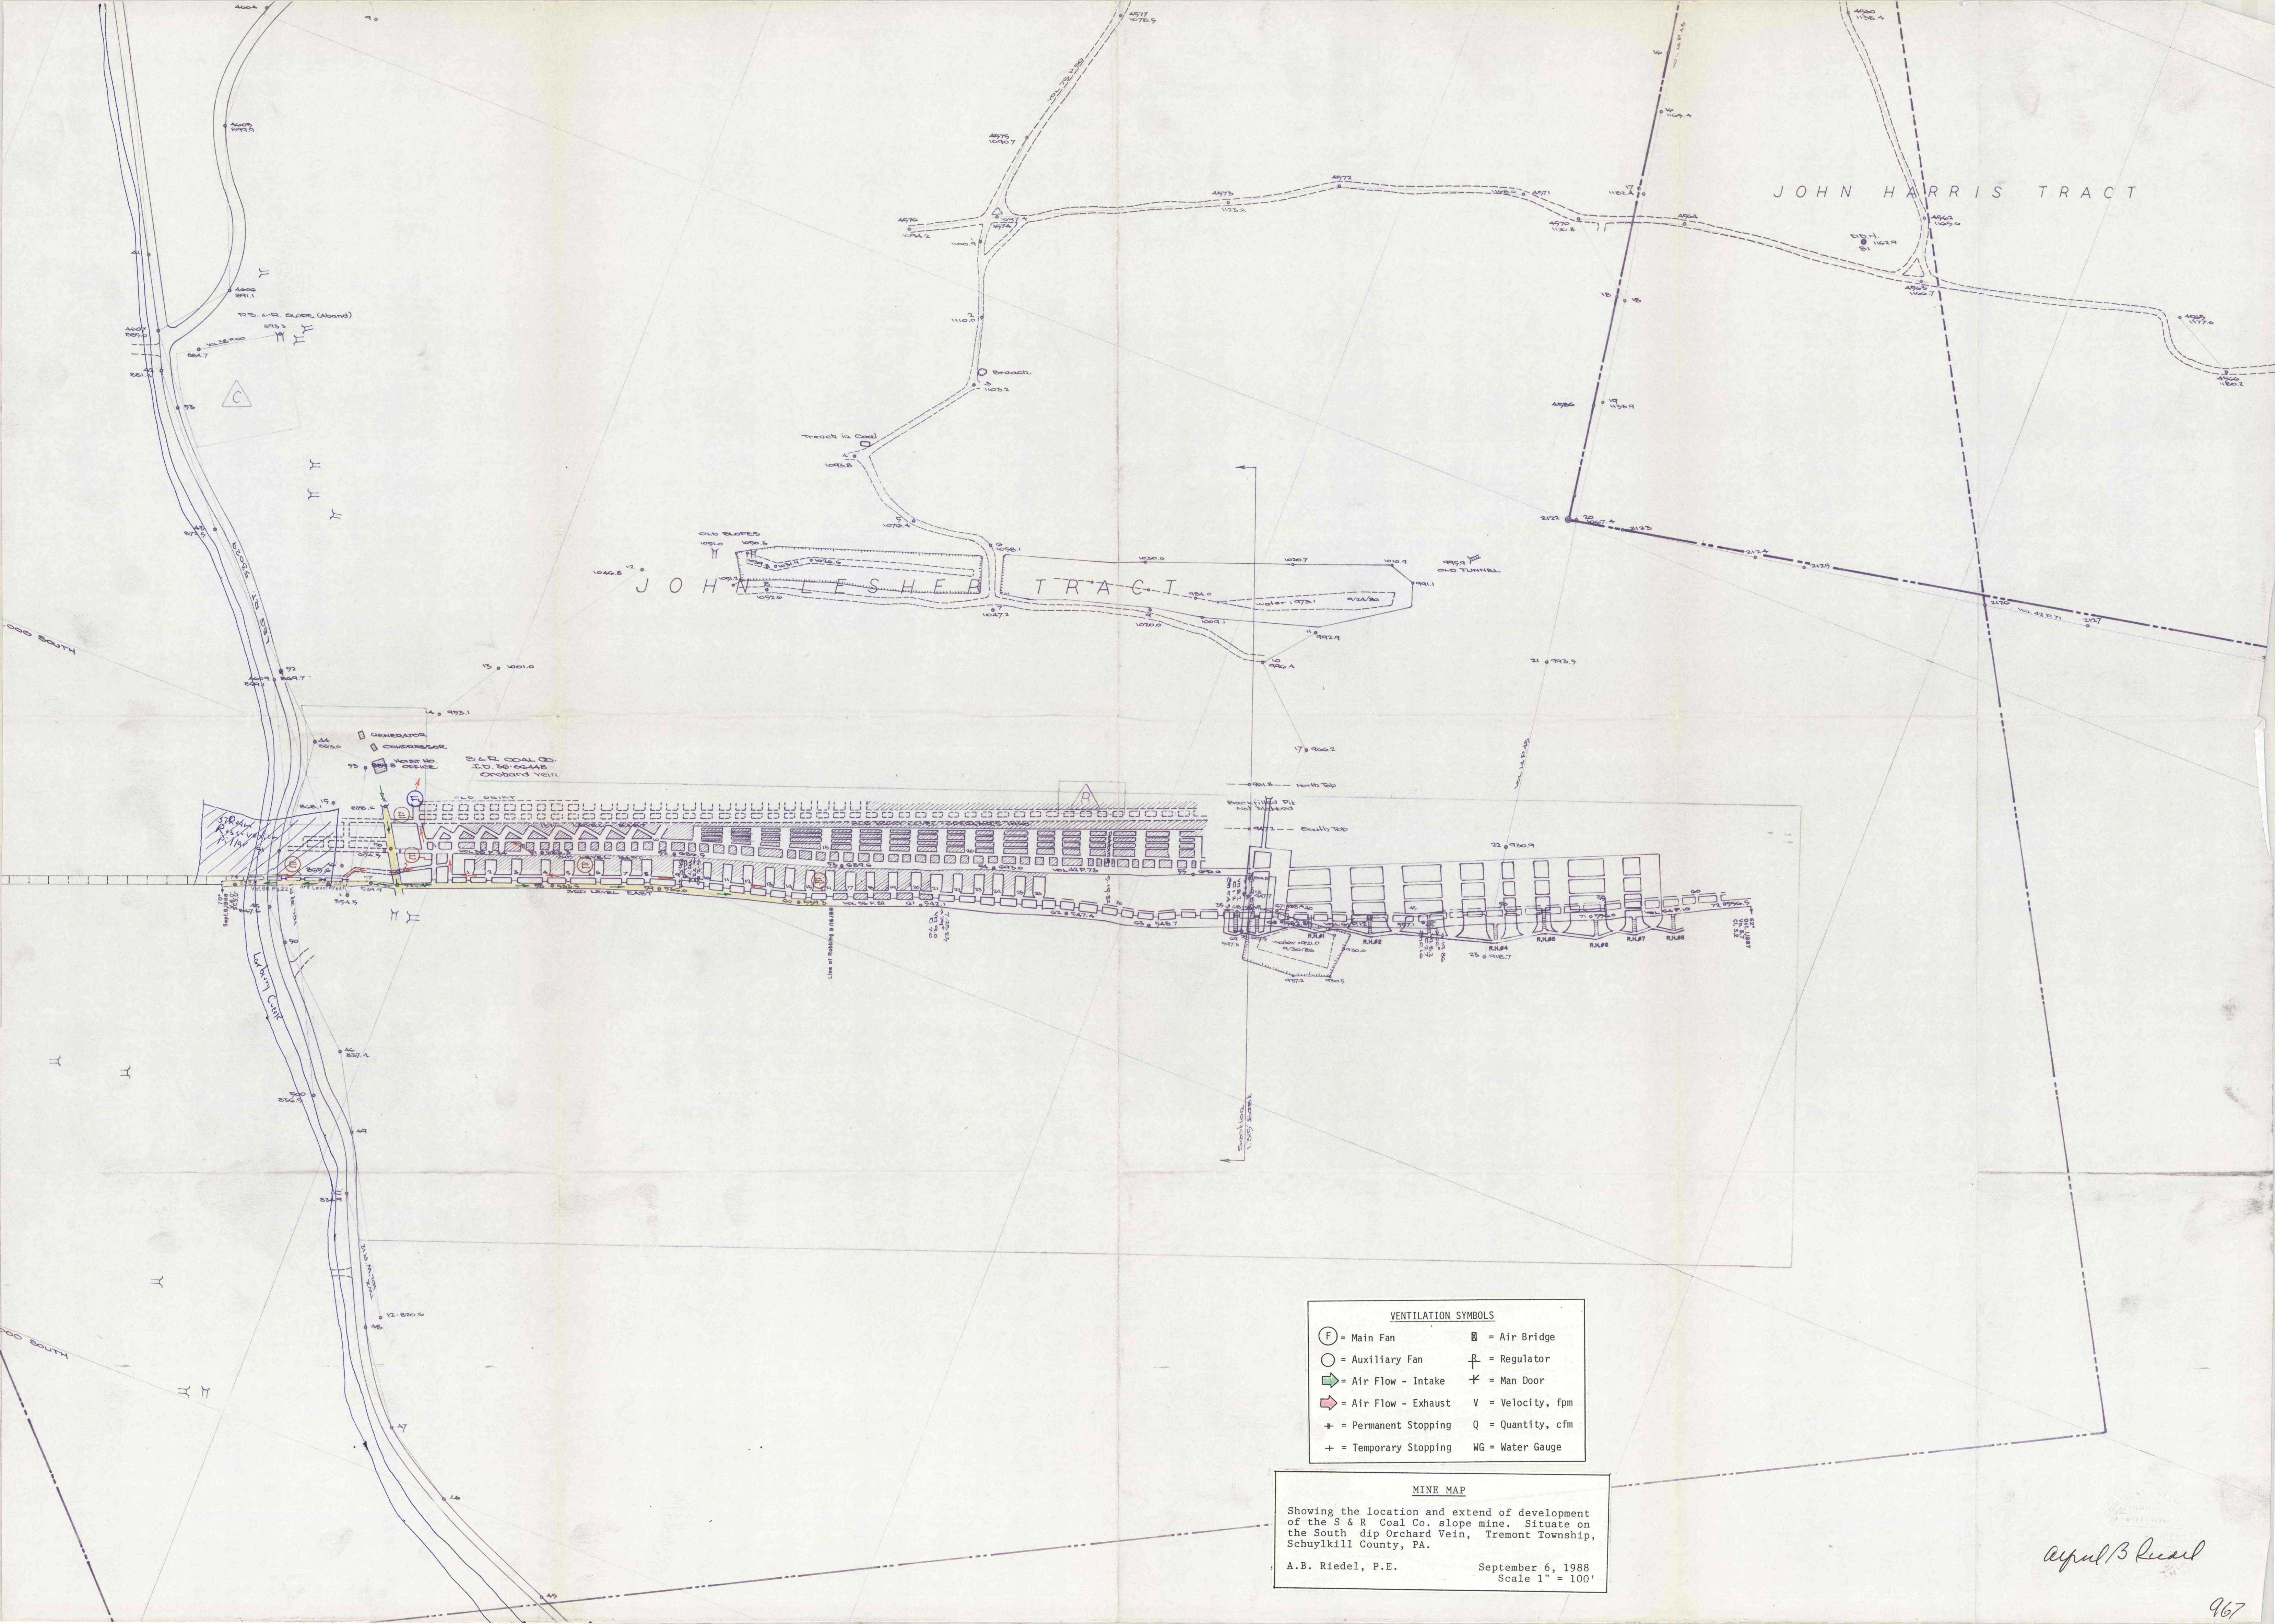

JOHN HARRIS TRACT

JOHN LLESHER TRACT

VENTILATION SYMBOLS	
(F) = Main Fan	[Symbol] = Air Bridge
(O) = Auxiliary Fan	[Symbol] = Regulator
[Symbol] = Air Flow - Intake	[Symbol] = Man Door
[Symbol] = Air Flow - Exhaust	V = Velocity, fpm
+ = Permanent Stopping	Q = Quantity, cfm
+ = Temporary Stopping	WG = Water Gauge

MINE MAP
Showing the location and extend of development of the S & R Coal Co. slope mine. Situate on the South dip Orchard Vein, Tremont Township, Schuylkill County, PA.
A.B. Riedel, P.E. September 6, 1988
Scale 1" = 100'

April 13 Rec'd