


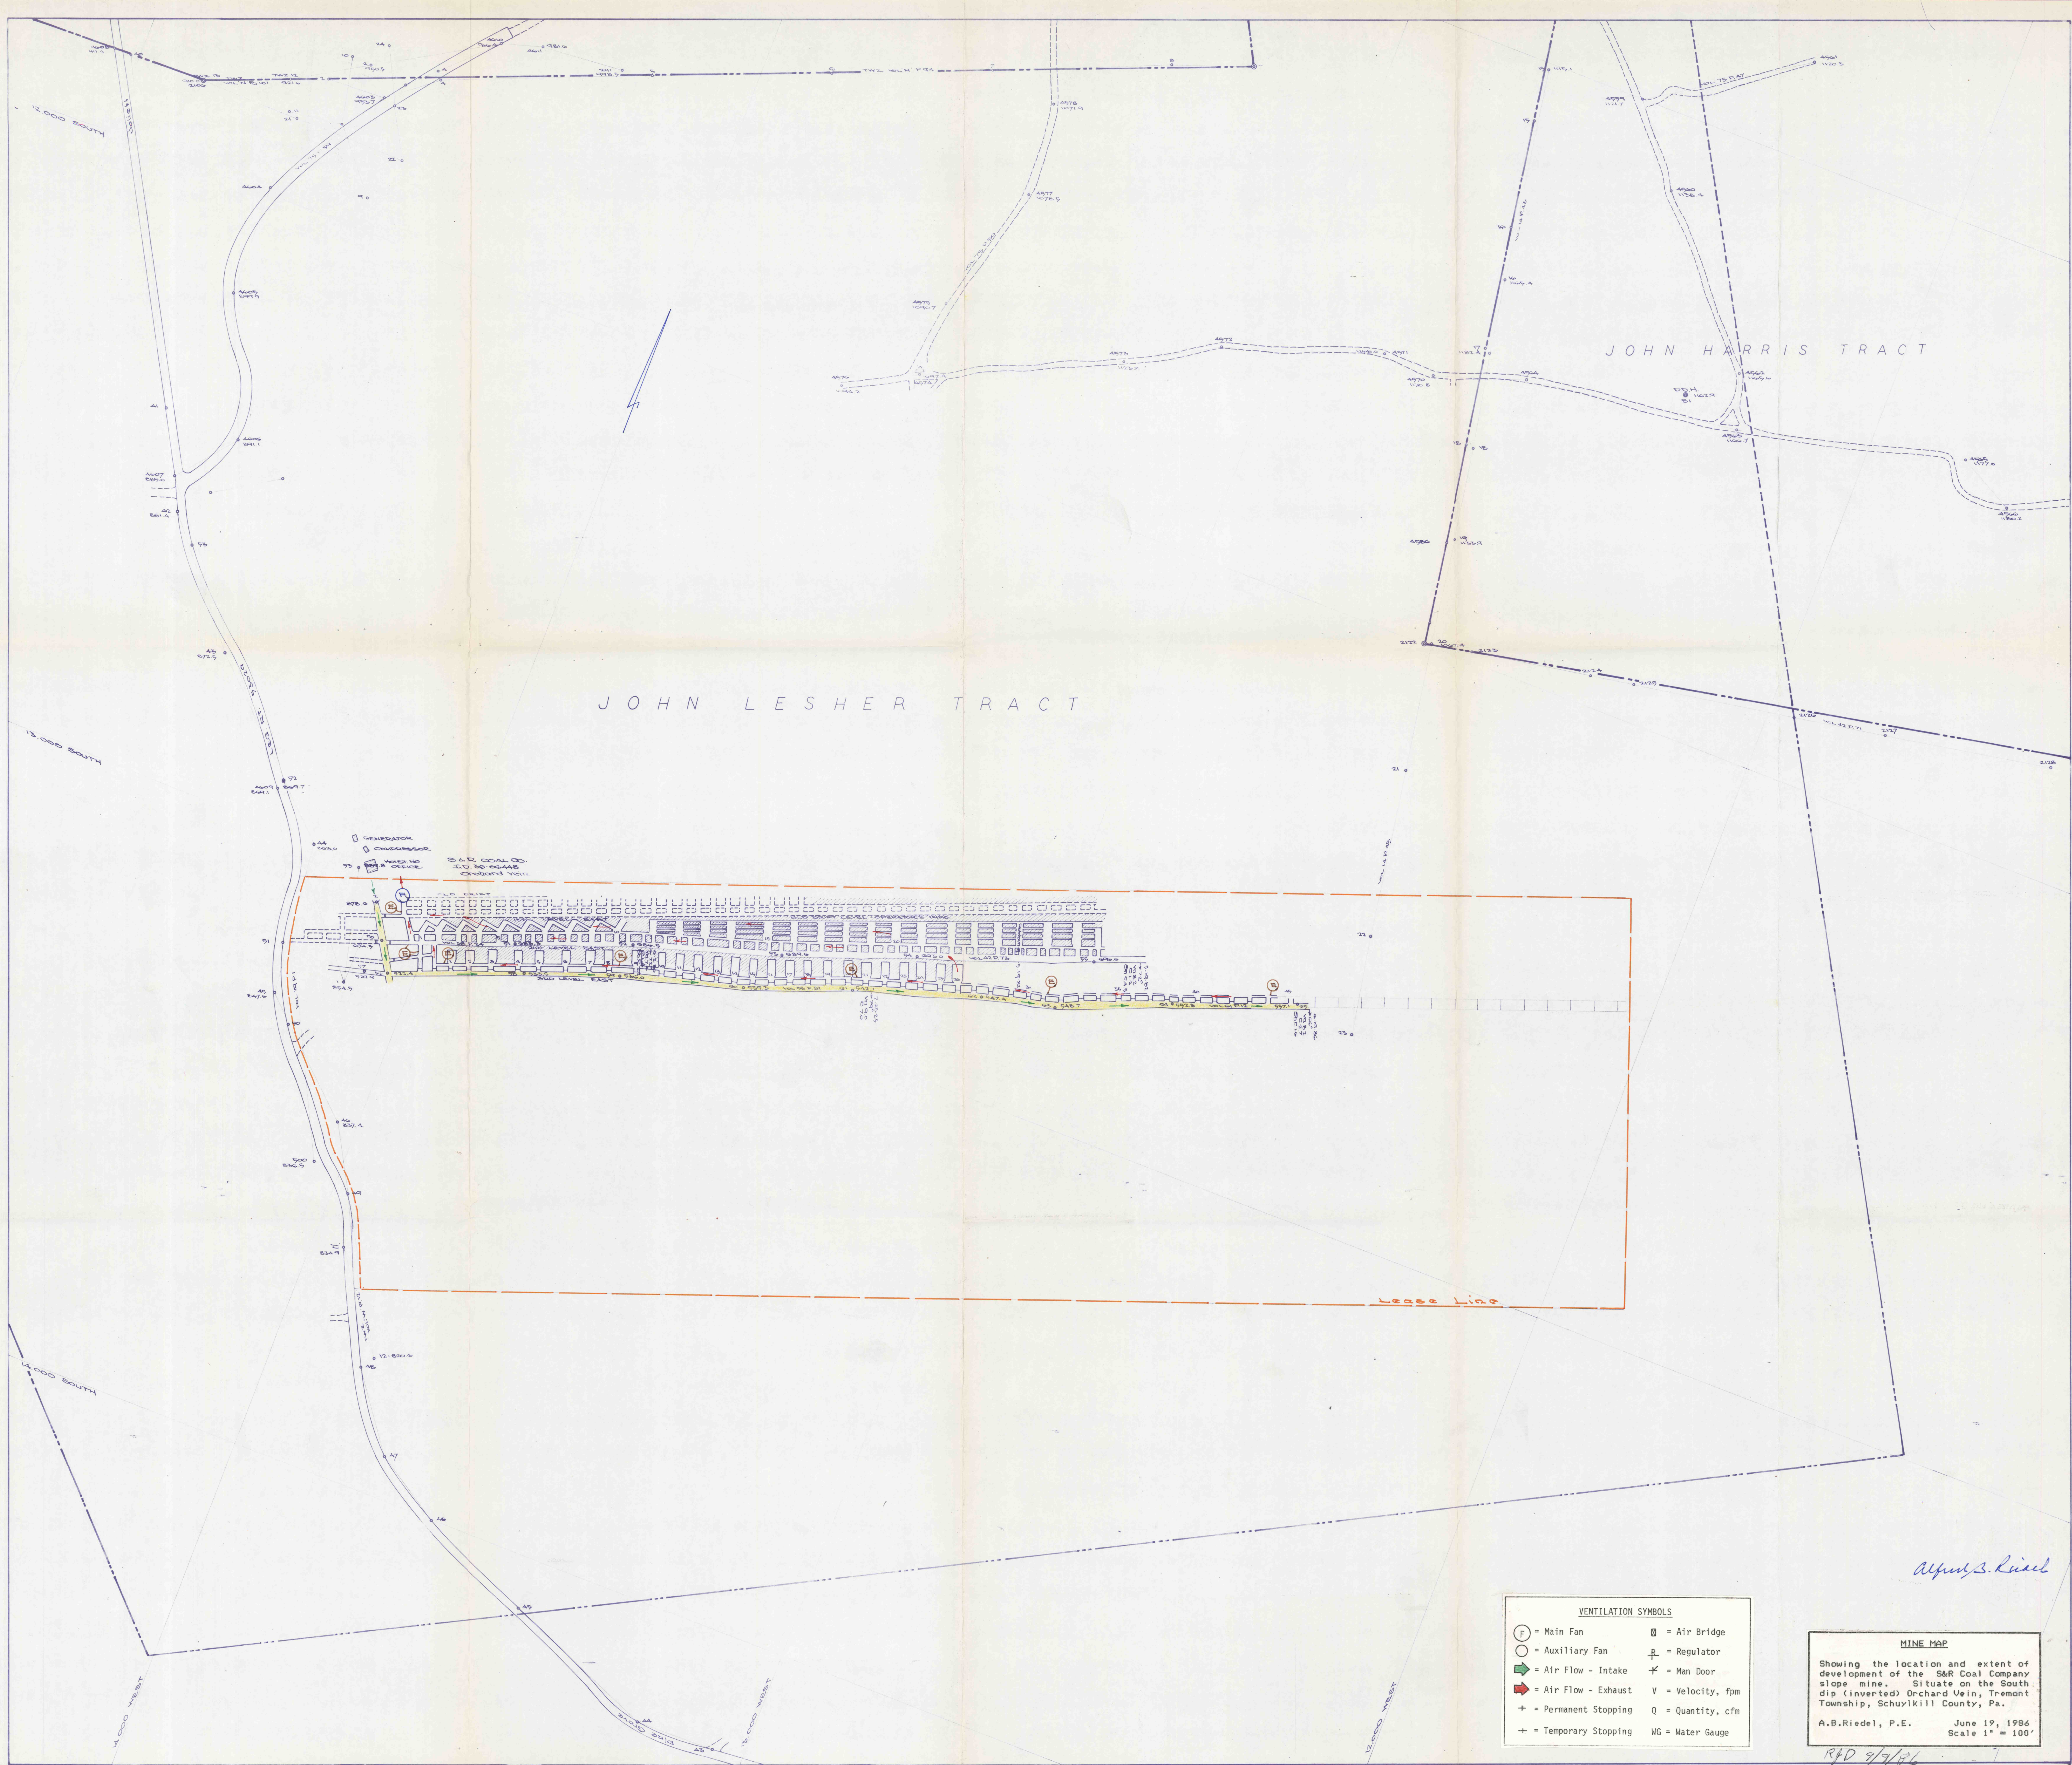

VENTILATION SYMBOLS	
(F) = Main Fan	[Square with cross] = Air Bridge
(A) = Auxiliary Fan	[Square with horizontal lines] = Regulator
[Green arrow] = Air Flow - Intake	[Square with cross] = Man Door
[Red arrow] = Air Flow - Exhaust	V = Velocity, fpm
+ = Permanent Stopping	Q = Quantity, cfm
x = Temporary Stopping	WG = Water Gauge

MINE MAP
Showing the location and extent of development of the S&R Coal Company slope mine. Situate on the South dip (inverted) Orchard Vein, Tremont Township, Schuylkill County, Pa.
A.B. Riedel, P.E. June 19, 1986
Scale 1" = 100'

RFD 9/9/86