


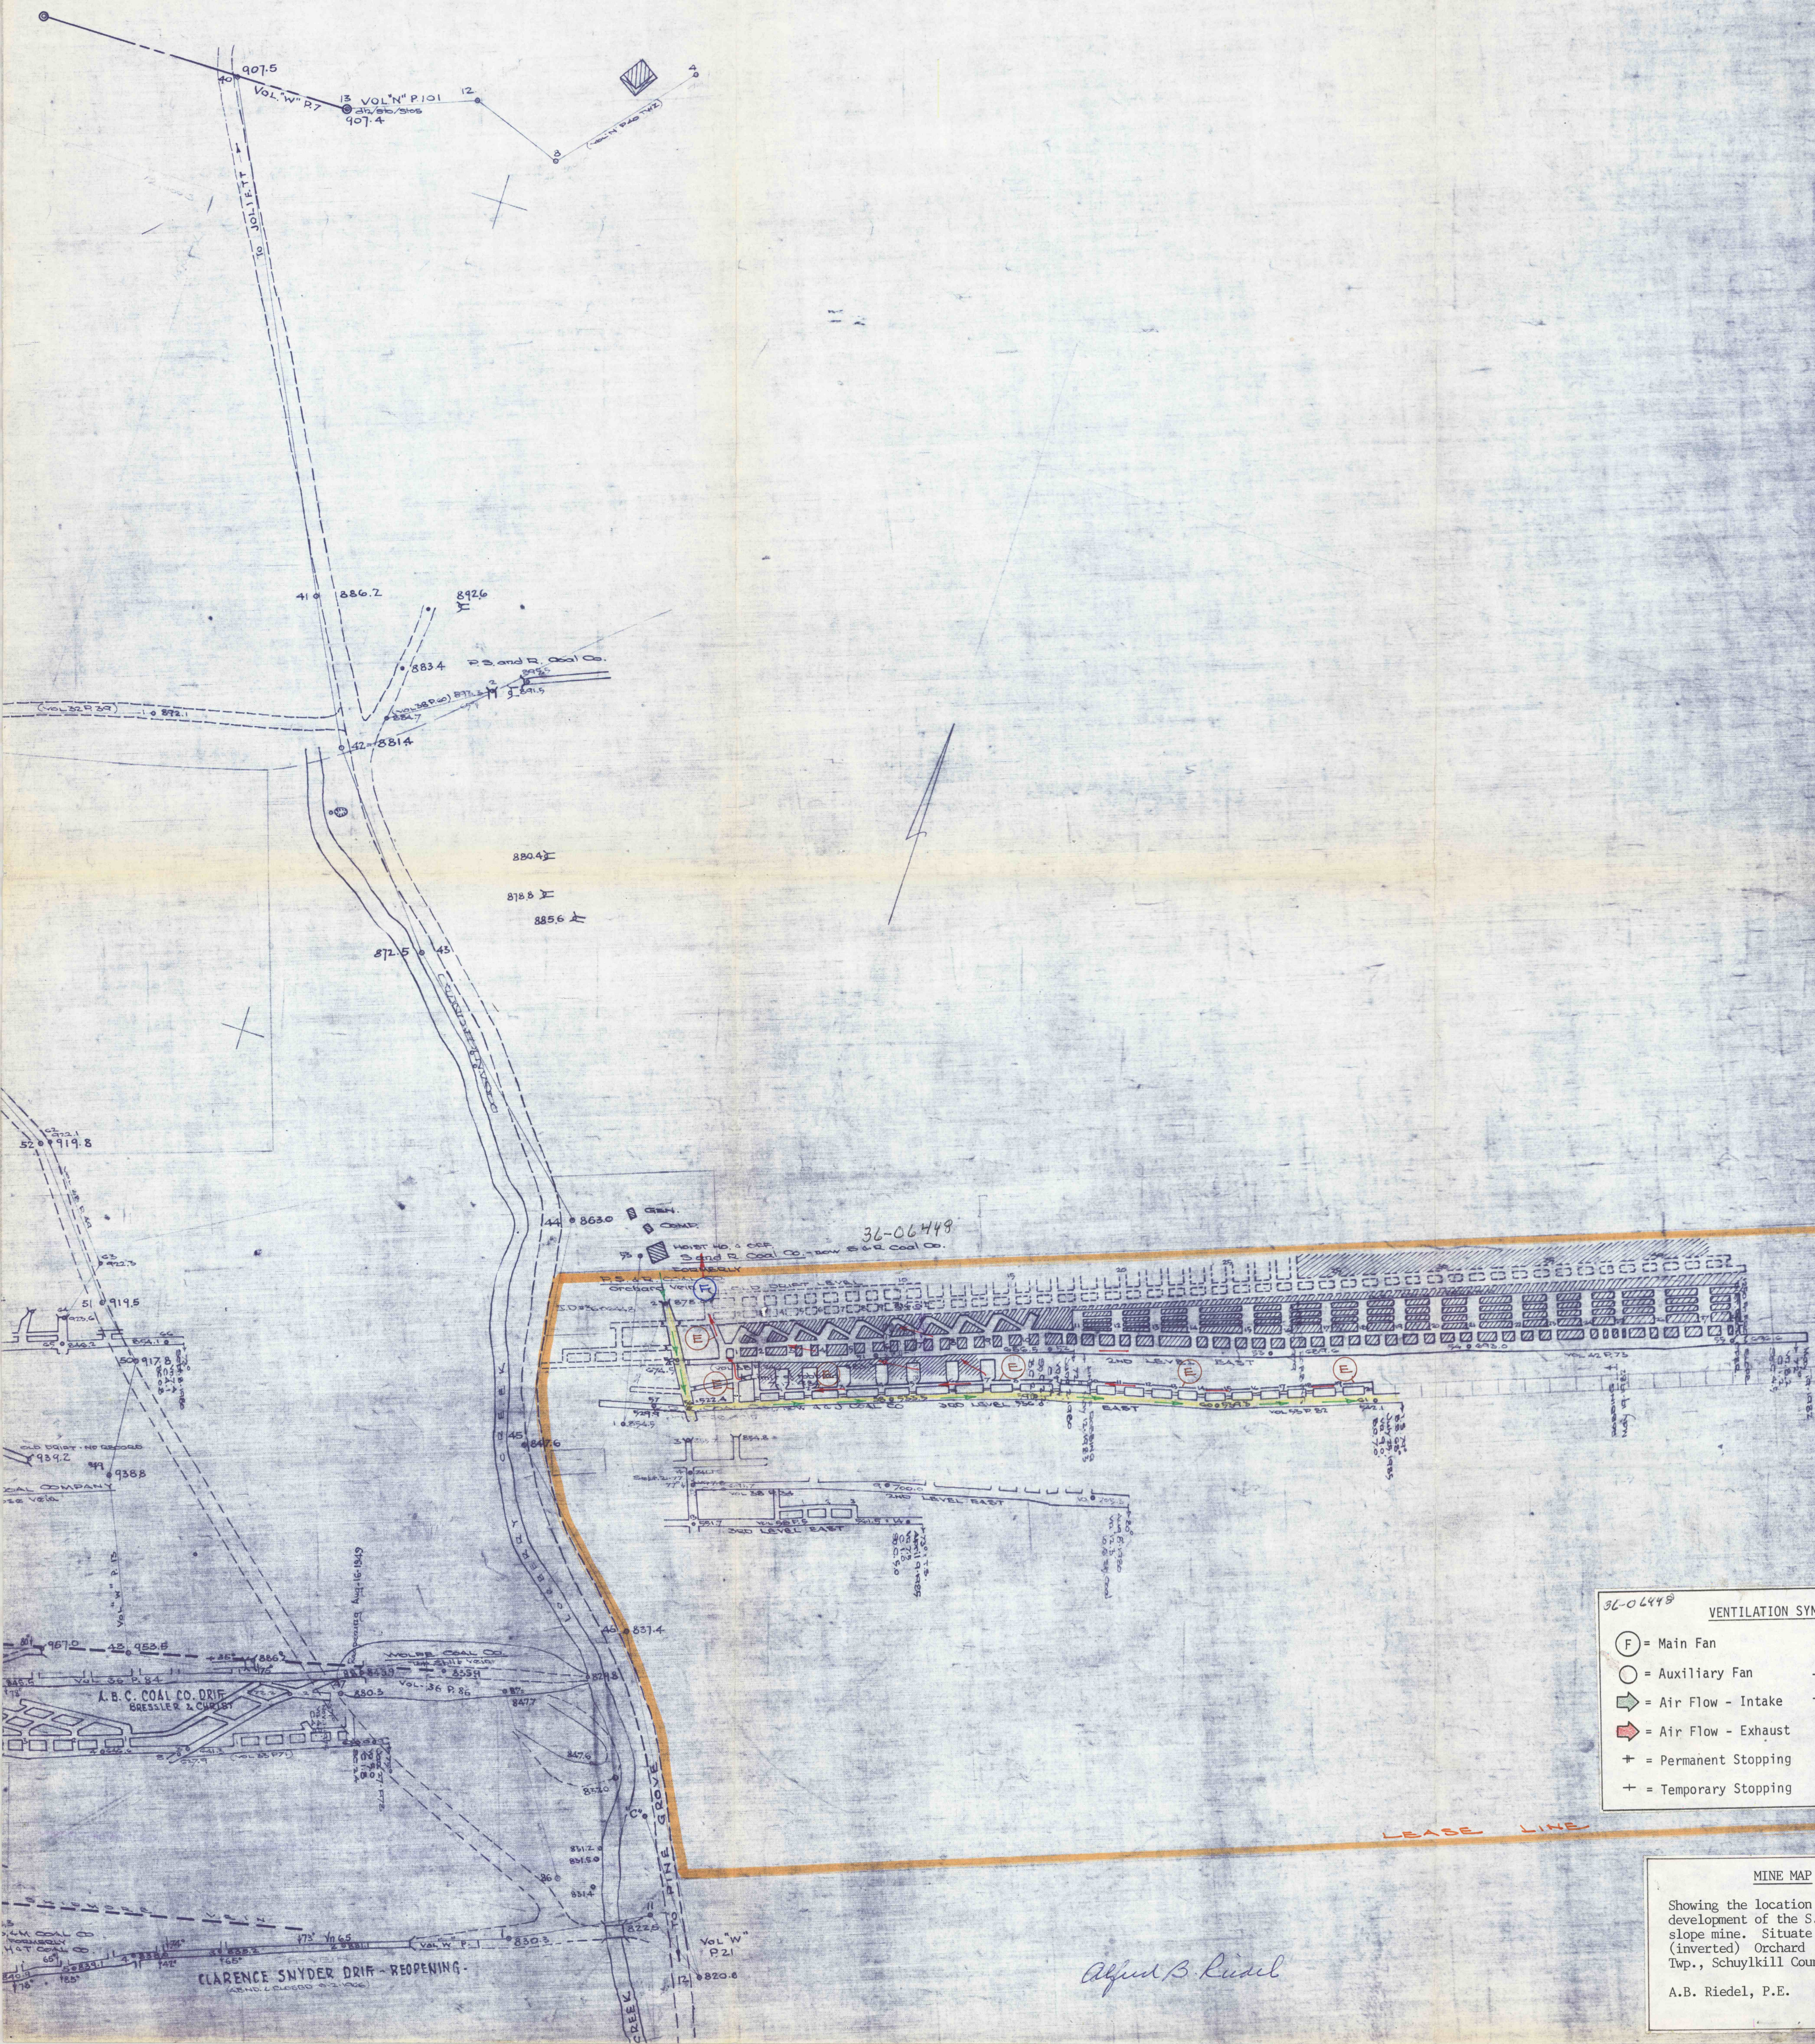

36-06448

VENTILATION SYMBOLS	
(F) = Main Fan	☐ = Air Bridge
(O) = Auxiliary Fan	⌘ = Regulator
→ = Air Flow - Intake	⋈ = Man Door
⇨ = Air Flow - Exhaust	V = Velocity, fpm
⊕ = Permanent Stopping	Q = Quantity, cfm
⊕ = Temporary Stopping	WG = Water Gauge

MINE MAP

Showing the location and extent of development of the S. & R. Coal Co. slope mine. Situate on the S. dip (inverted) Orchard Vein, Tremont Twp., Schuylkill County, Pa.

A.B. Riedel, P.E. July 25, 1985
Scale 1"= 100'