


TREMONT TWP.


SCHUYLKILL COUNTY

JOHN HUBER WARRANT

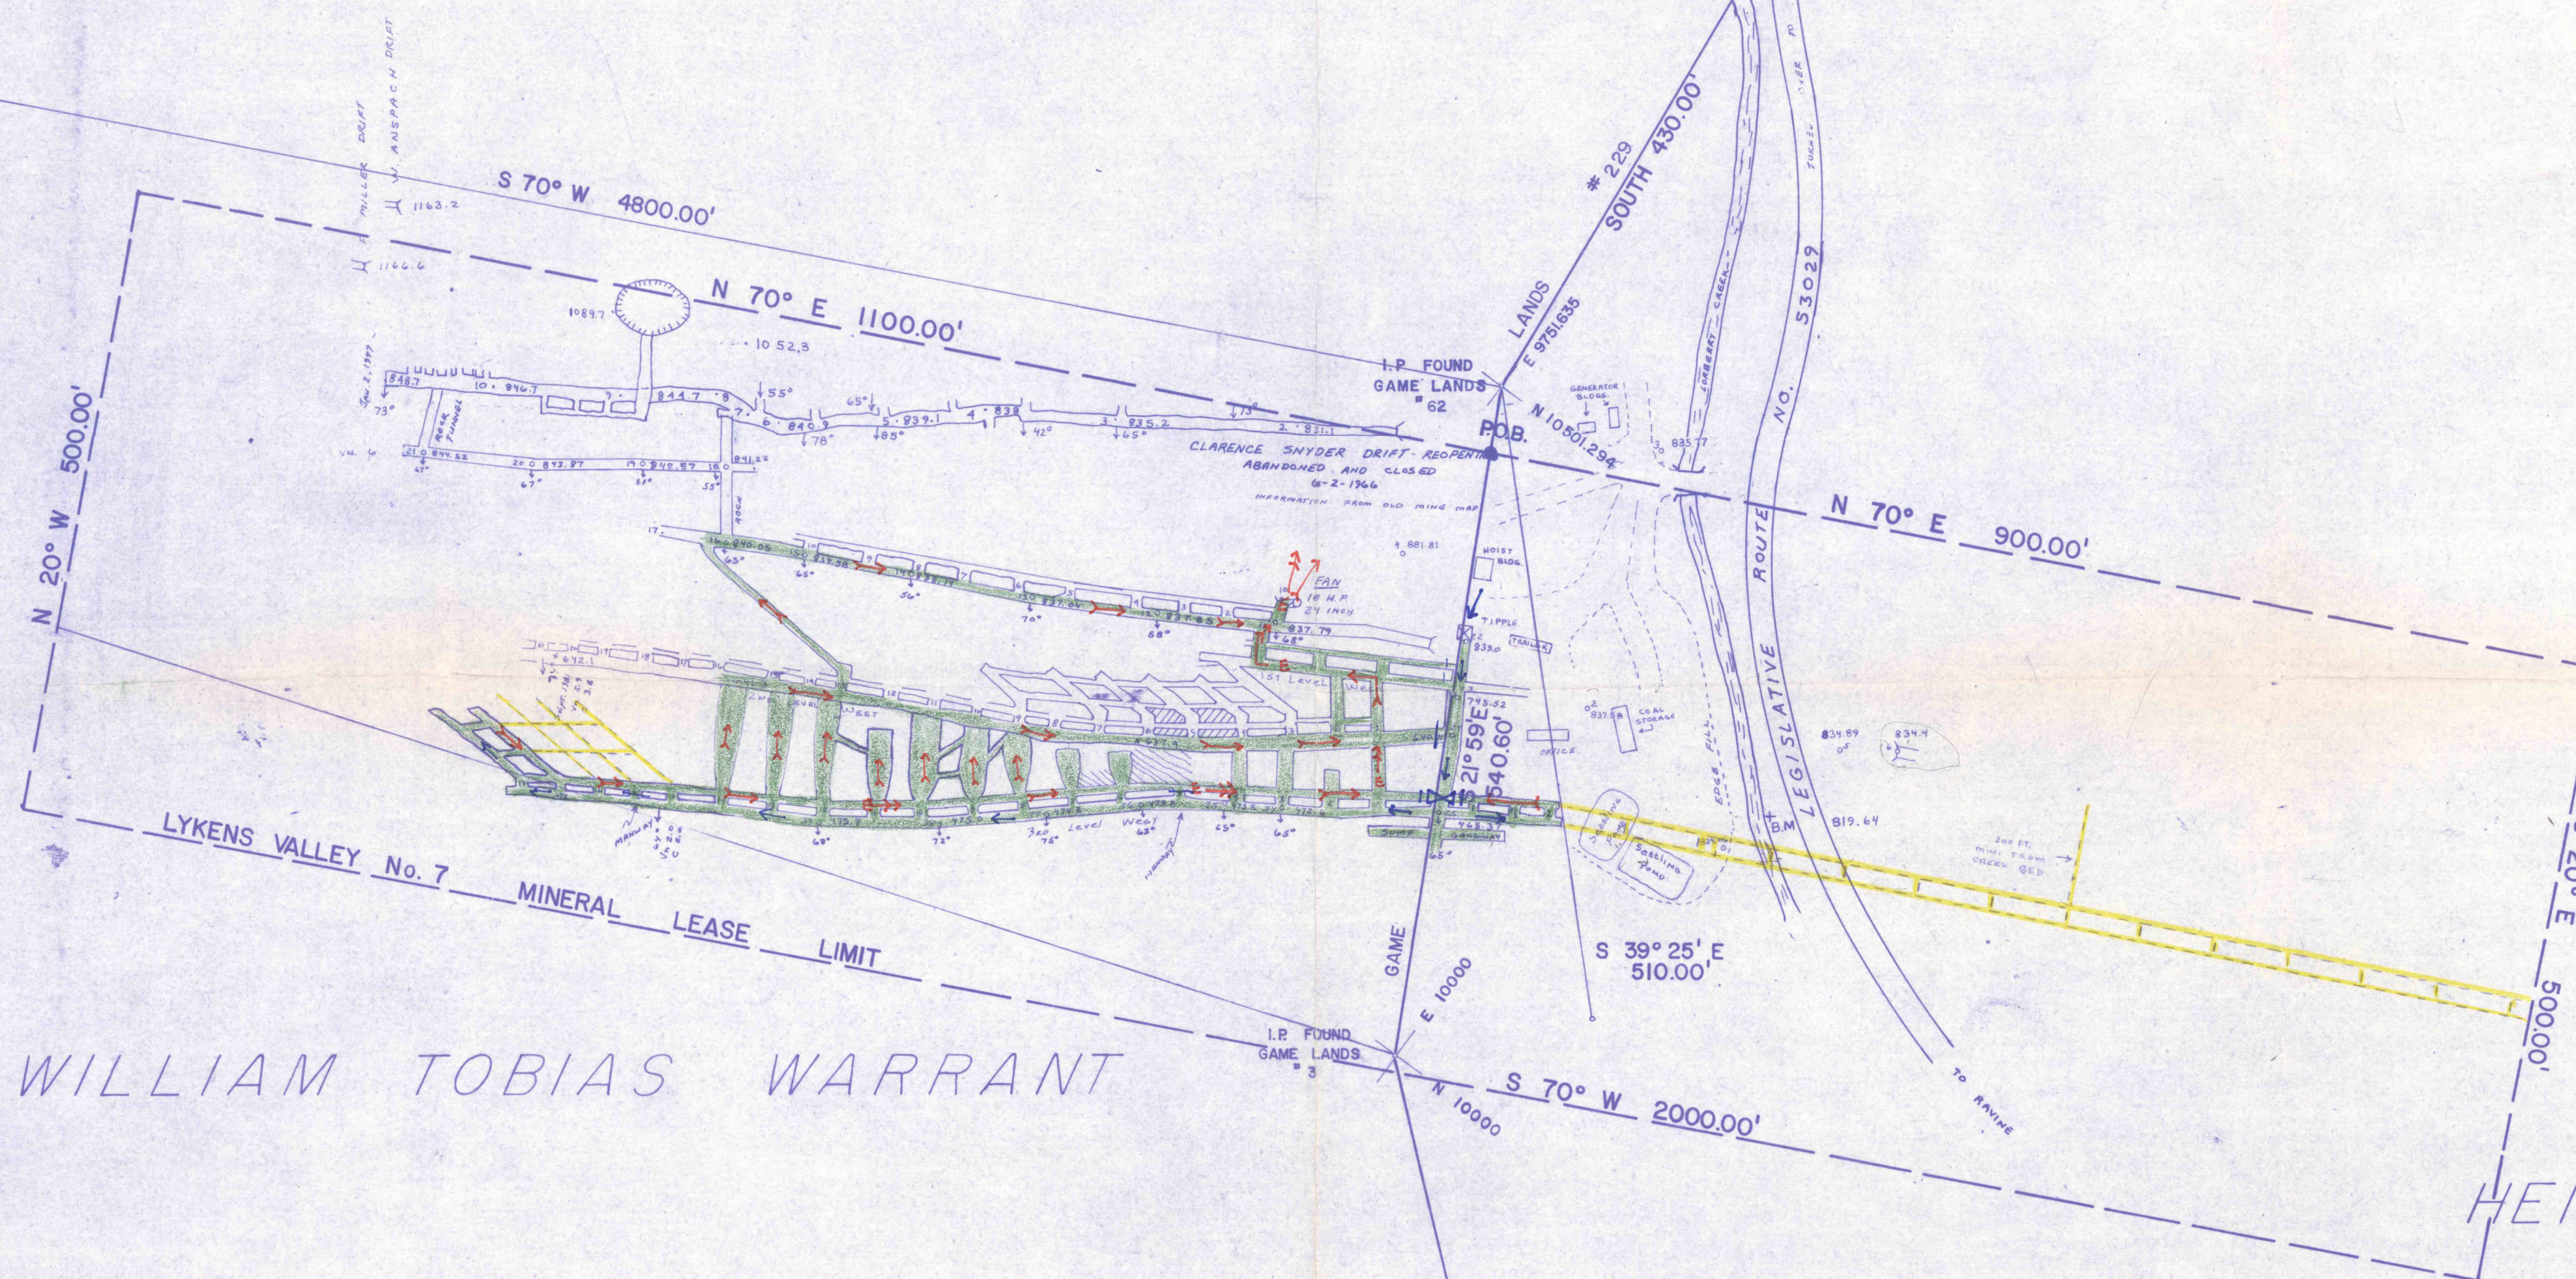


WILLIAM TOBIAS WARRANT

HENRY FEATHER WARRANT

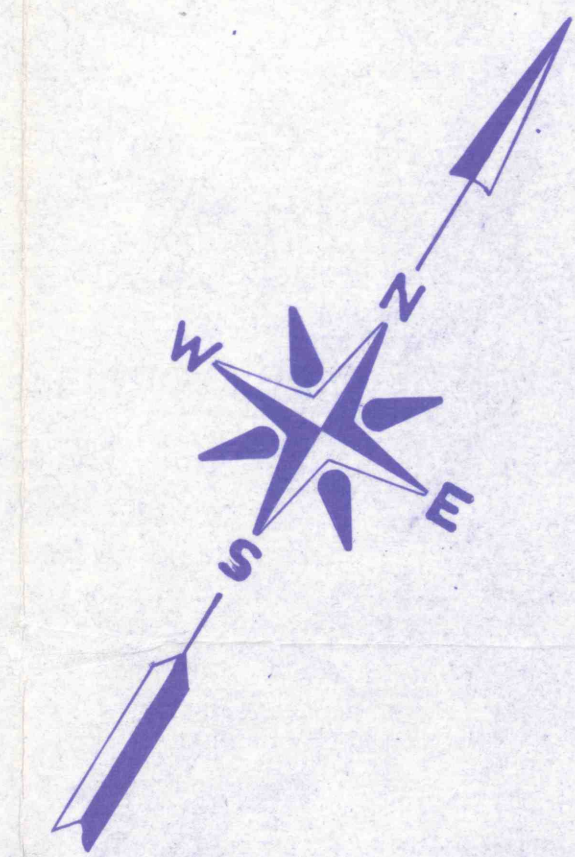


LOCATION MAP

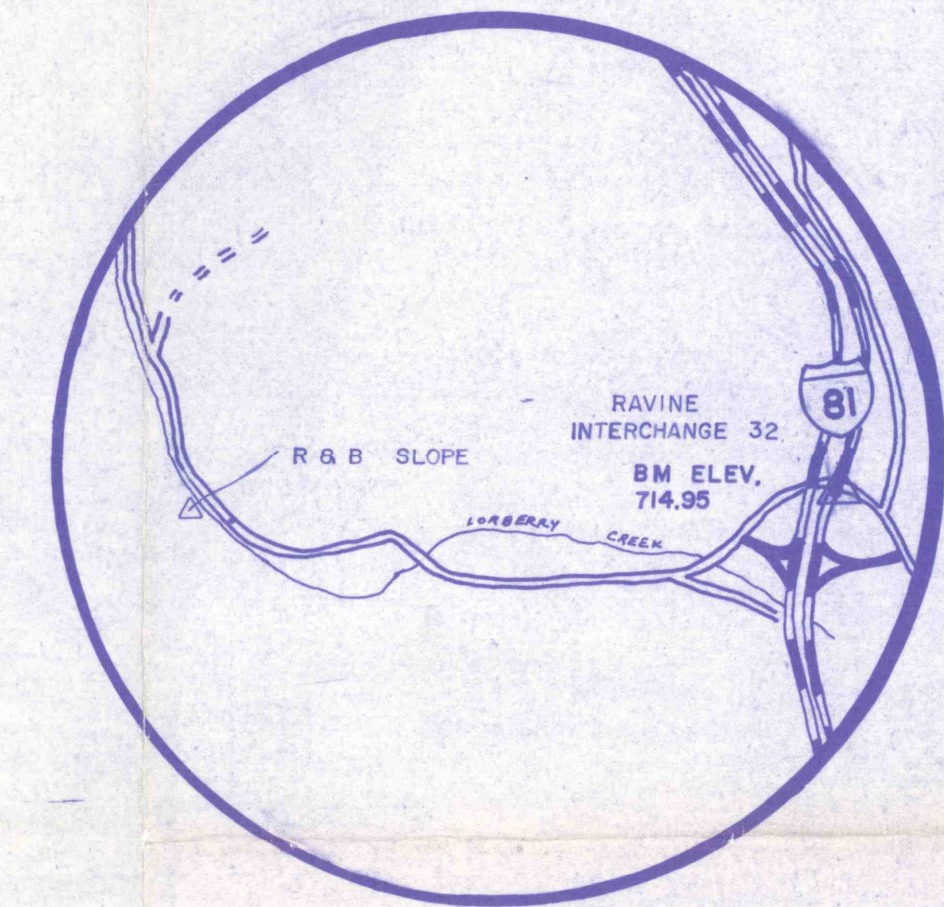


I, the undersigned, hereby certify that this map is correct and shows all the information, to the best of my knowledge and belief, required by the mining laws of this state, and covers the period ending: Jan 5 1986

Signed: *Michael A. Benz*

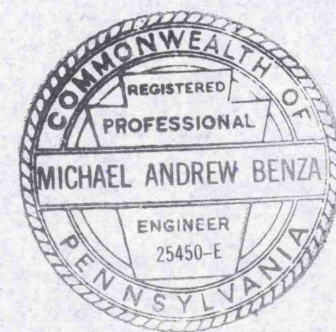

SCALE :

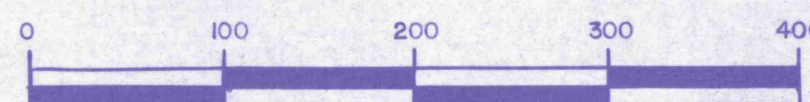


LEGEND

- INTAKE AIR →
- RETURN AIR →
- ESCAPEWAY →
- ACTIVE WORKINGS →
- PROPOSED WORKINGS →
- OVERCAST →

PENNA. GAME COMM. COMMON LINES

STA.	BRG.	DIST.
G.L. 60 - 61	N 64° 36' E	289.9'
G.L. 61 - 62	S 05° 22' E	428.2'
G.L. 62 - 3	S 27° 21' E	540.6'
G.L. 3 - 4	S 49° 00' E	1600.0'

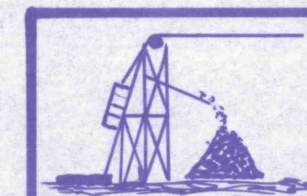

BARNHART COAL CO.

R & B SLOPE
LYKENS VALLEY No. 7
I.D. No. 36-05593
RD. 1 BOX 104
WILLIAMSTOWN, PA. 17098

SCALE 1" = 100'

DATE JANUARY 5, 1986

DRAWN BY DAVID S. HUMERICK