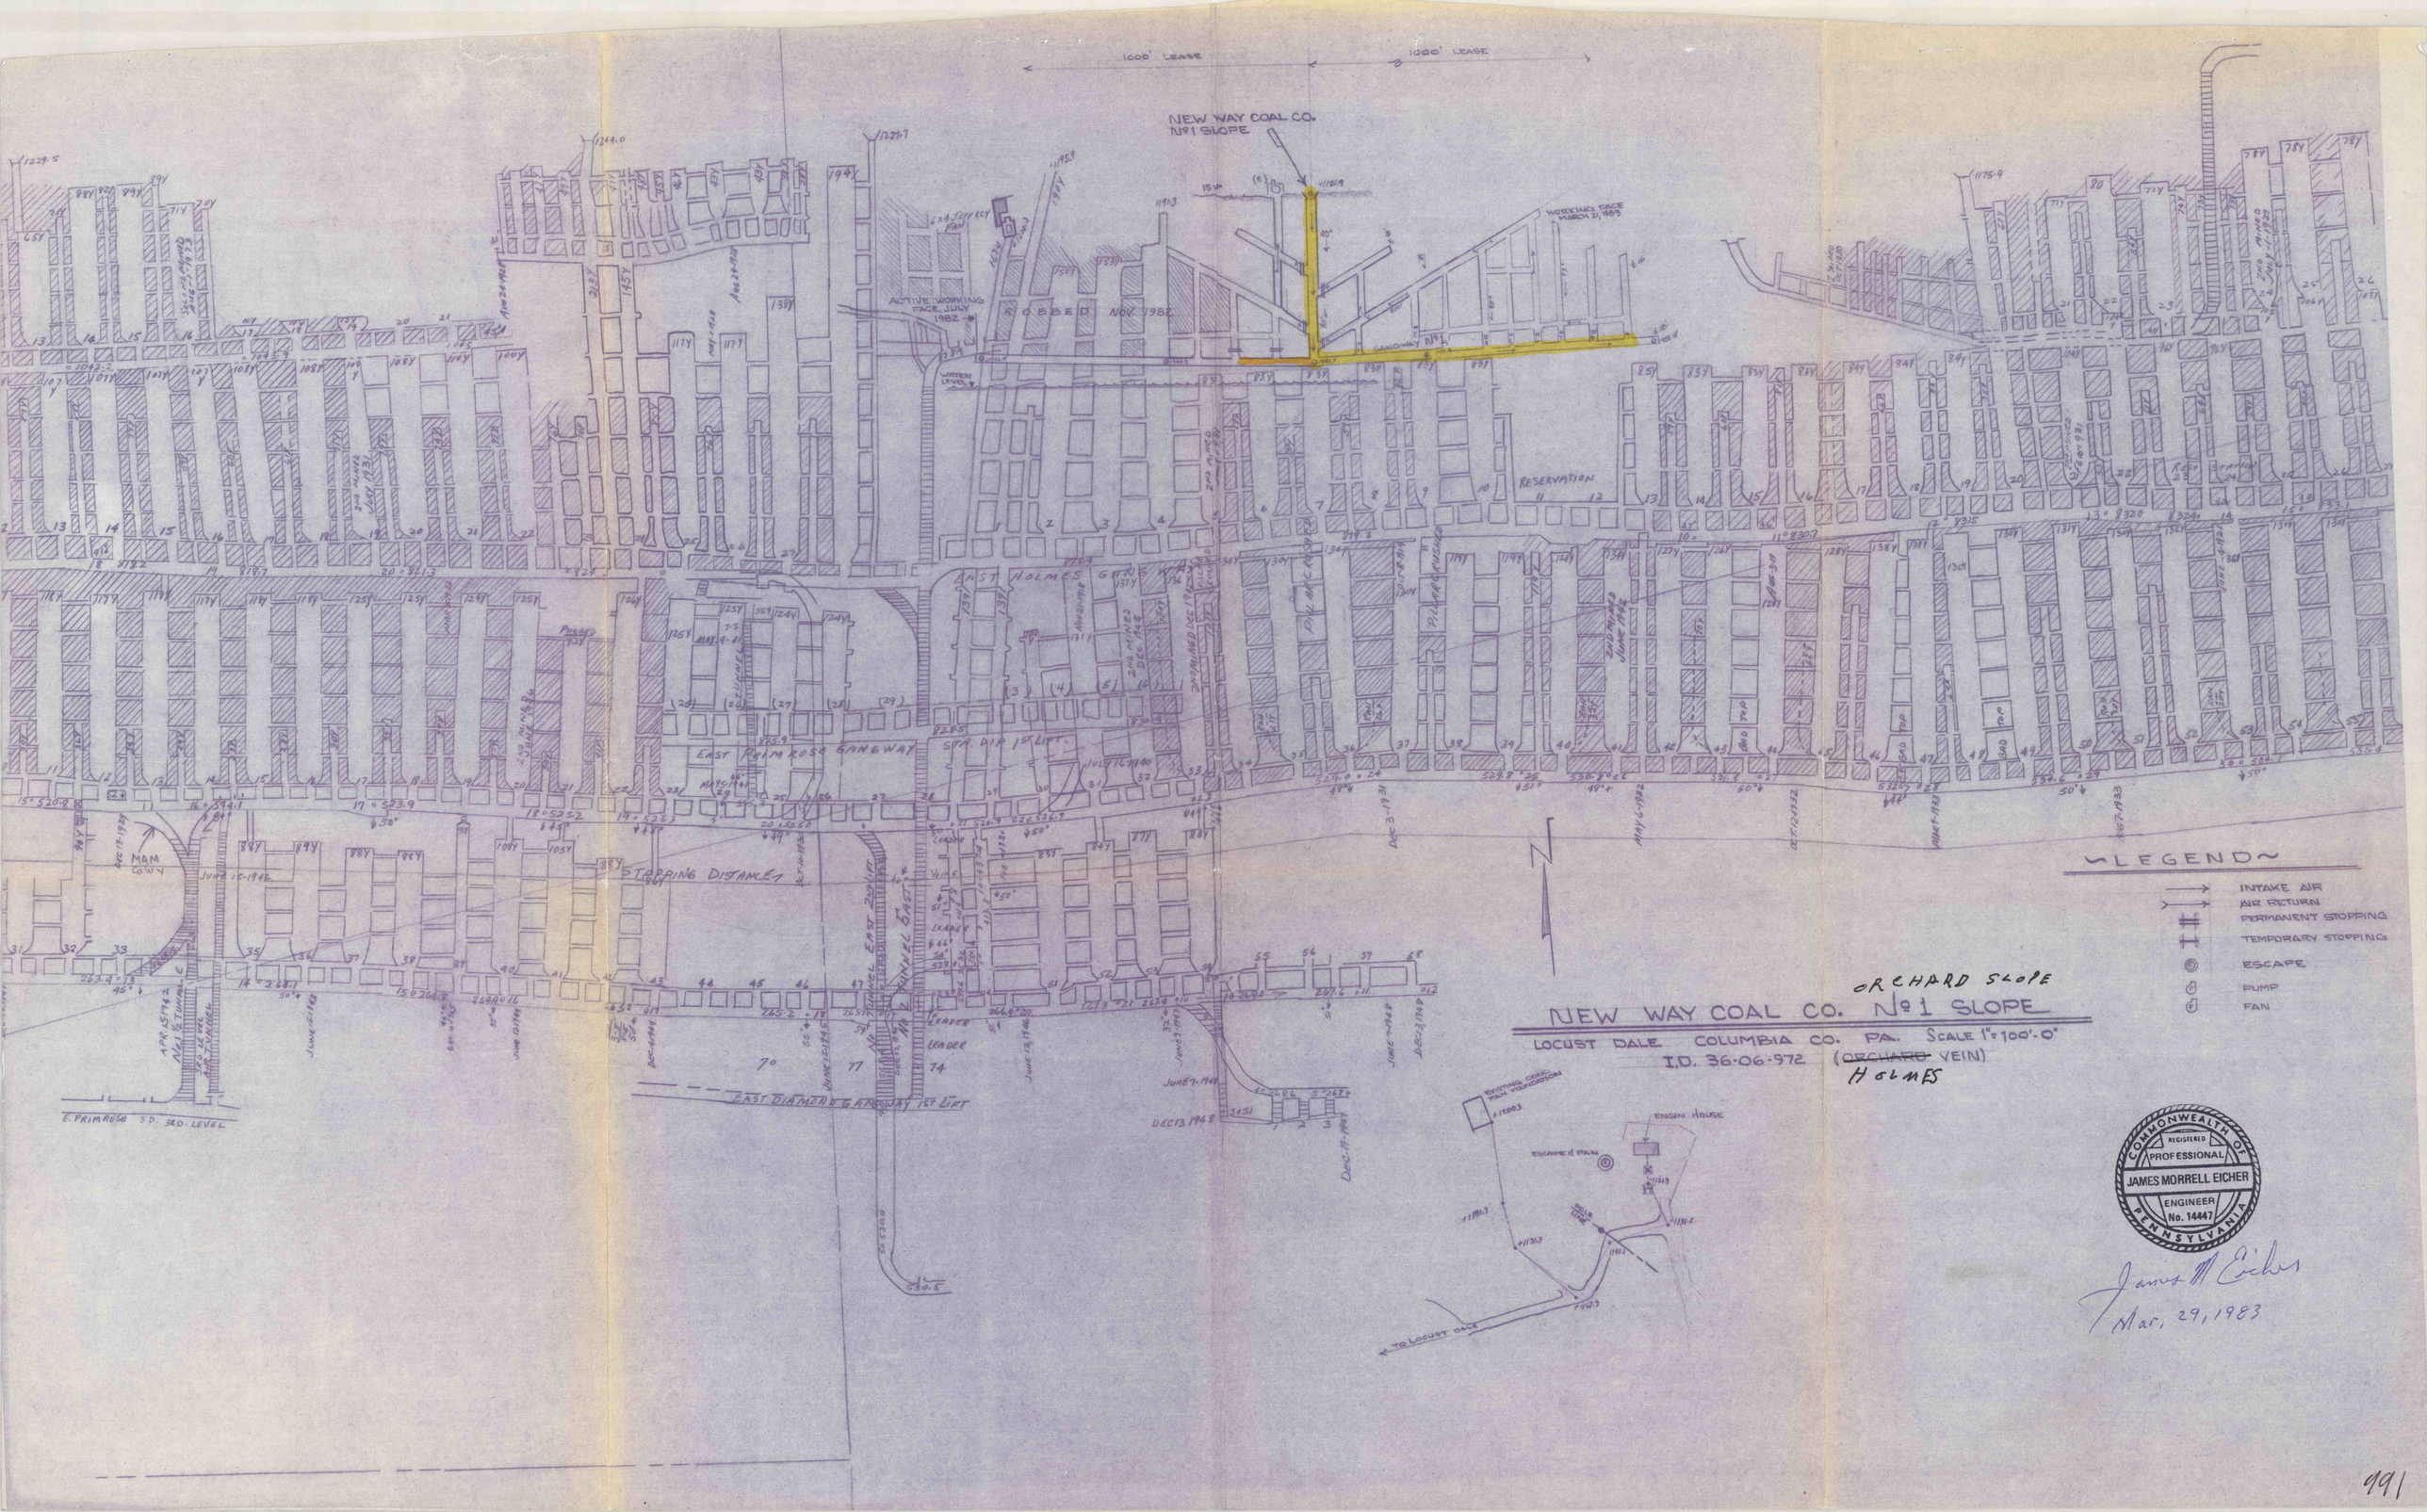
1000' LEASE
1000' LEASE
NEW WAY COAL CO.
Nº1 SLOPE
WORKING FACE MARCH 21, 1983
ACTIVE WORKING FACE, JULY 1982
ROBBED NOV 1982
WATER LEVEL
GANGWAY Nº1
RESERVATION
EAST HOLMES GANGWAY
EAST PRIMROSE GANGWAY
STA. DIA 1ST LIFT.
STOPPING DISTANCE
EAST DIAMOND GANGWAY 1ST LIFT
E. PRIMROSE SD. 3RD. LEVEL
LEGEND
INTAKE AIR
AIR RETURN
PERMANENT STOPPING
TEMPORARY STOPPING
ESCAPE
PUMP
FAN
ORCHARD SLOPE
NEW WAY COAL CO. Nº1 SLOPE
LOCUST DALE COLUMBIA CO. PA. SCALE 1"=100'-0"
I.D. 36-06-972 (~~ORCHARD~~ VEIN)
HOLMES
ENGIN HOUSE
ESCAPE & FAN
TO LOCUST DALE
COMMONWEALTH OF PENNSYLVANIA
REGISTERED PROFESSIONAL
JAMES MORRELL EICHER
ENGINEER
No. 14447
James M Eicher
Mar. 29, 1983

991