



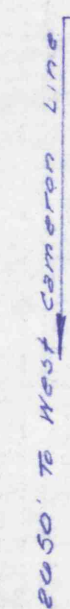

- 1- Tie in with HAT, TAG, BJ, Triple S.
Cool Co. & PRC-I properly
- 2- Vert with PRC-I and USC&GS
- 3- See Coord. points posted at mine

1093
TUBE
1054
Start Right 978
902 No. 1 Gangway
880
Gangway Jump

Section Looking West

- ⊕ - Indicates Fan
- ⊙ - " Escapeway
- - " Air Intake
- || - " Temporary Stopping
- - " Permanent Stopping
- ↪ - " Return Air
- o - " Survey Points surface UG

WAGNER

WAGNER ASSOCIATES, INC.
Engineers • Architects • Planners • Surveyors

312 Mauch Chunk Street, Pottsville, PA, 17901

Situate in the Township of Zerbe
County of Northumberland County, Pa.

Lone Pine Coal Company
No. 13 Vein (Little Orchard) Coal Bed
I.D. - 36 - 07063

Post Pottsville Formation

ISSUE DATE : 10/22/82

SCALE : 1" = 100'

DATE : 10/27/82

DWG. BY : *M. J. N.*

CHKD BY: *SB*

ORDER NO : 5127-A

92140

994