
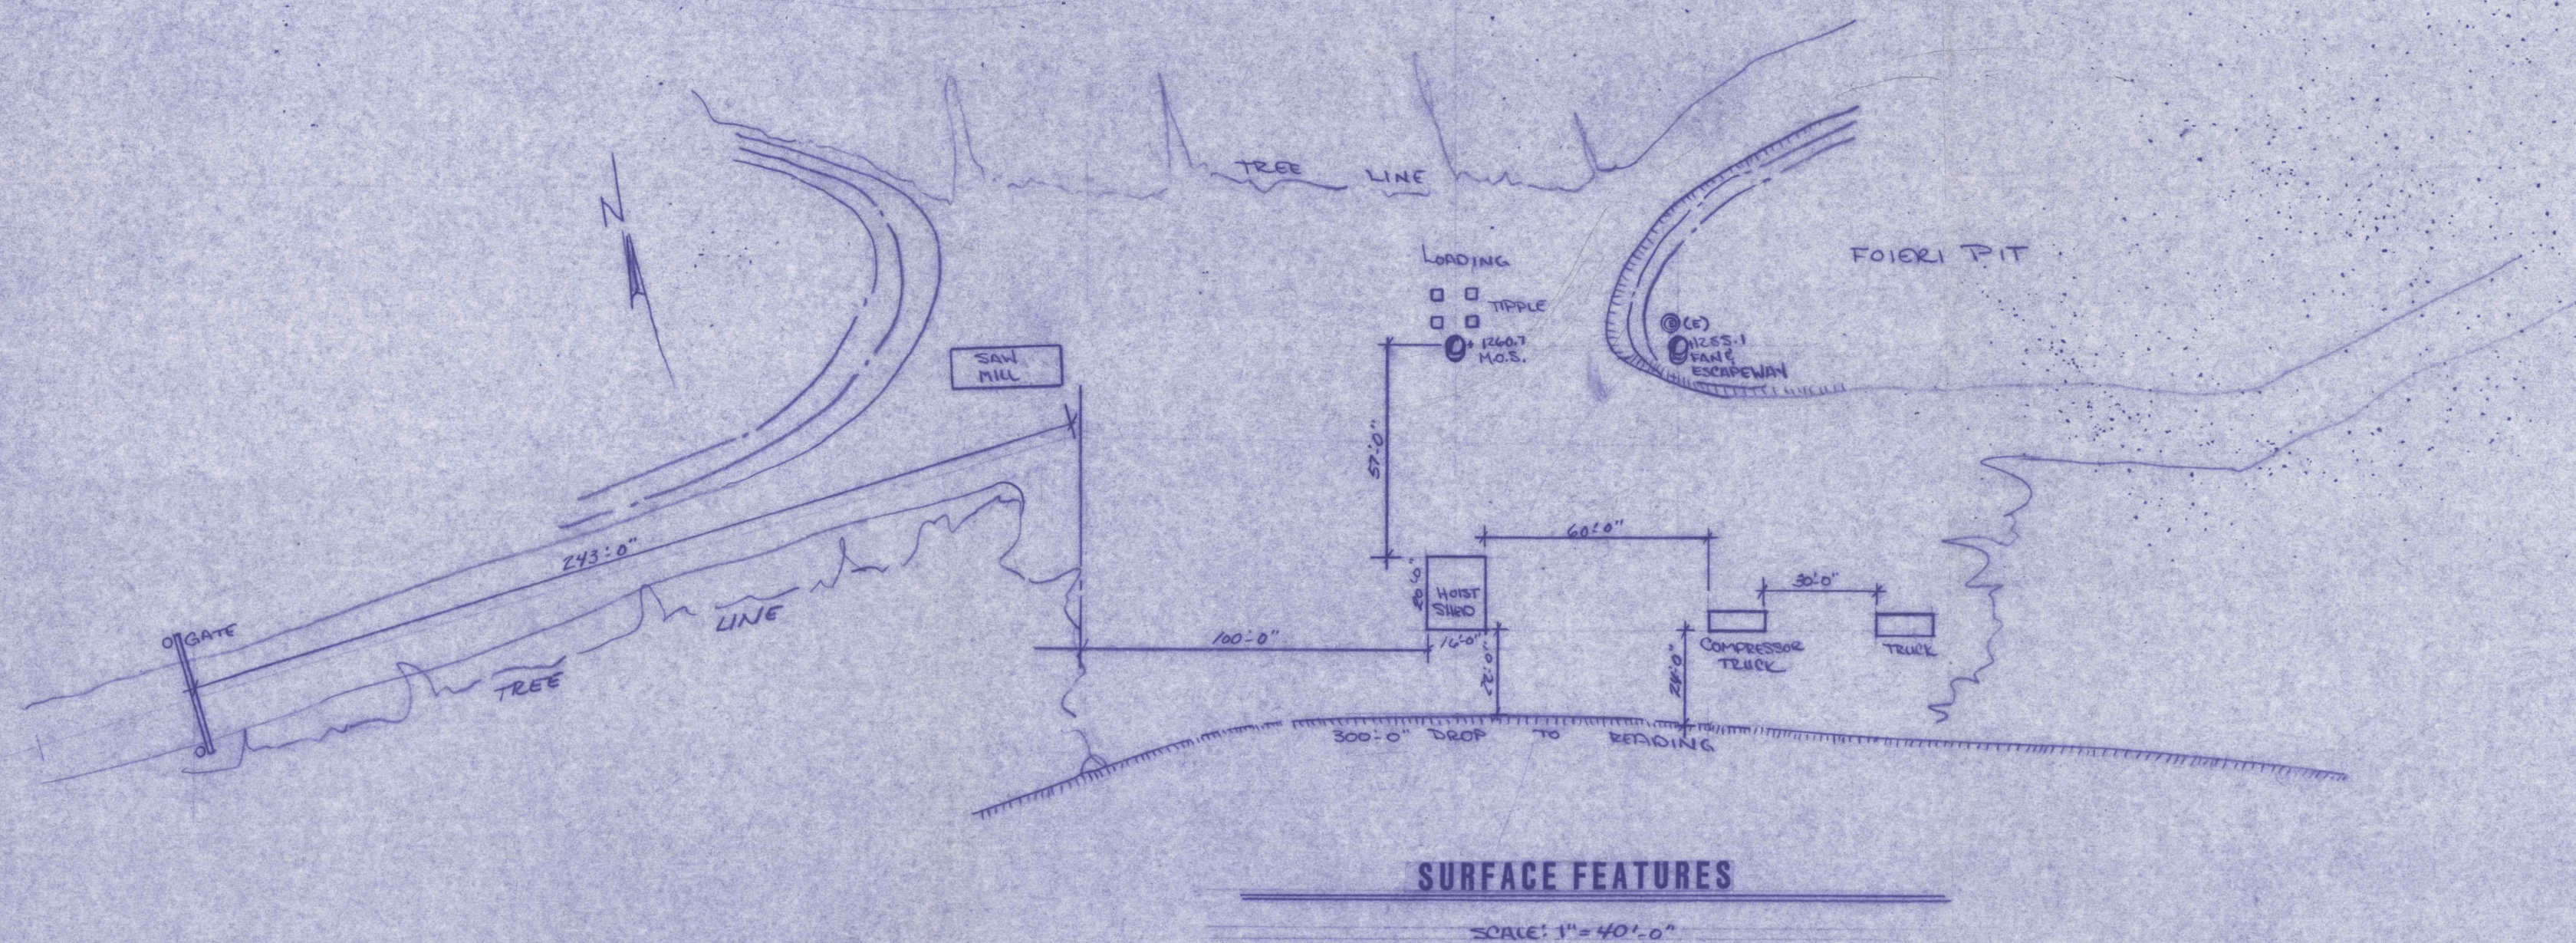


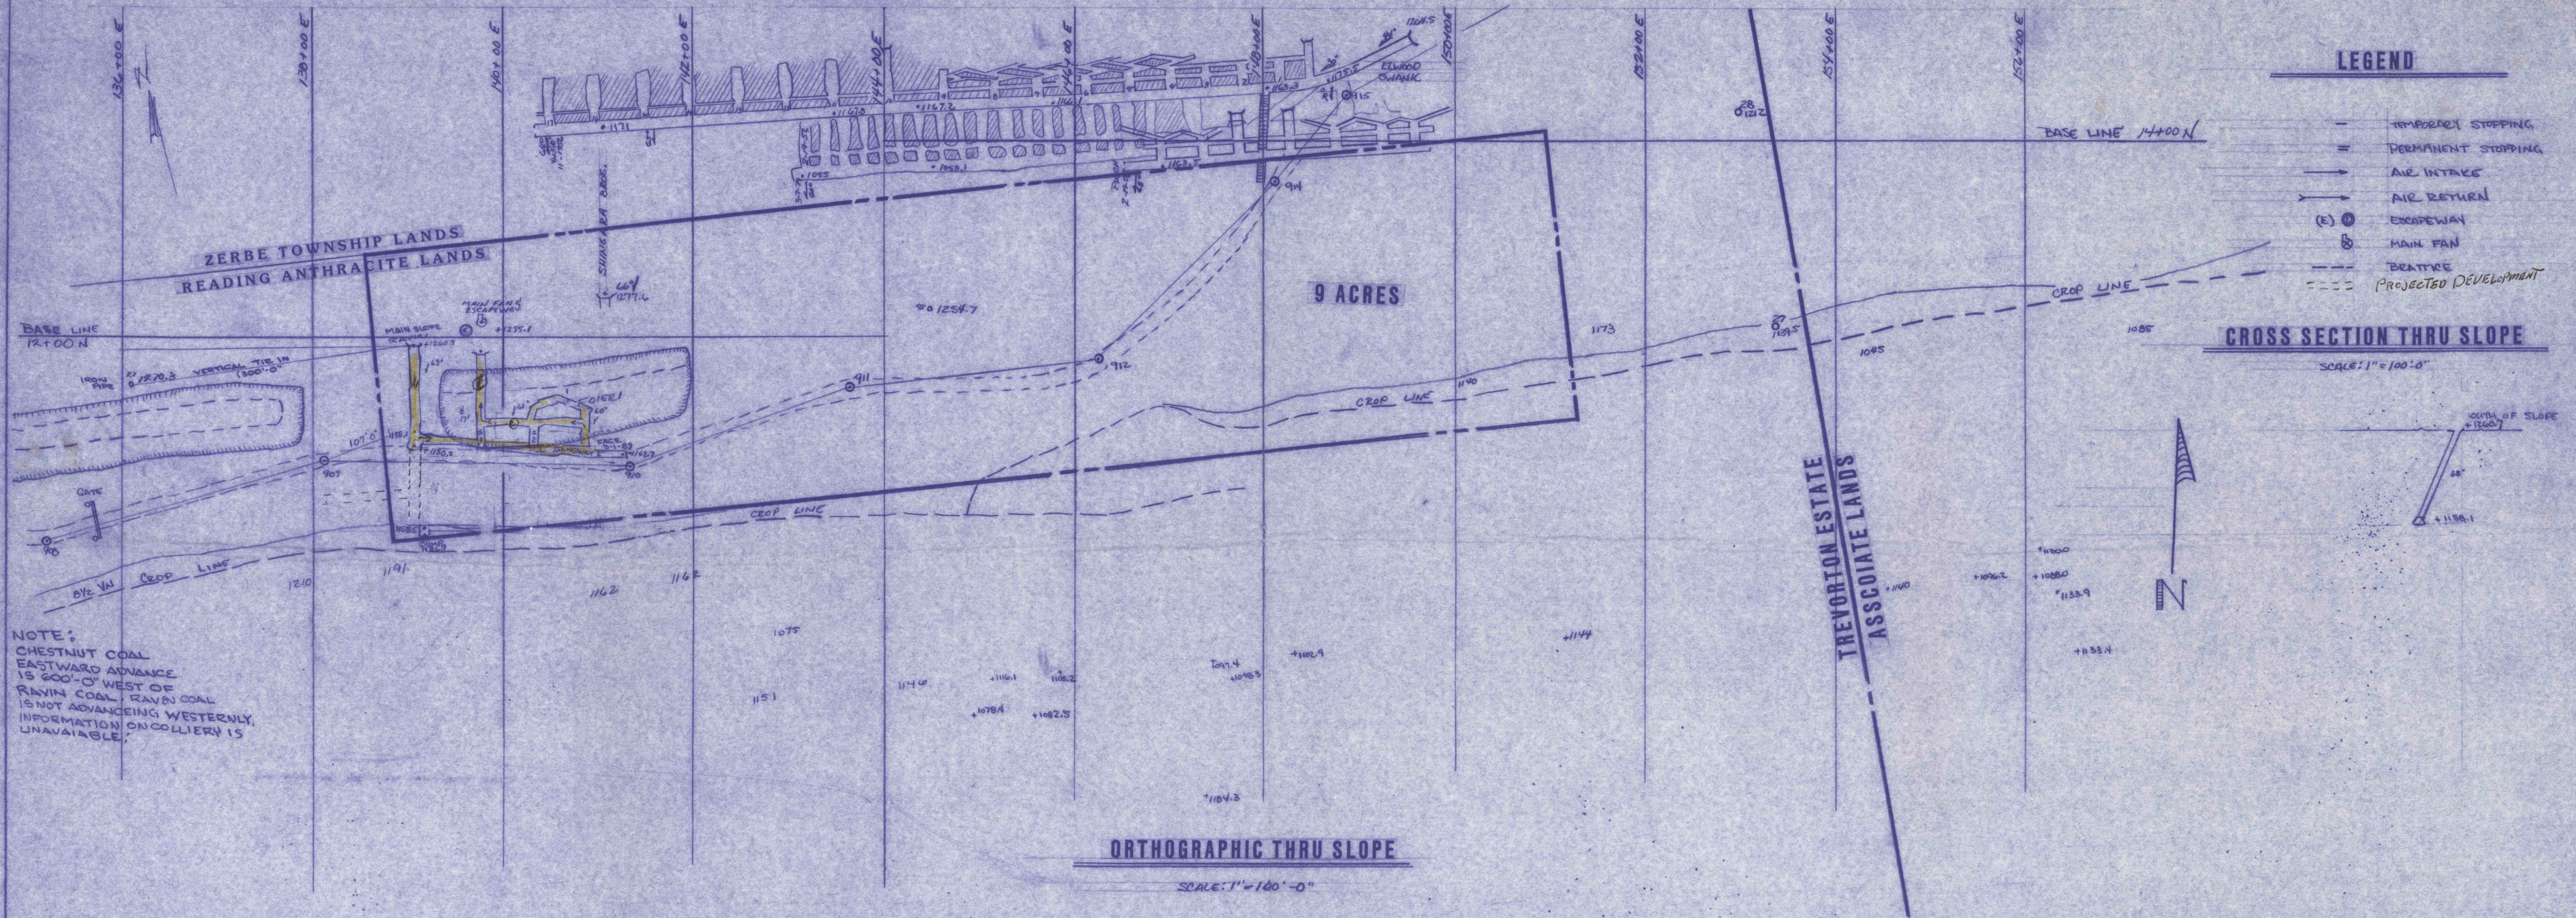

RAVEN COAL CO.
6 VEIN
NO. 1 SLOPE
ZERBE TWP. NORTH'D CO.
ID-36-07112

April 11, 1989