

WILLIAM LAMBERT TRACT


THOMAS REESE JR. TRACT

WILLIAM LANE TRACT

MARY LANE TRACT

TWO WAY COAL COMPANY

No. 7 Vein Workings - Hickory Swamp Area
Coal Township, Northumberland County

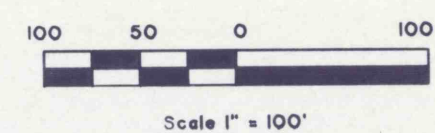

VENTILATION SYMBOLS	
(F) = Main Fan	□ = Air Bridge
(O) = Auxiliary Fan	⌈ = Regulator
→ = Air Flow - Intake	⌋ = Man Door
↗ = Air Flow - Exhaust	V = Velocity, fpm
+ = Permanent Stopping	Q = Quantity, cfm
- = Temporary Stopping	WG = Water Gauge

L. and W. Coal Company, Inc., NO. 7 SLOPE
36-07171
MINE MAP
Showing the location and extent of development
of the No. 7 Vein workings.
Situate in the Hickory Swamp Area of Coal Twp.,
Northumberland County, PA.
A.B. Riedel P.E. July 27, 1988
Scale 1" = 100'

A. B. Riedel