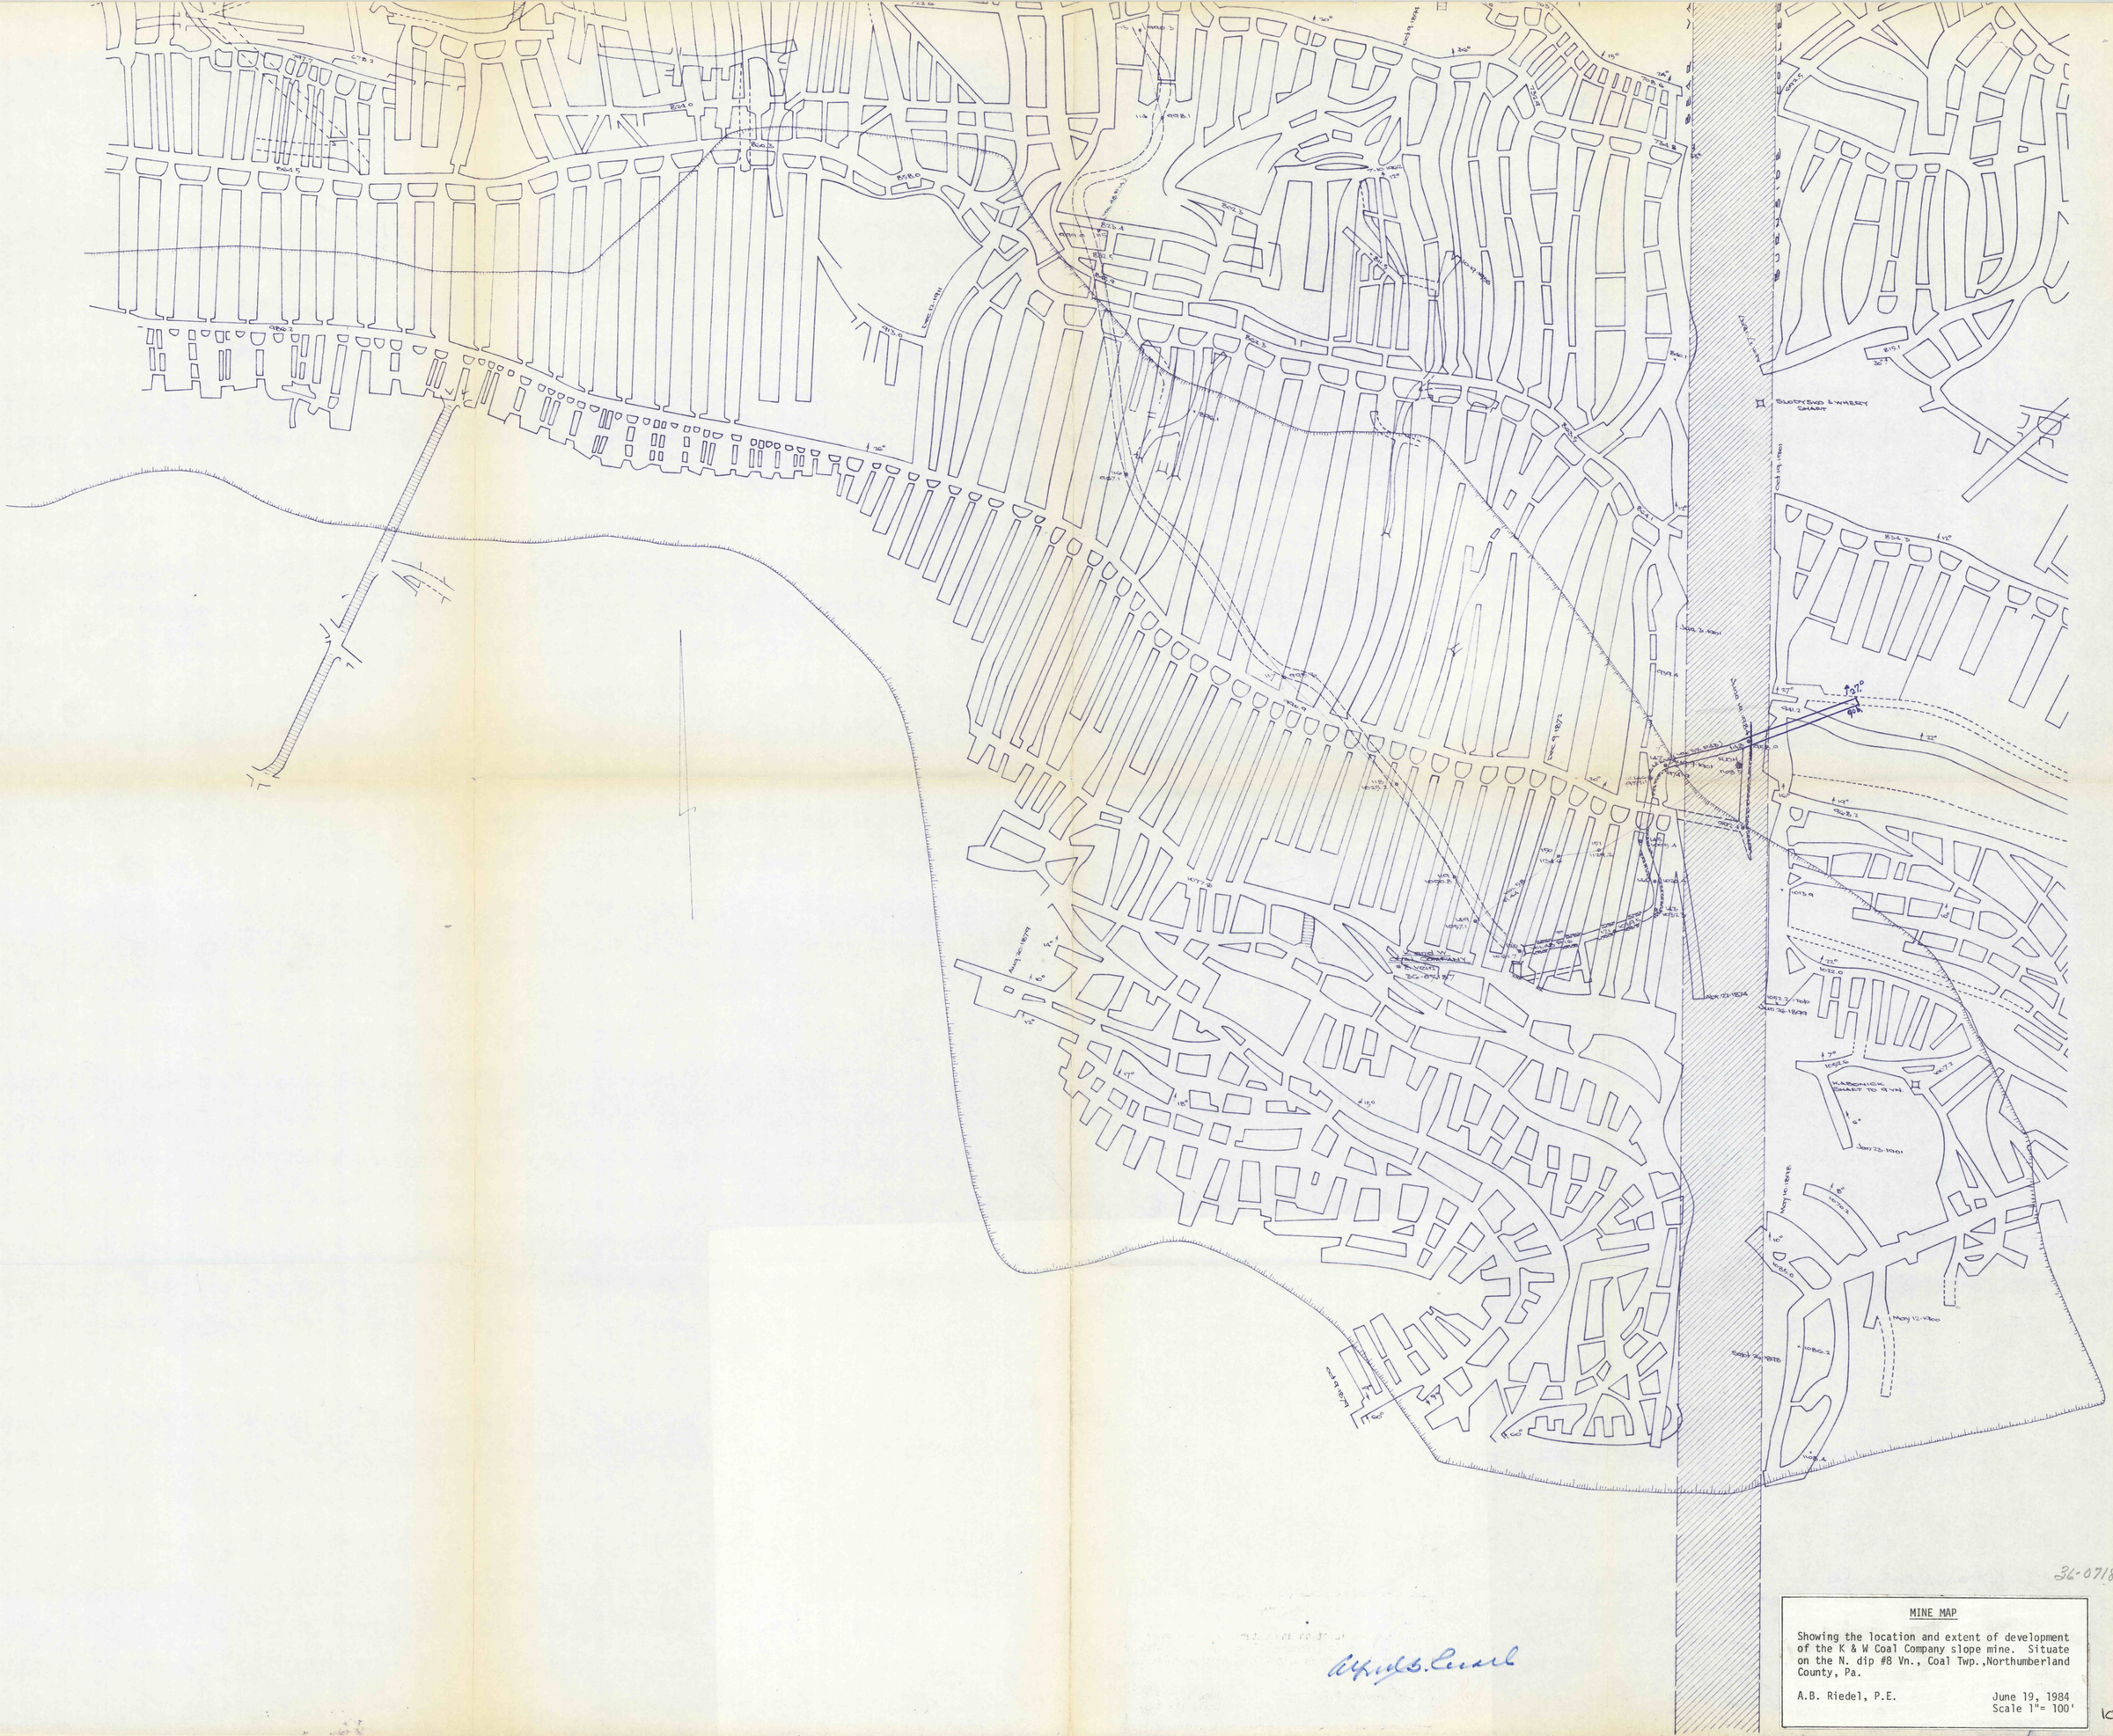
SLOPE
SHAFT
KABONICK
SHAFT TO G.V.N.
Jan 23-1901
May 10-1898
May 12-1900
Sept 26-1898
Jan 30-1899
Aug 20-1898
Feb 8-1900
Dec 19-1900
Dec 10-1904
Dec 19-1900
Dec 19-1900
Dec 19-1900