

M

U

E

L

S

C

O

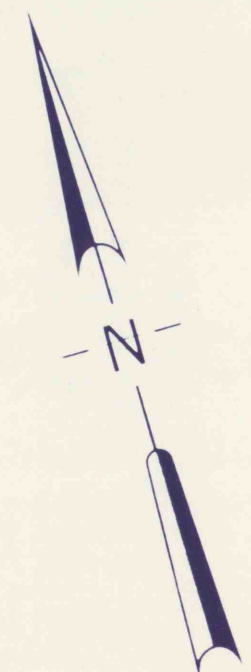
A

R

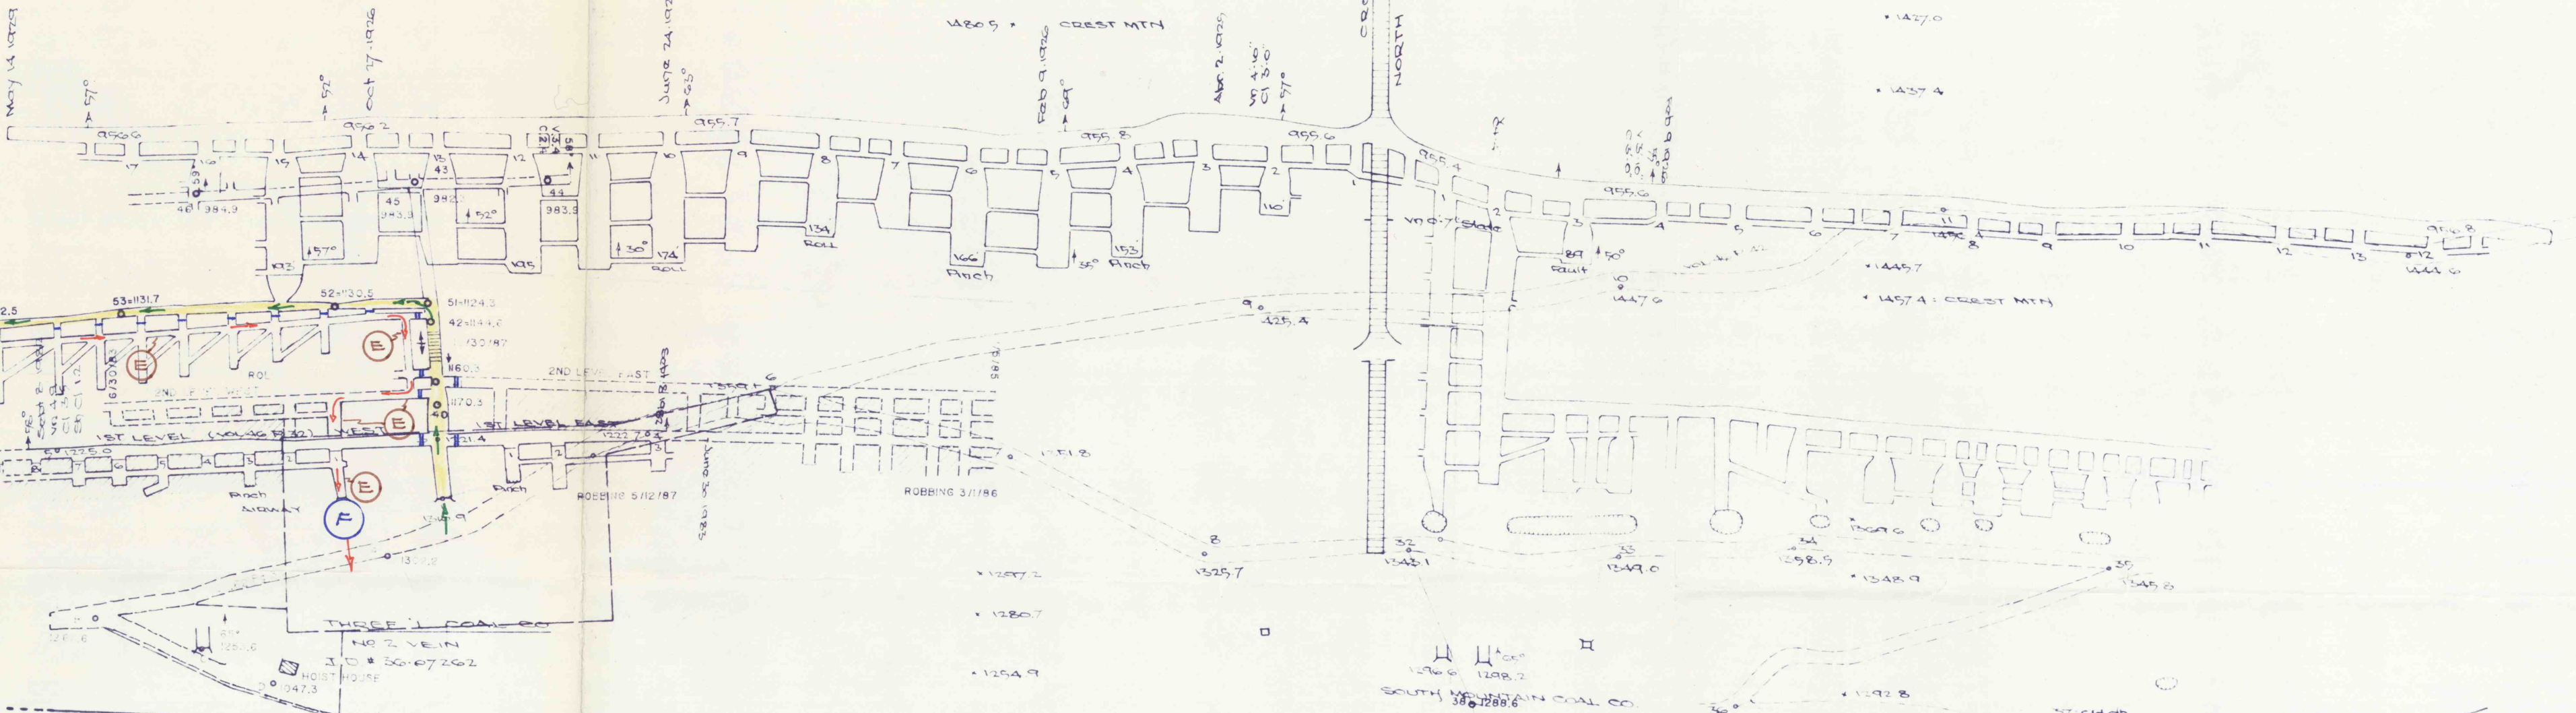
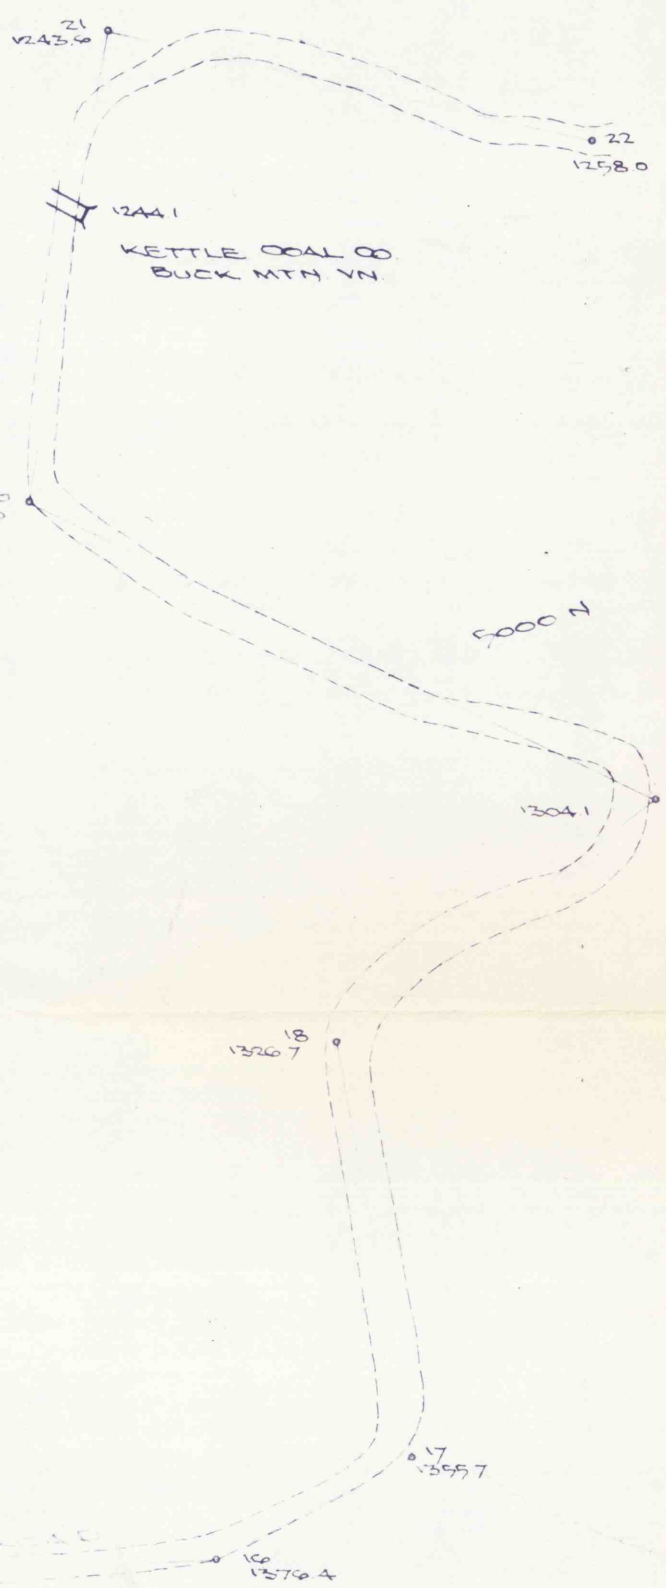
A

C

T

W
E
S
T
E
R
N
B
E
T
H
O
W
N
S
H
I
P

YEAR 11 BUCK VILLAGE

FISHES & BIERER
COAL CO.
BURN MINE VILLAGE
ABOUT JULY 1900

MINE MAP
Showing the location and extent of
development of the Three L Coal Co.
slope mine. Situated on the N. dip
of the #2 vein, West Cameron Twp.,
Northumberland County.

A.B. Riedel, P.E. Aug. 3, 1989
36-07262 Scale 1"=100'

VENTILATION SYMBOLS	
(F) = Main Fan	□ = Air Bridge
(A) = Auxiliary Fan	⊥ = Regulator
→ = Air Flow - Intake	⋈ = Man Door
→ = Air Flow - Exhaust	V = Velocity, fpm
+ = Permanent Stopping	Q = Quantity, cfm
+ = Temporary Stopping	WG = Water Gauge

MINE PROPERTY
THE COMPLETE SCOTT TRACT

August 3, 1989