


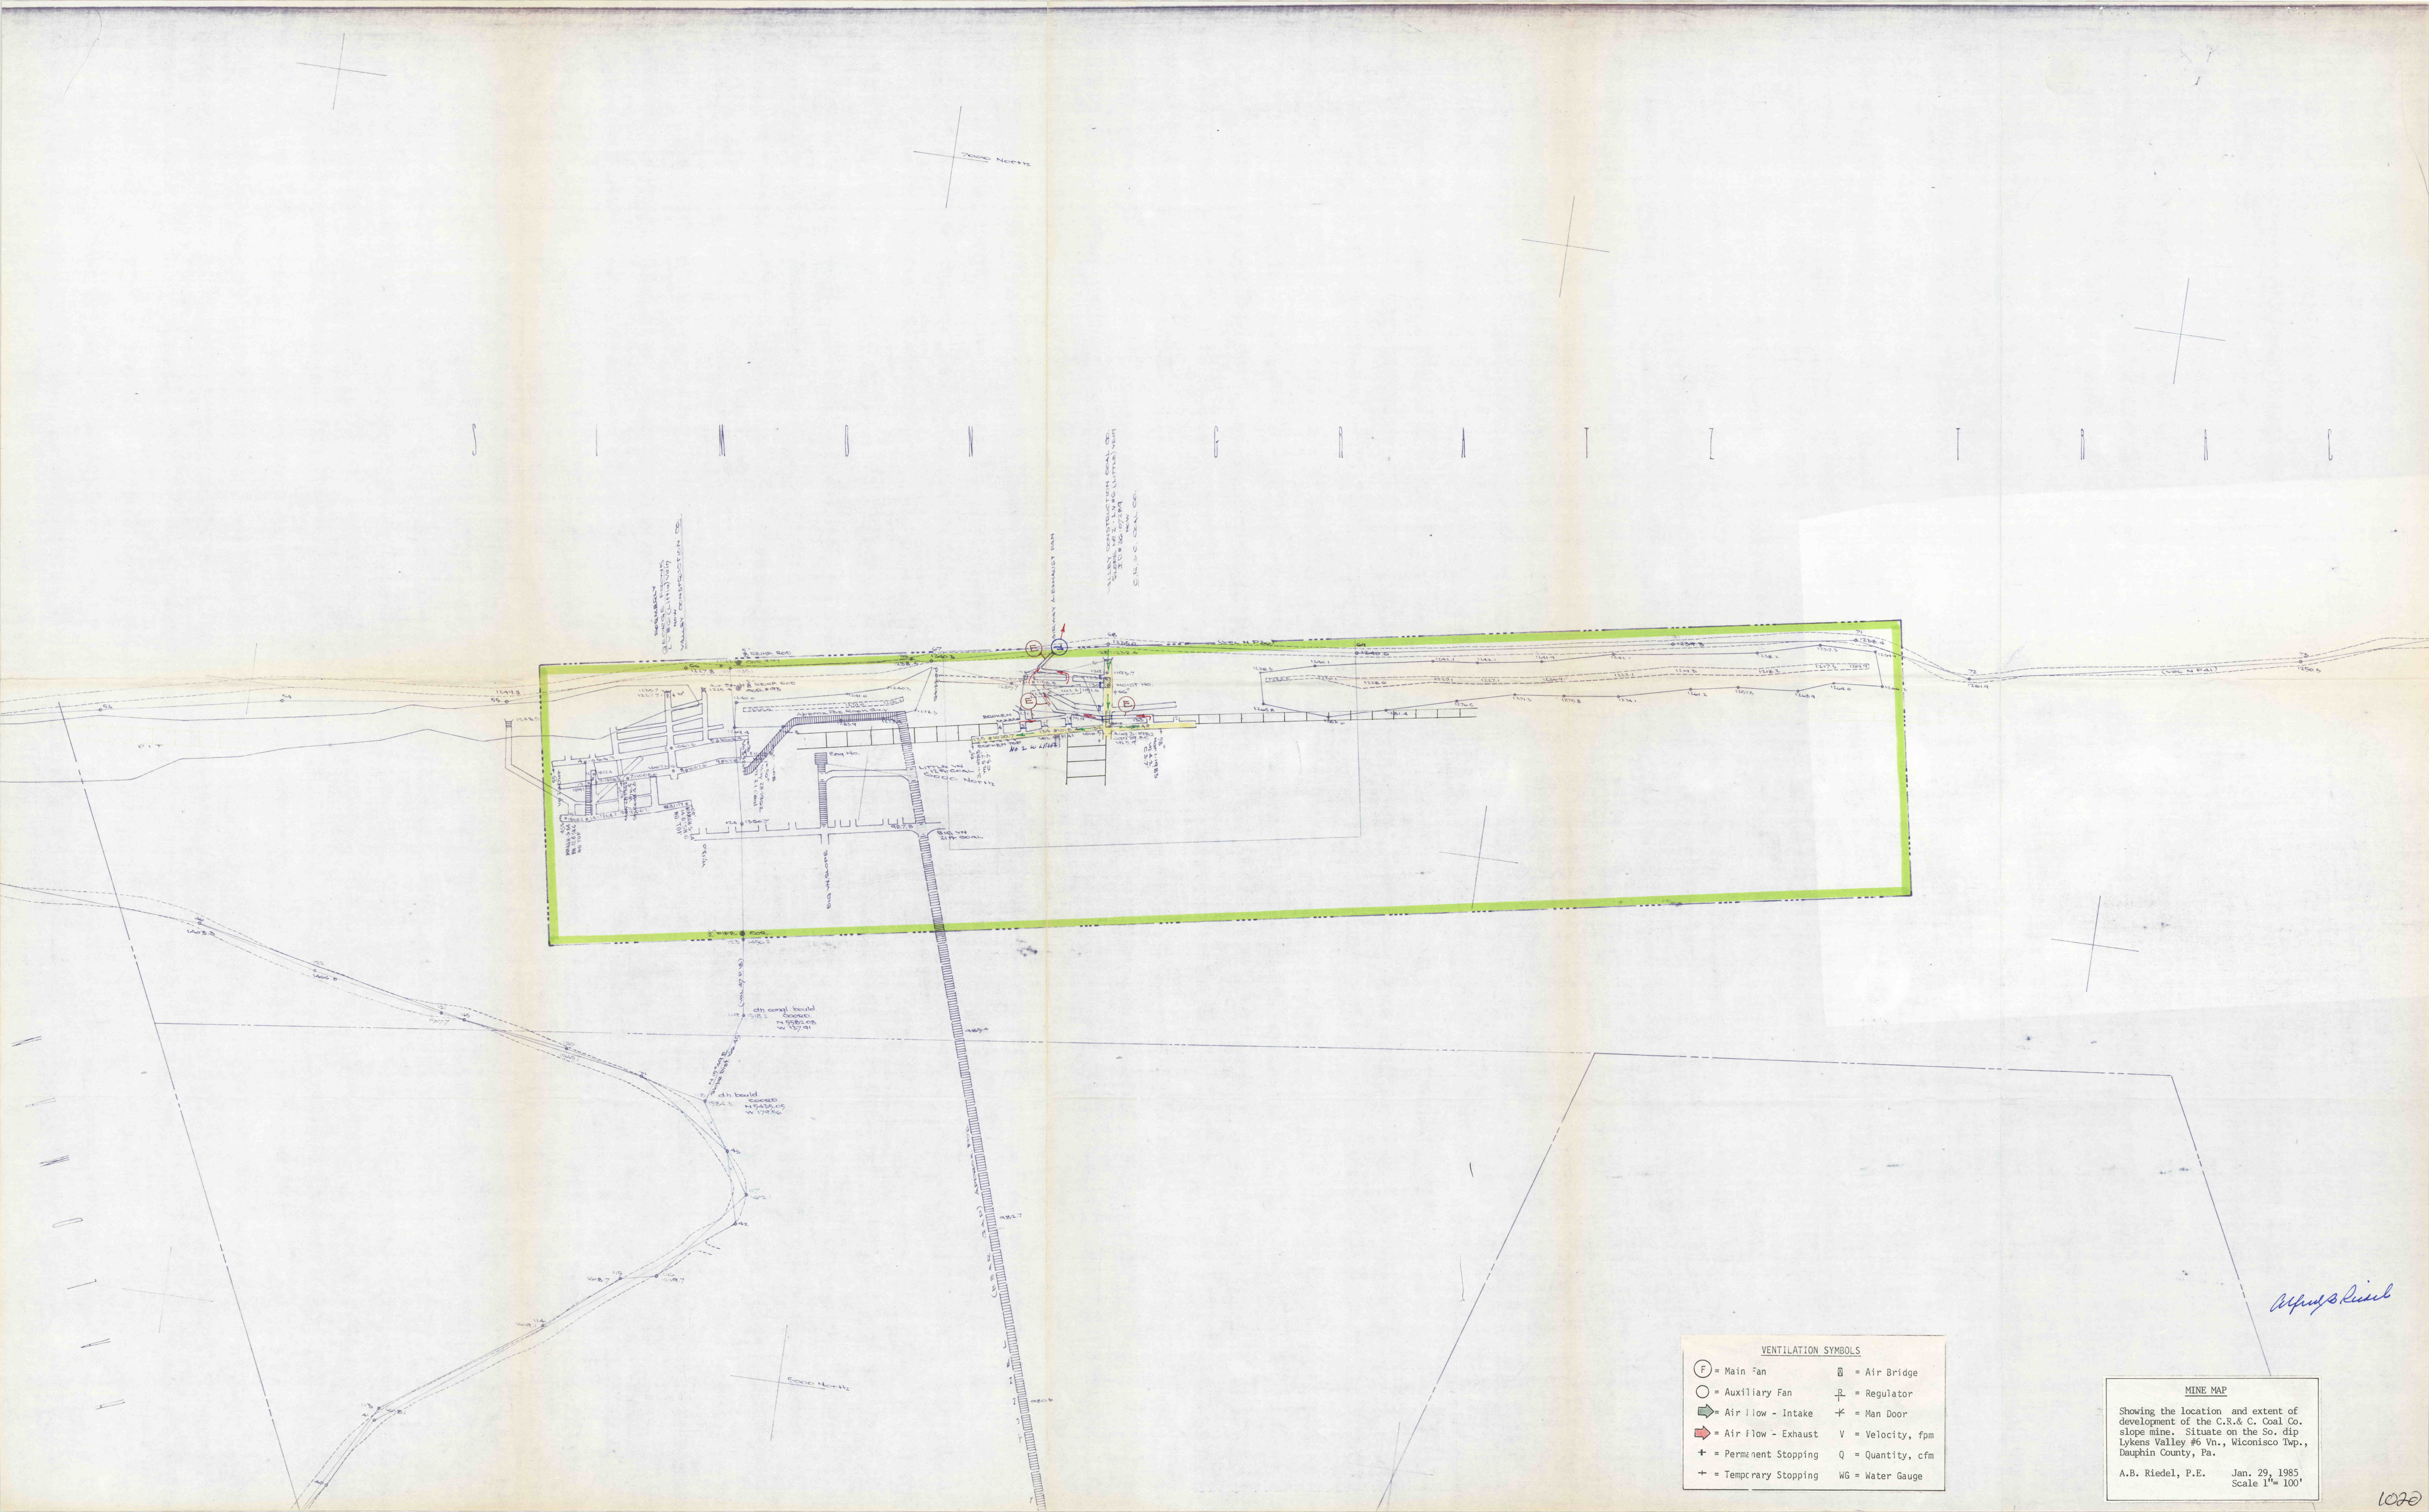

VENTILATION SYMBOLS			
⊙ = Main Fan	⊠ = Air Bridge	⊕ = Regulator	
○ = Auxiliary Fan	⊕ = Man Door		
→ = Air Flow - Intake	V = Velocity, fpm		
→ = Air Flow - Exhaust	Q = Quantity, cfm		
+ = Permanent Stopping	WG = Water Gauge		
⊕ = Temporary Stopping			

MINE MAP
Showing the location and extent of development of the C.R. & C. Coal Co. slope mine. Situate on the So. dip Lykens Valley #6 Vn., Wiconisco Twp., Dauphin County, Pa.
A.B. Riedel, P.E. Jan. 29, 1985
Scale 1" = 100'

Alfred Riedel