


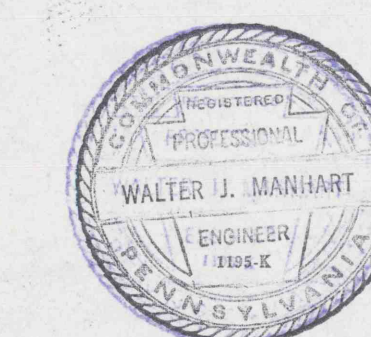

Walter J. Myerhan

X MINE MAP
BLTYHE TWP. SCH. CO. PA.
SHOWING GORENTY TUNNELING CO MINE
SURVEYED OCT. 16 1882 SCALE 1"=100'
