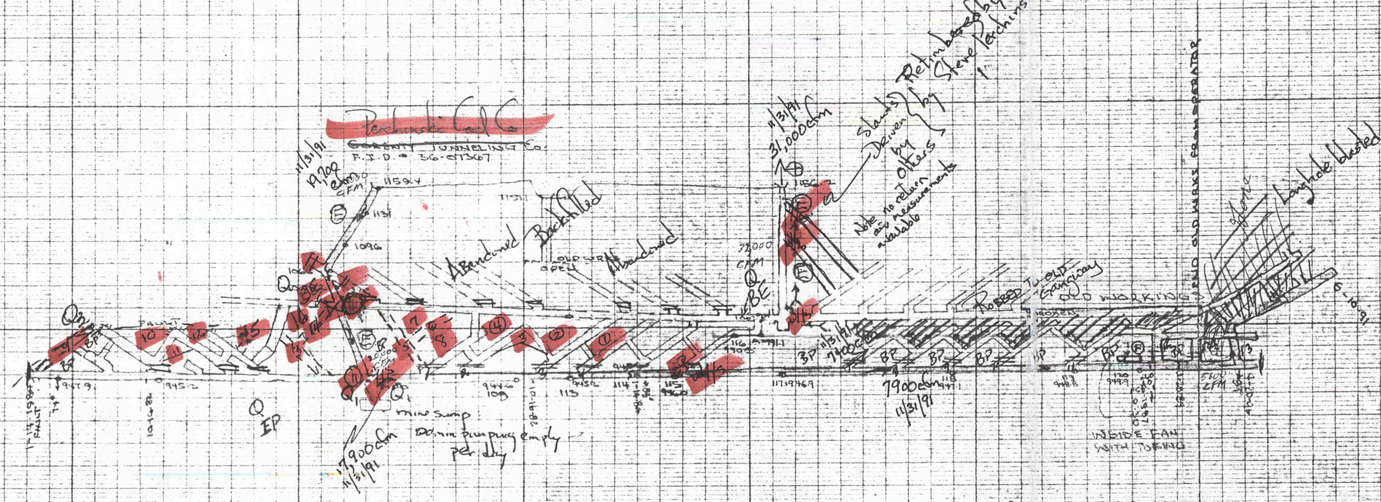

LEGEND

- INTAKE AIR
- RETURN AIR
- TEMP. STOPPING
- PERMANENT STOPPING
- SURFACE FAN
- INSIDE FAN
- REGULATOR
- ESCAPE WAY
- FAN

[X] Proposed Overcast

w/s Hardened Batten Seal — Proposed

R Proposed Regulator / Partial Batten

BP Barrier Pillar left in

BE BLEEDER EVALUATION point

$Q_{BE} = Q_1 = Q_{entering\ pillar\ side} + Q_{3\ at\ high\ point}$

DATUM 500

no abandoned mines or workable veins above or below for 1000' of mine

Updated by Hand notations with mining projection for remainder of mine life

Stephen Perchinski
11-4-91

Walter J. Mechenbach

CROSS SECTION
BLYTHE TWP, SCH. CO. PA.
SHOWING ~~GORSUCH TUNNELING CO.~~ Perchinski Coal Company
SCALE 1" = 100'
LOOKING NORTH
POSTED JUNE 6, 1988
POSTED MARCH 28, 1989
POSTED APRIL 20, 1990
POSTED JUNE 10, 1991
Updated November 4, 1991

023B