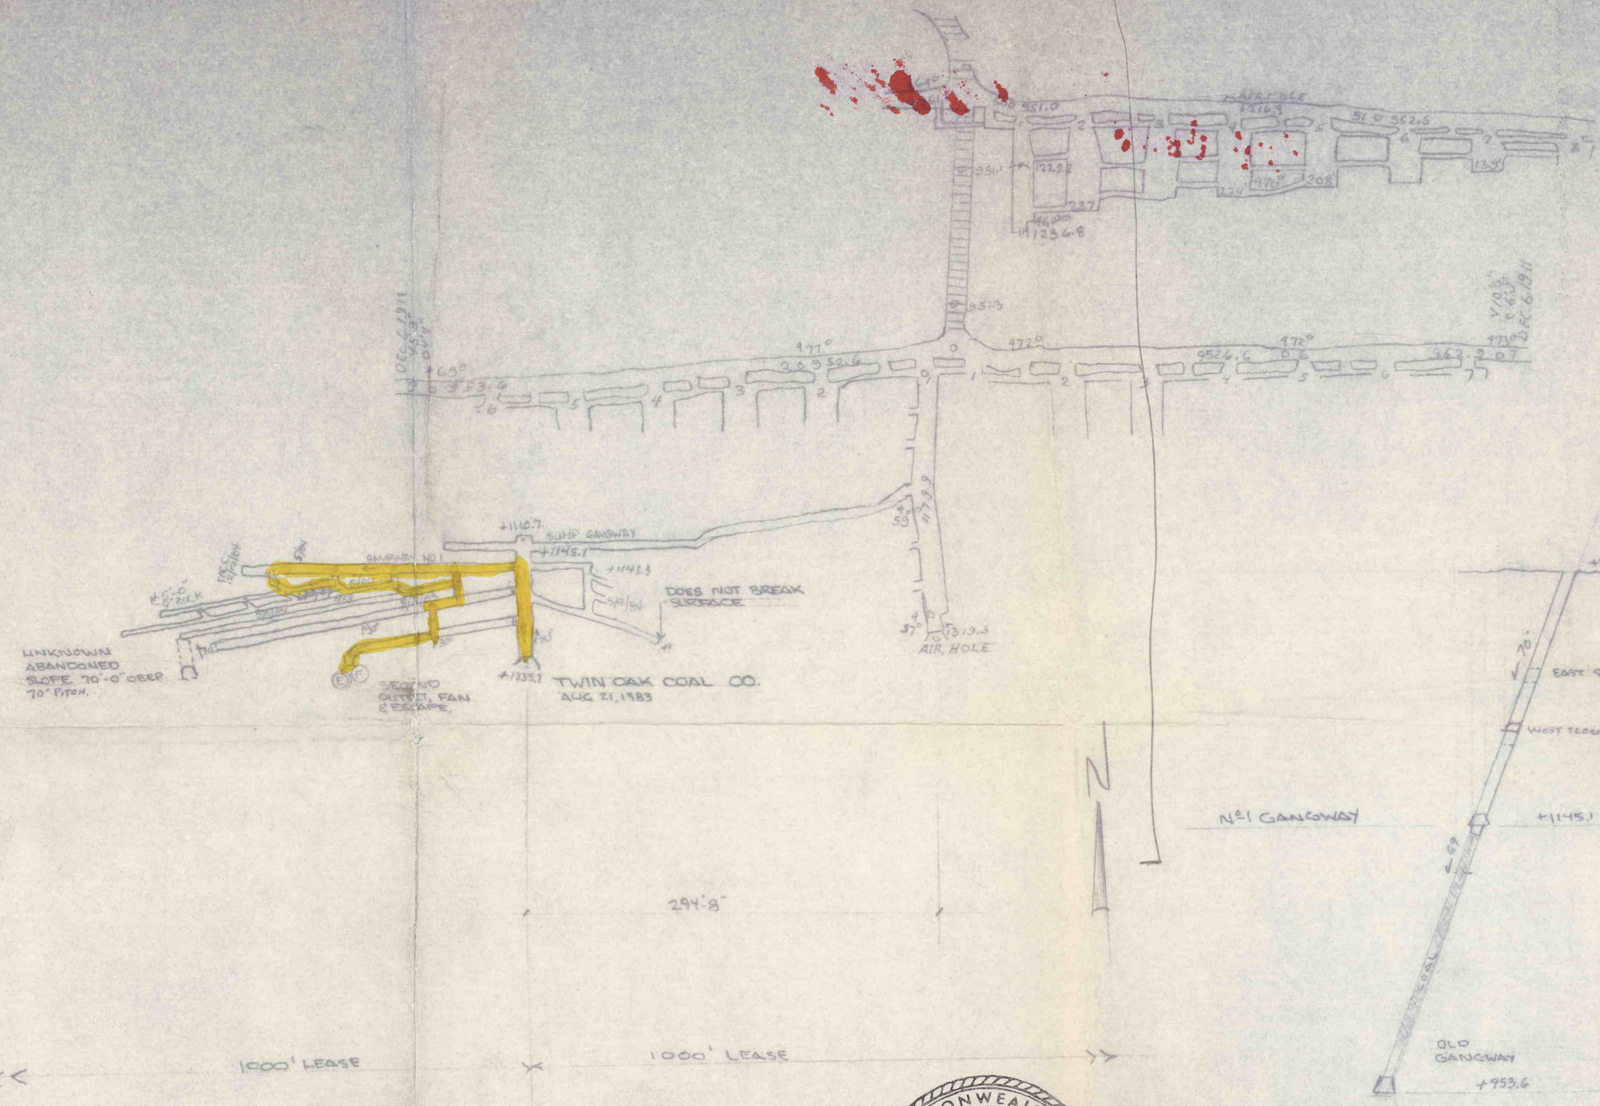

COMMONWEALTH OF PENNSYLVANIA
REGISTERED PROFESSIONAL ENGINEER
BARRY E. TRUMBAUER
NO. 23835-E

MAR 1 1989

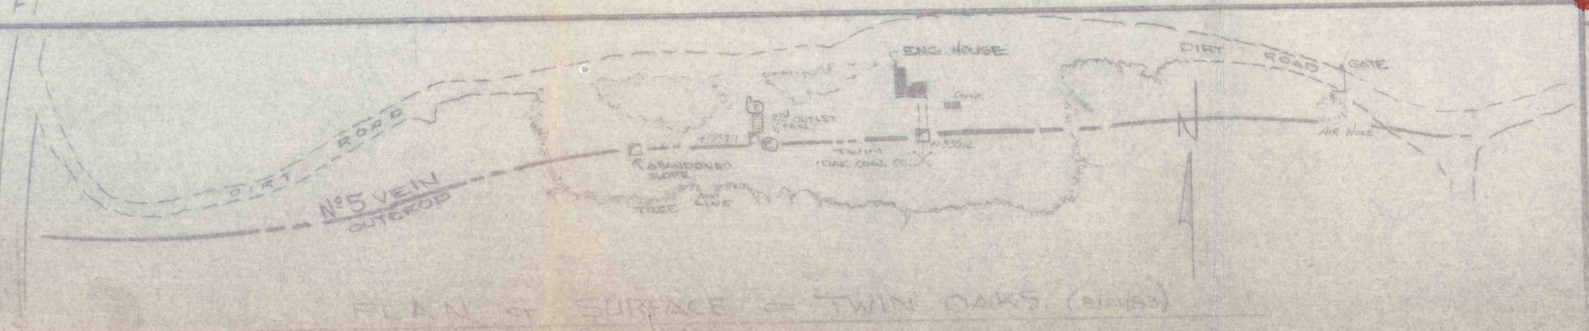

PLAN OF SURFACE OF TWIN OAKS (SLOPE)

TWIN OAK COAL CO. ID 36-07388
EAST CAMERON
NORTH'D COUNTY PA
5 VEIN

SCALE 1"=100-0"

LEGEND

AIR SUPPLY
AIR RETURN
STAIRWAY OPENING
ESCAPE
TEMPORARY STOPPING

1029