


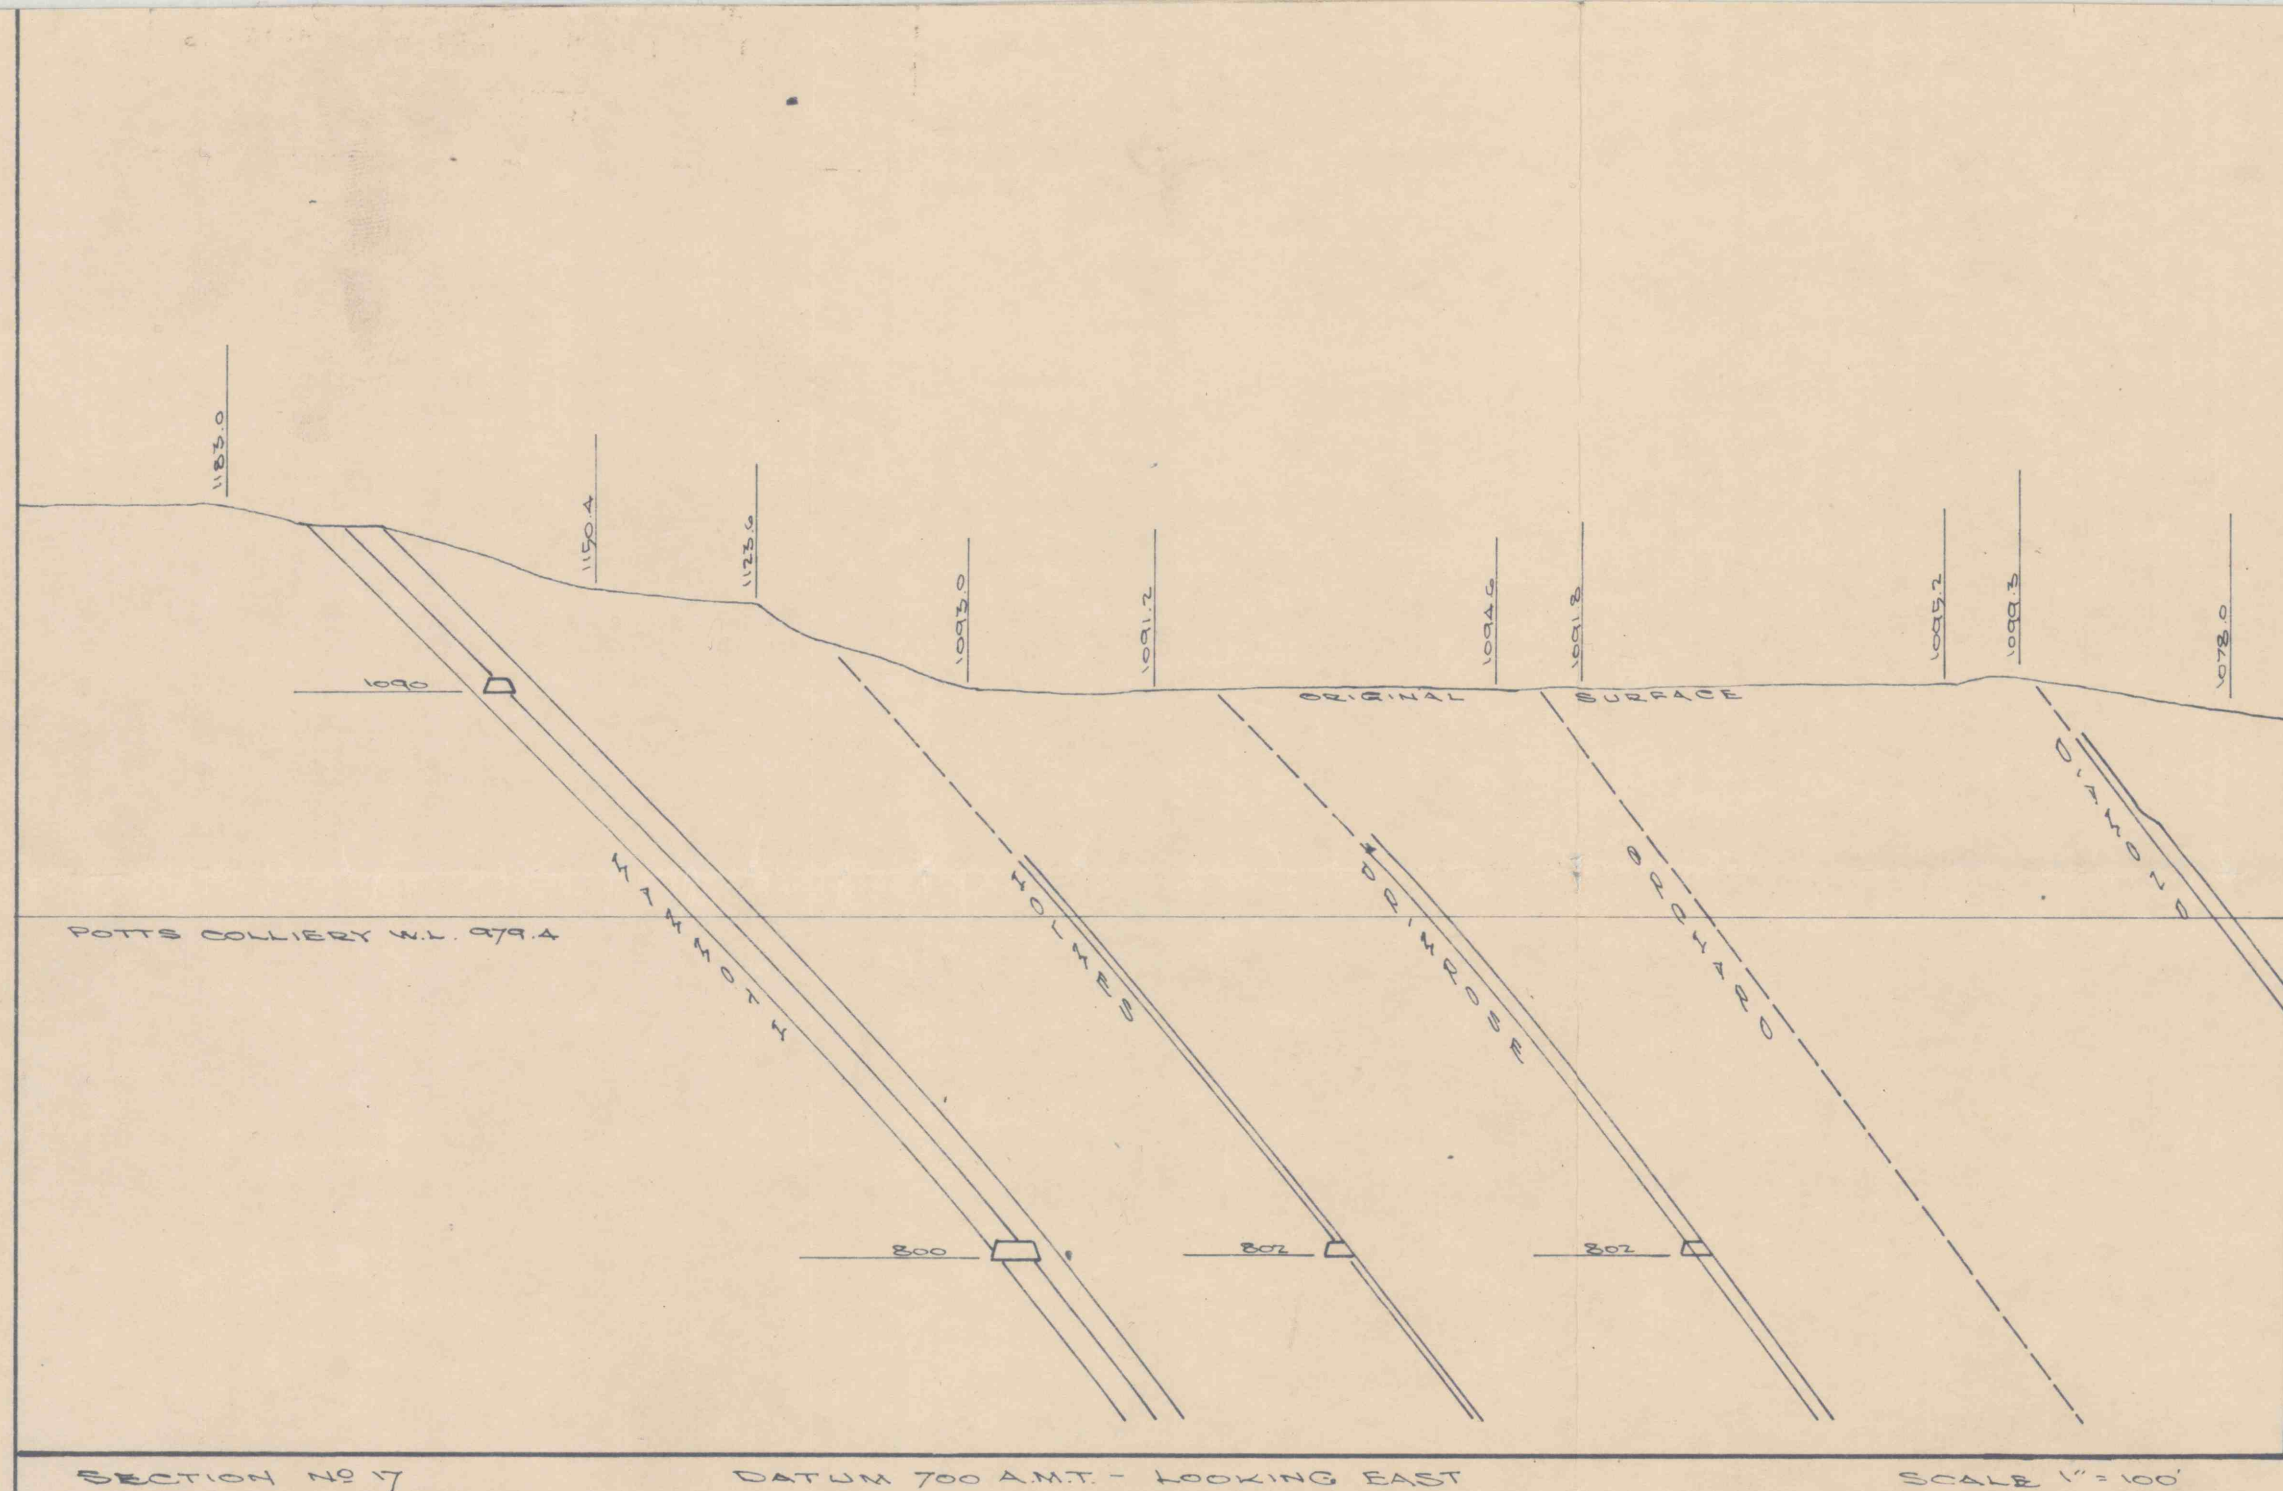

MINE MAP

Showing the location and extent of development as reported by the Pewor Coal Company. Situate on the So. dip Holmes Vn., Conyngham Twp., Columbia County, Pa.

A.B. Riedel, P.E. Feb. 2, 1976  
Scale 1"=100'

*As per B. Riedel*