


JACOB KNOLL TRACT

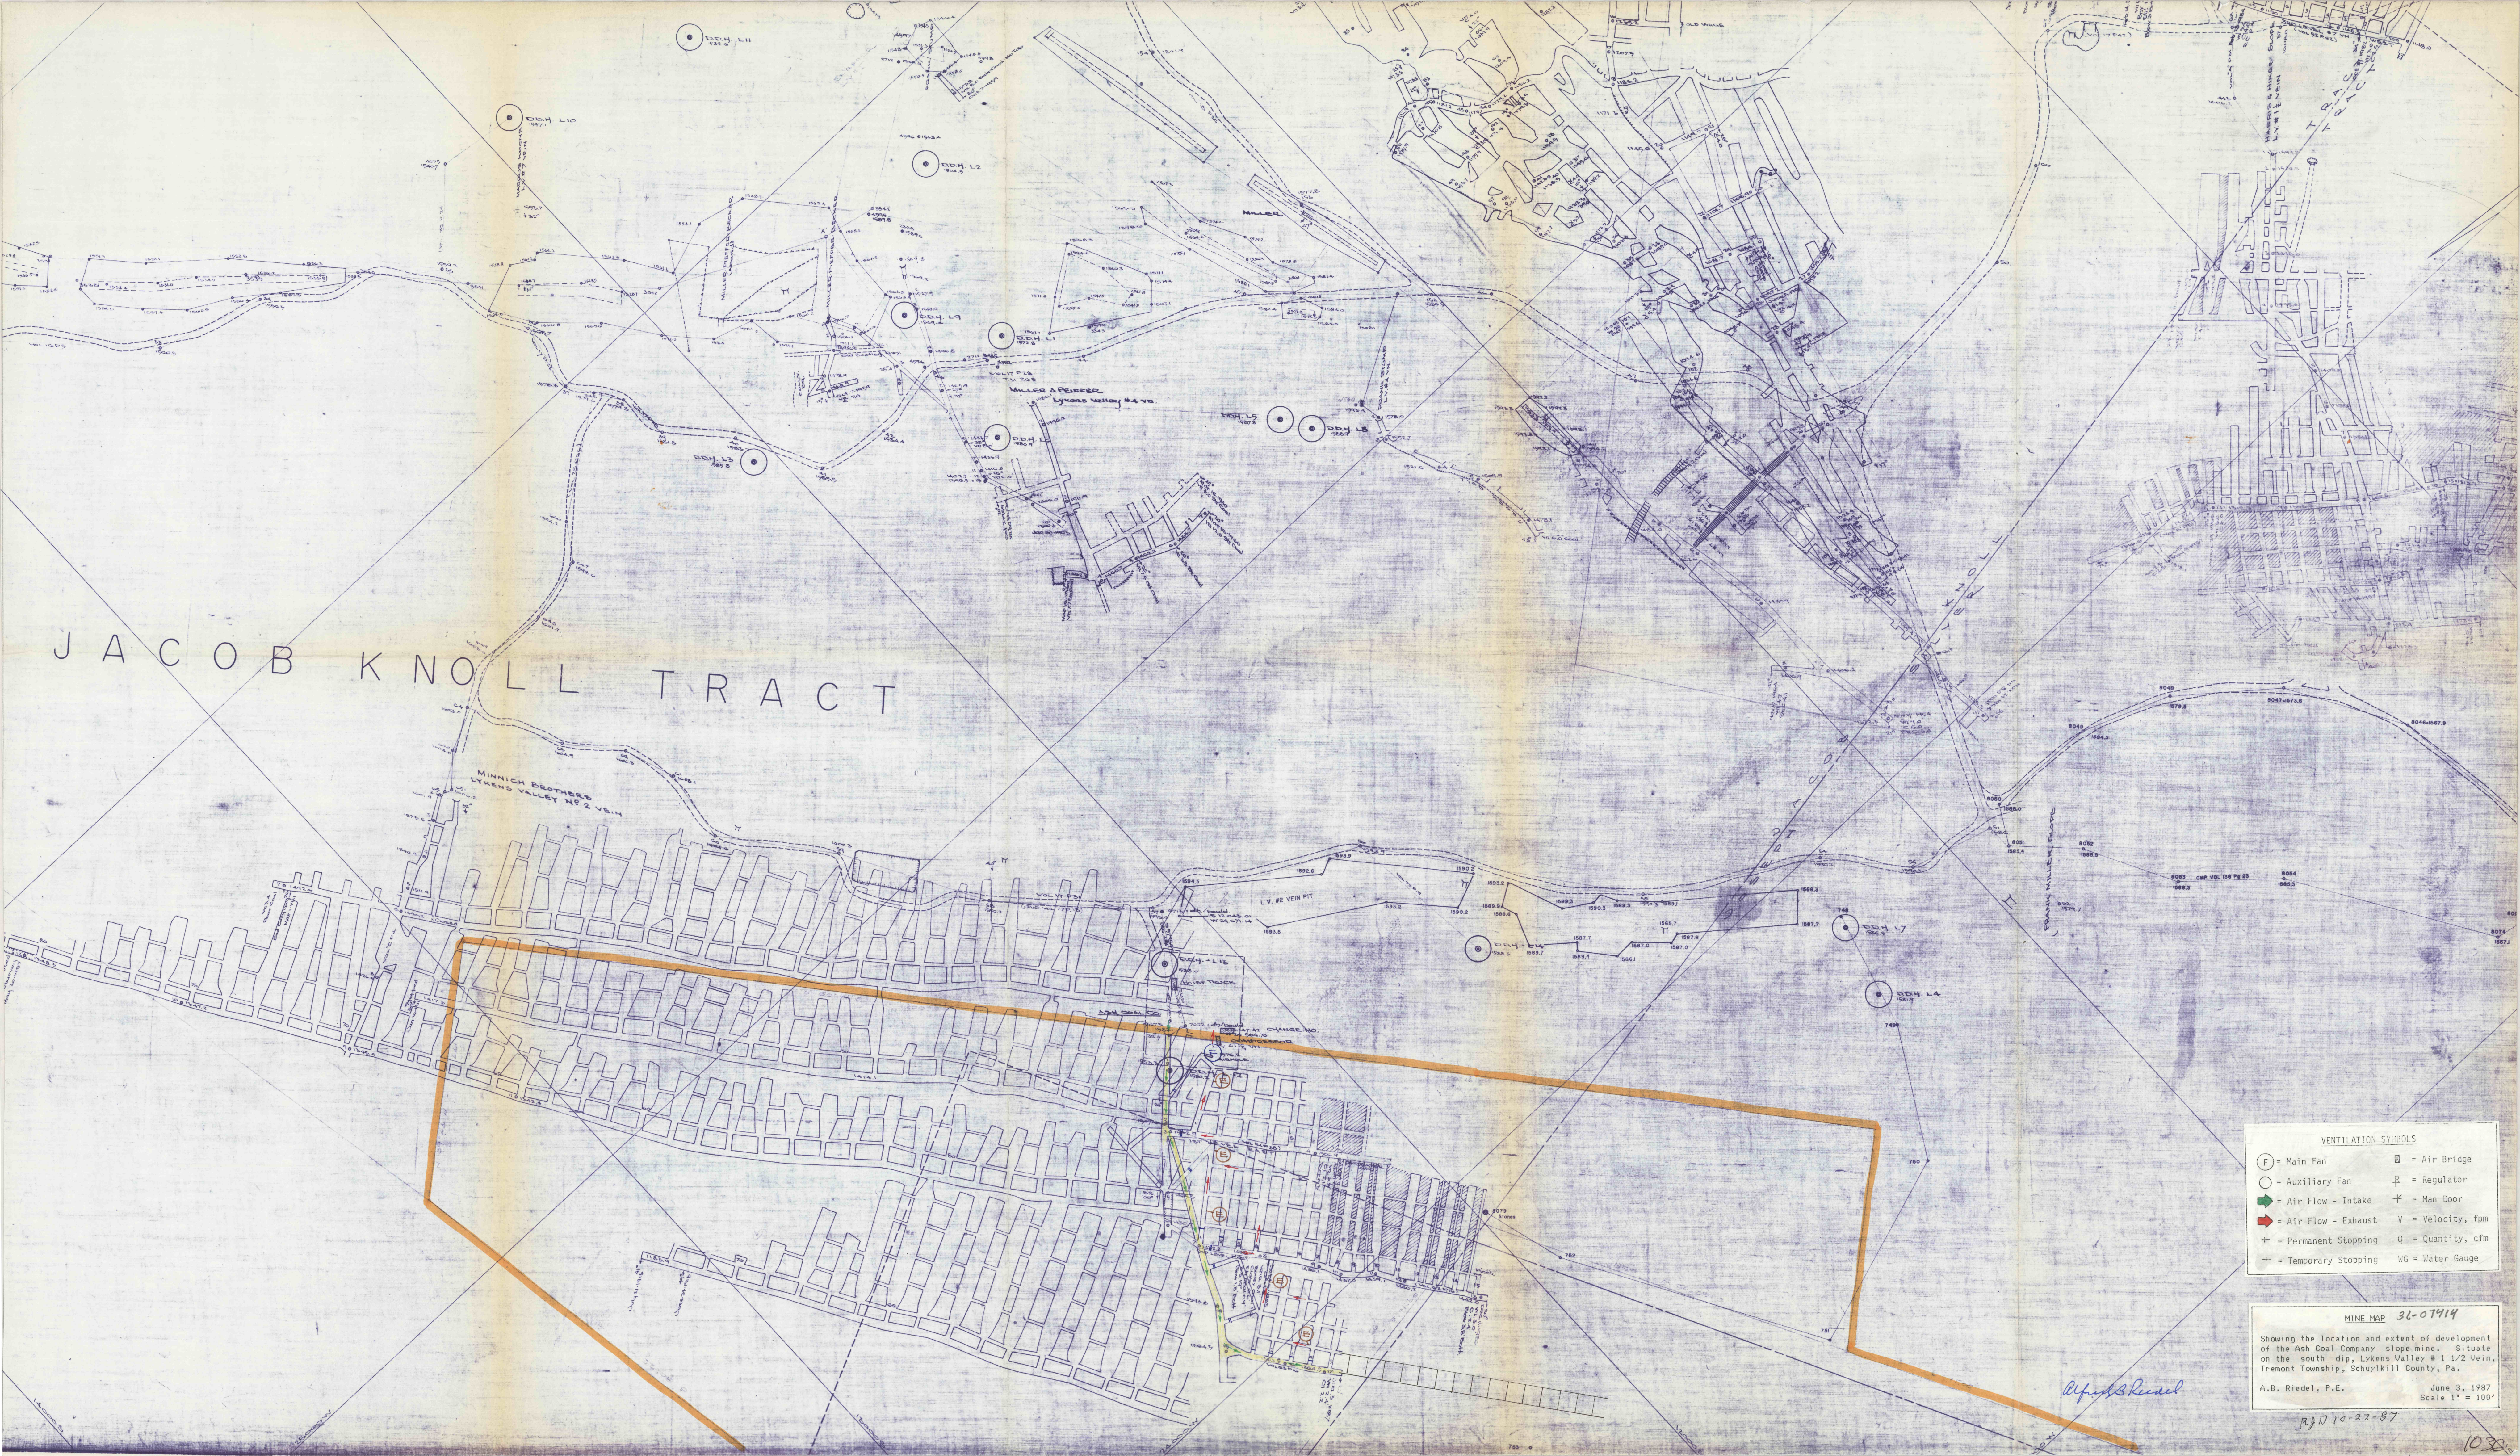

VENTILATION SYMBOLS	
⊙ = Main Fan	⊞ = Air Bridge
○ = Auxiliary Fan	⊞ = Regulator
➔ = Air Flow - Intake	⊞ = Man Door
➔ = Air Flow - Exhaust	V = Velocity, fpm
⊞ = Permanent Stopping	Q = Quantity, cfm
⊞ = Temporary Stopping	WG = Water Gauge

MINE MAP 31-07414
 Showing the location and extent of development of the Ash Coal Company slope mine. Situate on the south dip, Lykens Valley #1 1/2 Vein, Tremont Township, Schuylkill County, Pa.
 A.B. Riedel, P.E. June 3, 1987
 Scale 1" = 100'

1030